


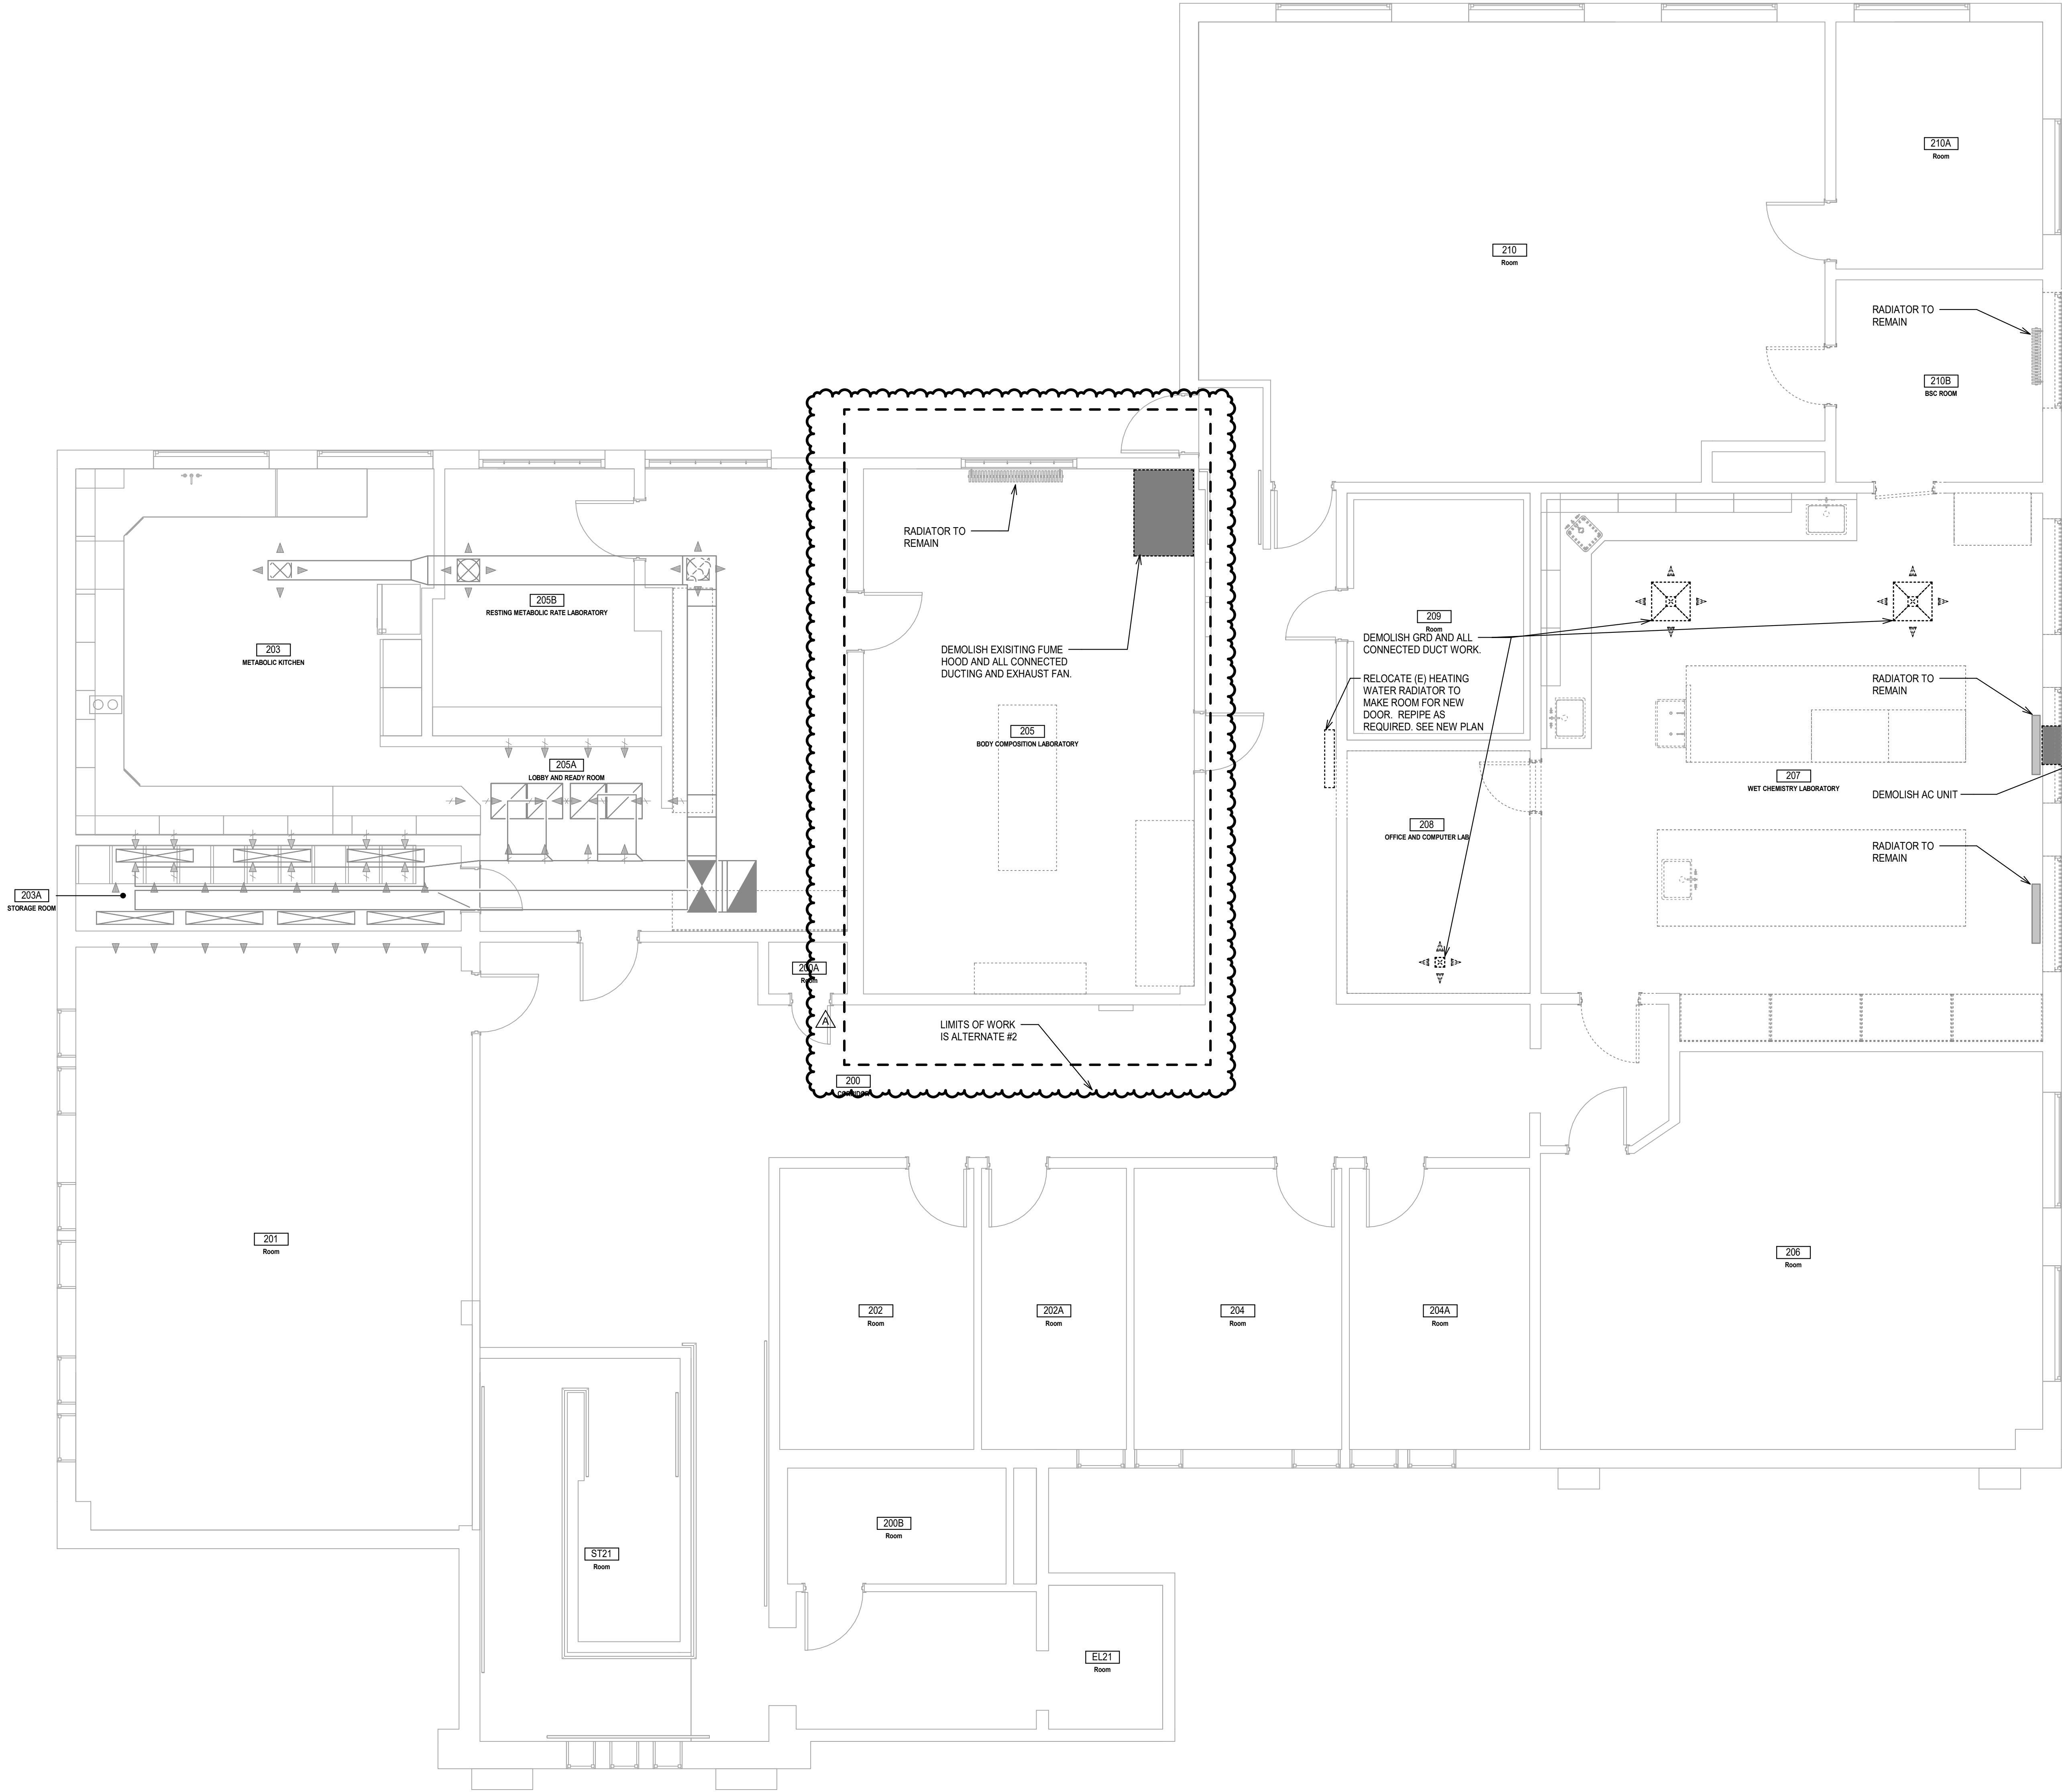


LEVEL 2 - DEMOLITION PLAN - MECHANICAL

1/4" = 1'-0"



ISSUE DATE: 07.21.2025

REV	DATE	COMMENT
A	7/21/2025	Owner Revisions

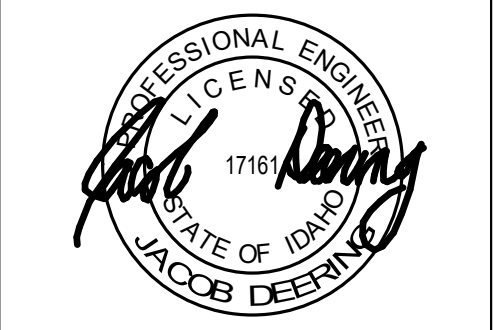

DEMO FLOOR PLAN - MECHANICAL
FOOD RESEARCH CENTER TI - PHASE 1 (BUILDING #: 005)
860 IDAHO AVE, MOSCOW, ID 83844
UNIVERSITY OF IDAHO


TITLE	PROJECT	CLIENT
JOB NO: 240004 CAPITAL PROJECT NO: CP220034		

MD2-11




DEMO ROOF PLAN - MECHANICAL

1/4" = 1'-0"

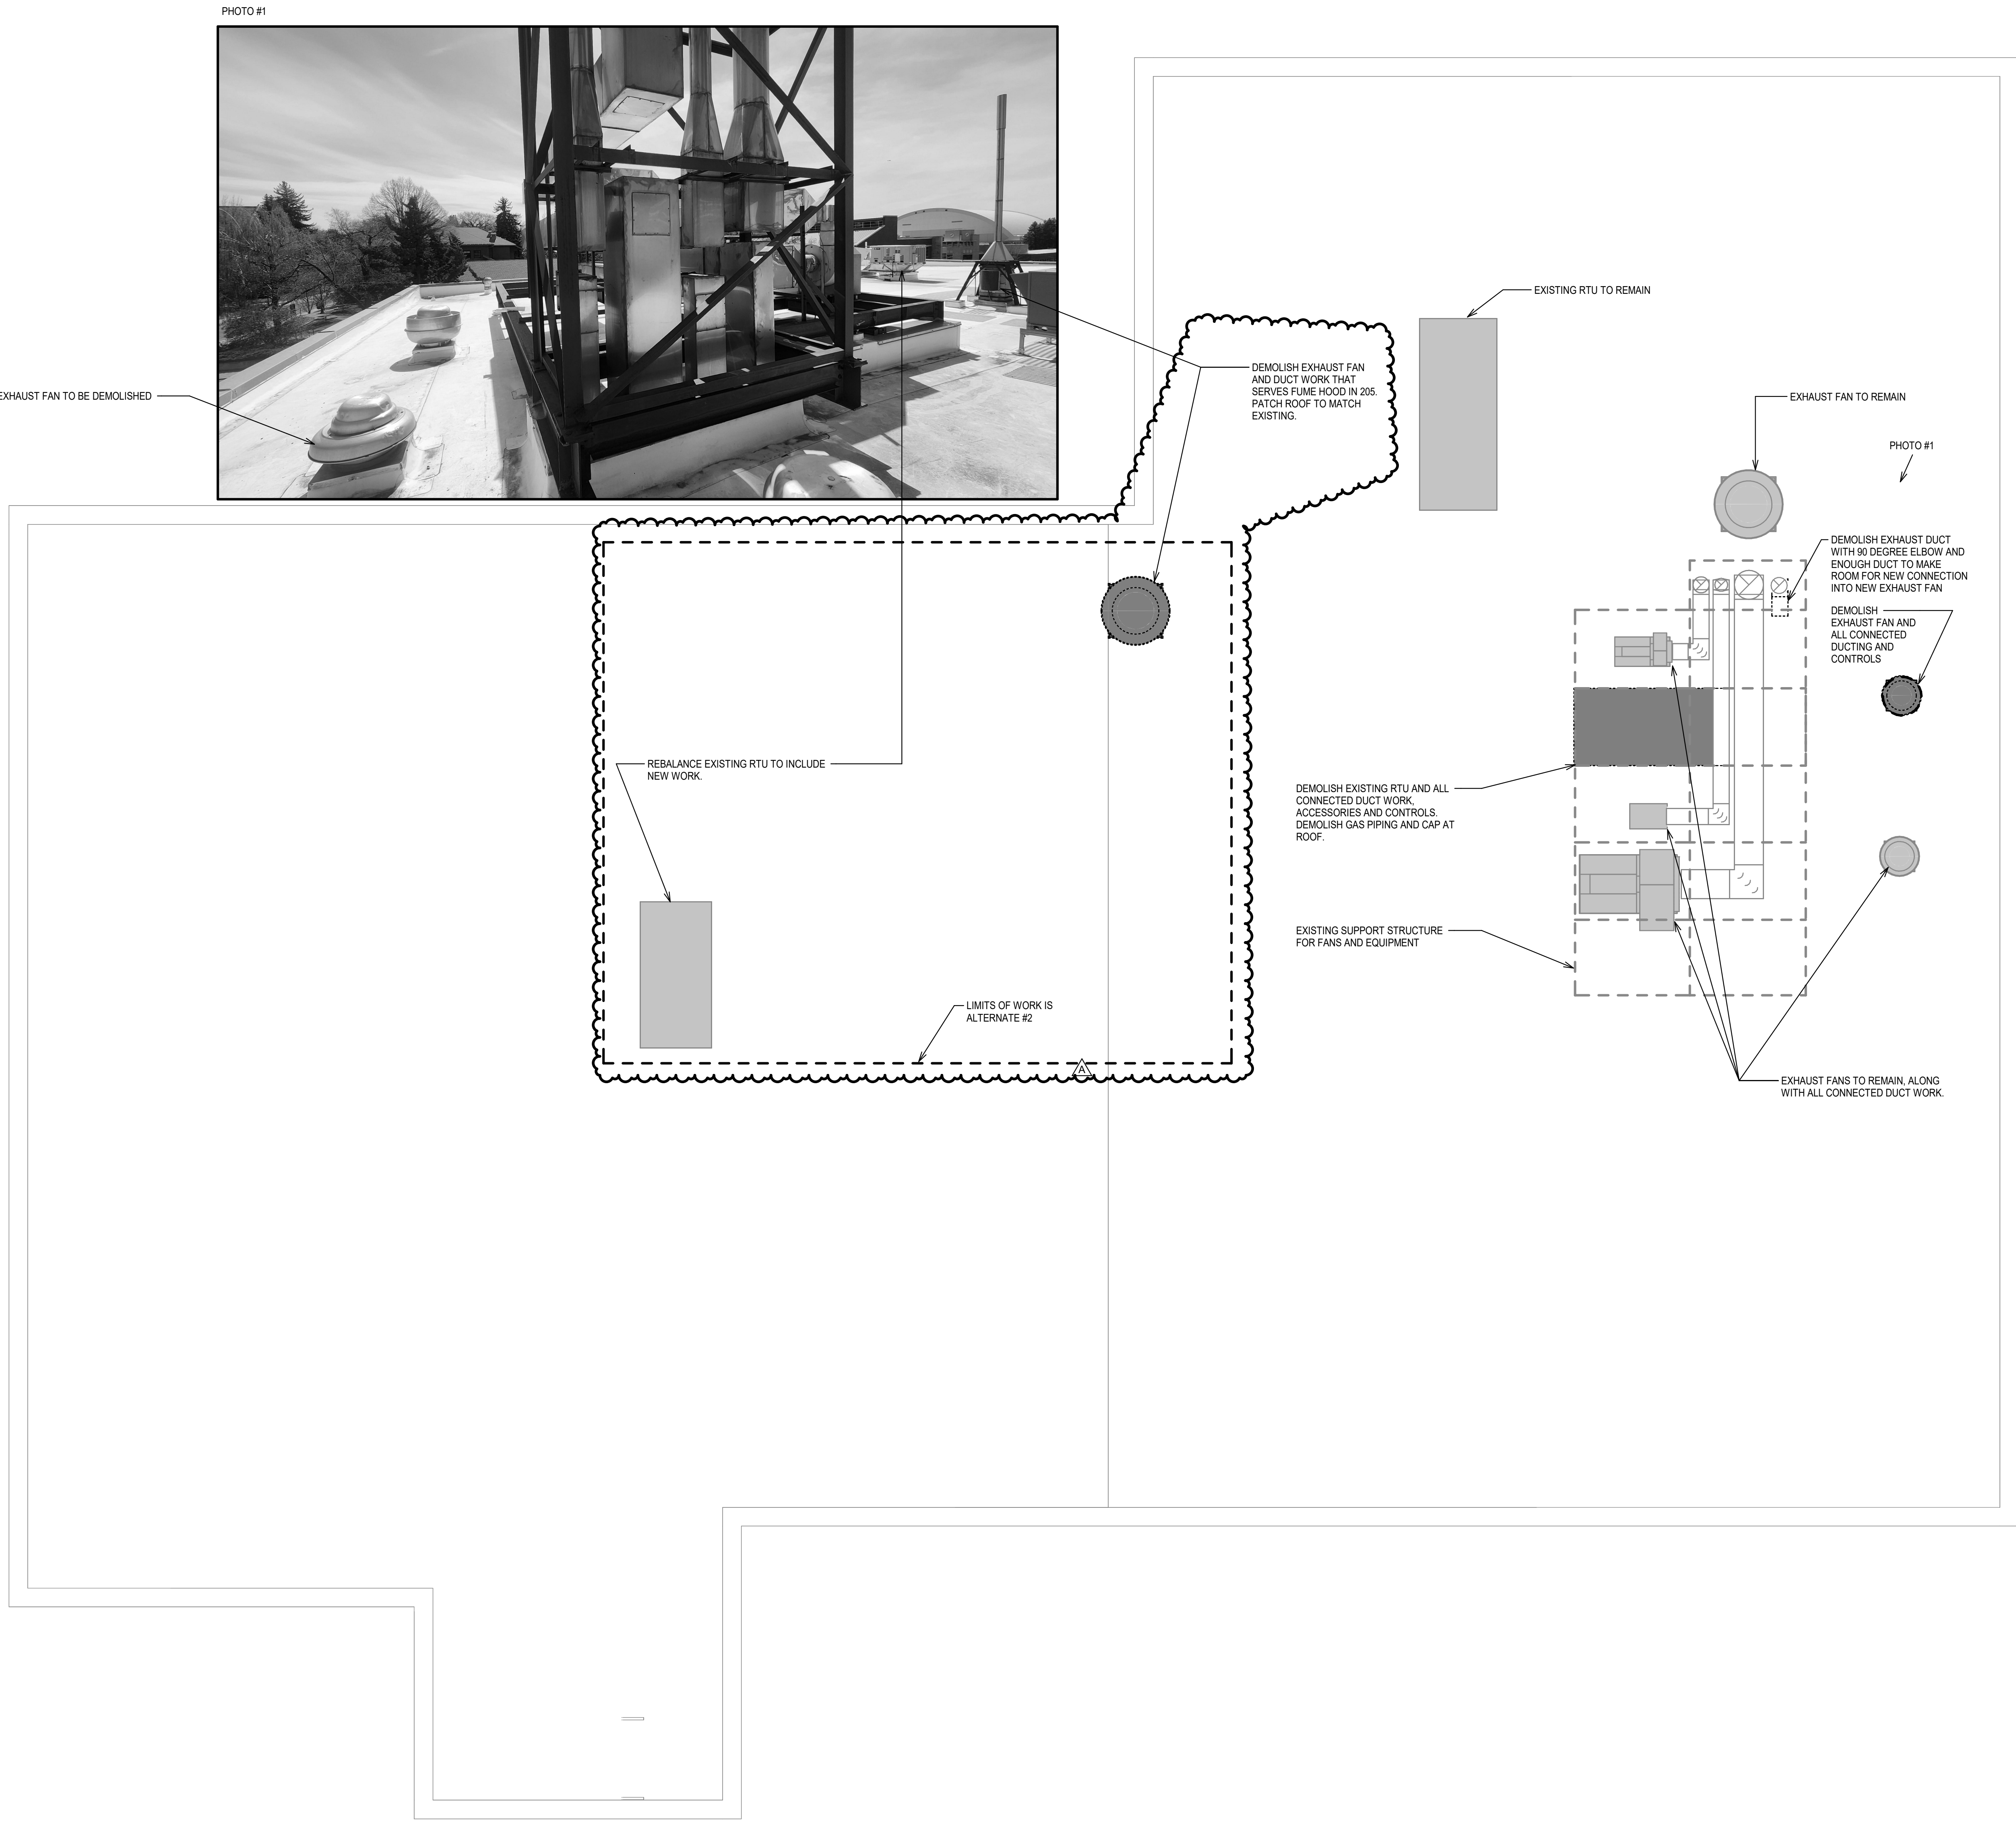

ISSUE DATE: 07.21.2025


REV	DATE	COMMENT
A	7/21/2025	Owner Revisions

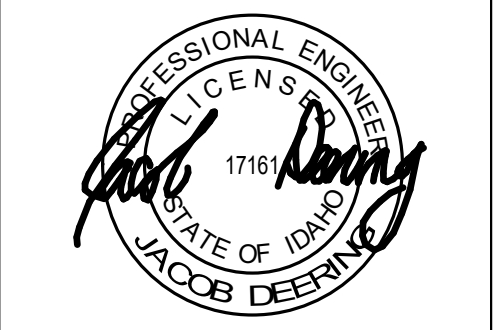


DEMO ROOF PLAN - MECHANICAL	FOOD RESEARCH CENTER TI - PHASE 1 (BUILDING #: 005)
	860 IDAHO AVE, MOSCOW, ID 83844
	UNIVERSITY OF IDAHO

TITLE	PROJECT	CLIENT
	JOB NO: 240004 CAPITAL PROJECT NO: CP220034	

MD2-12

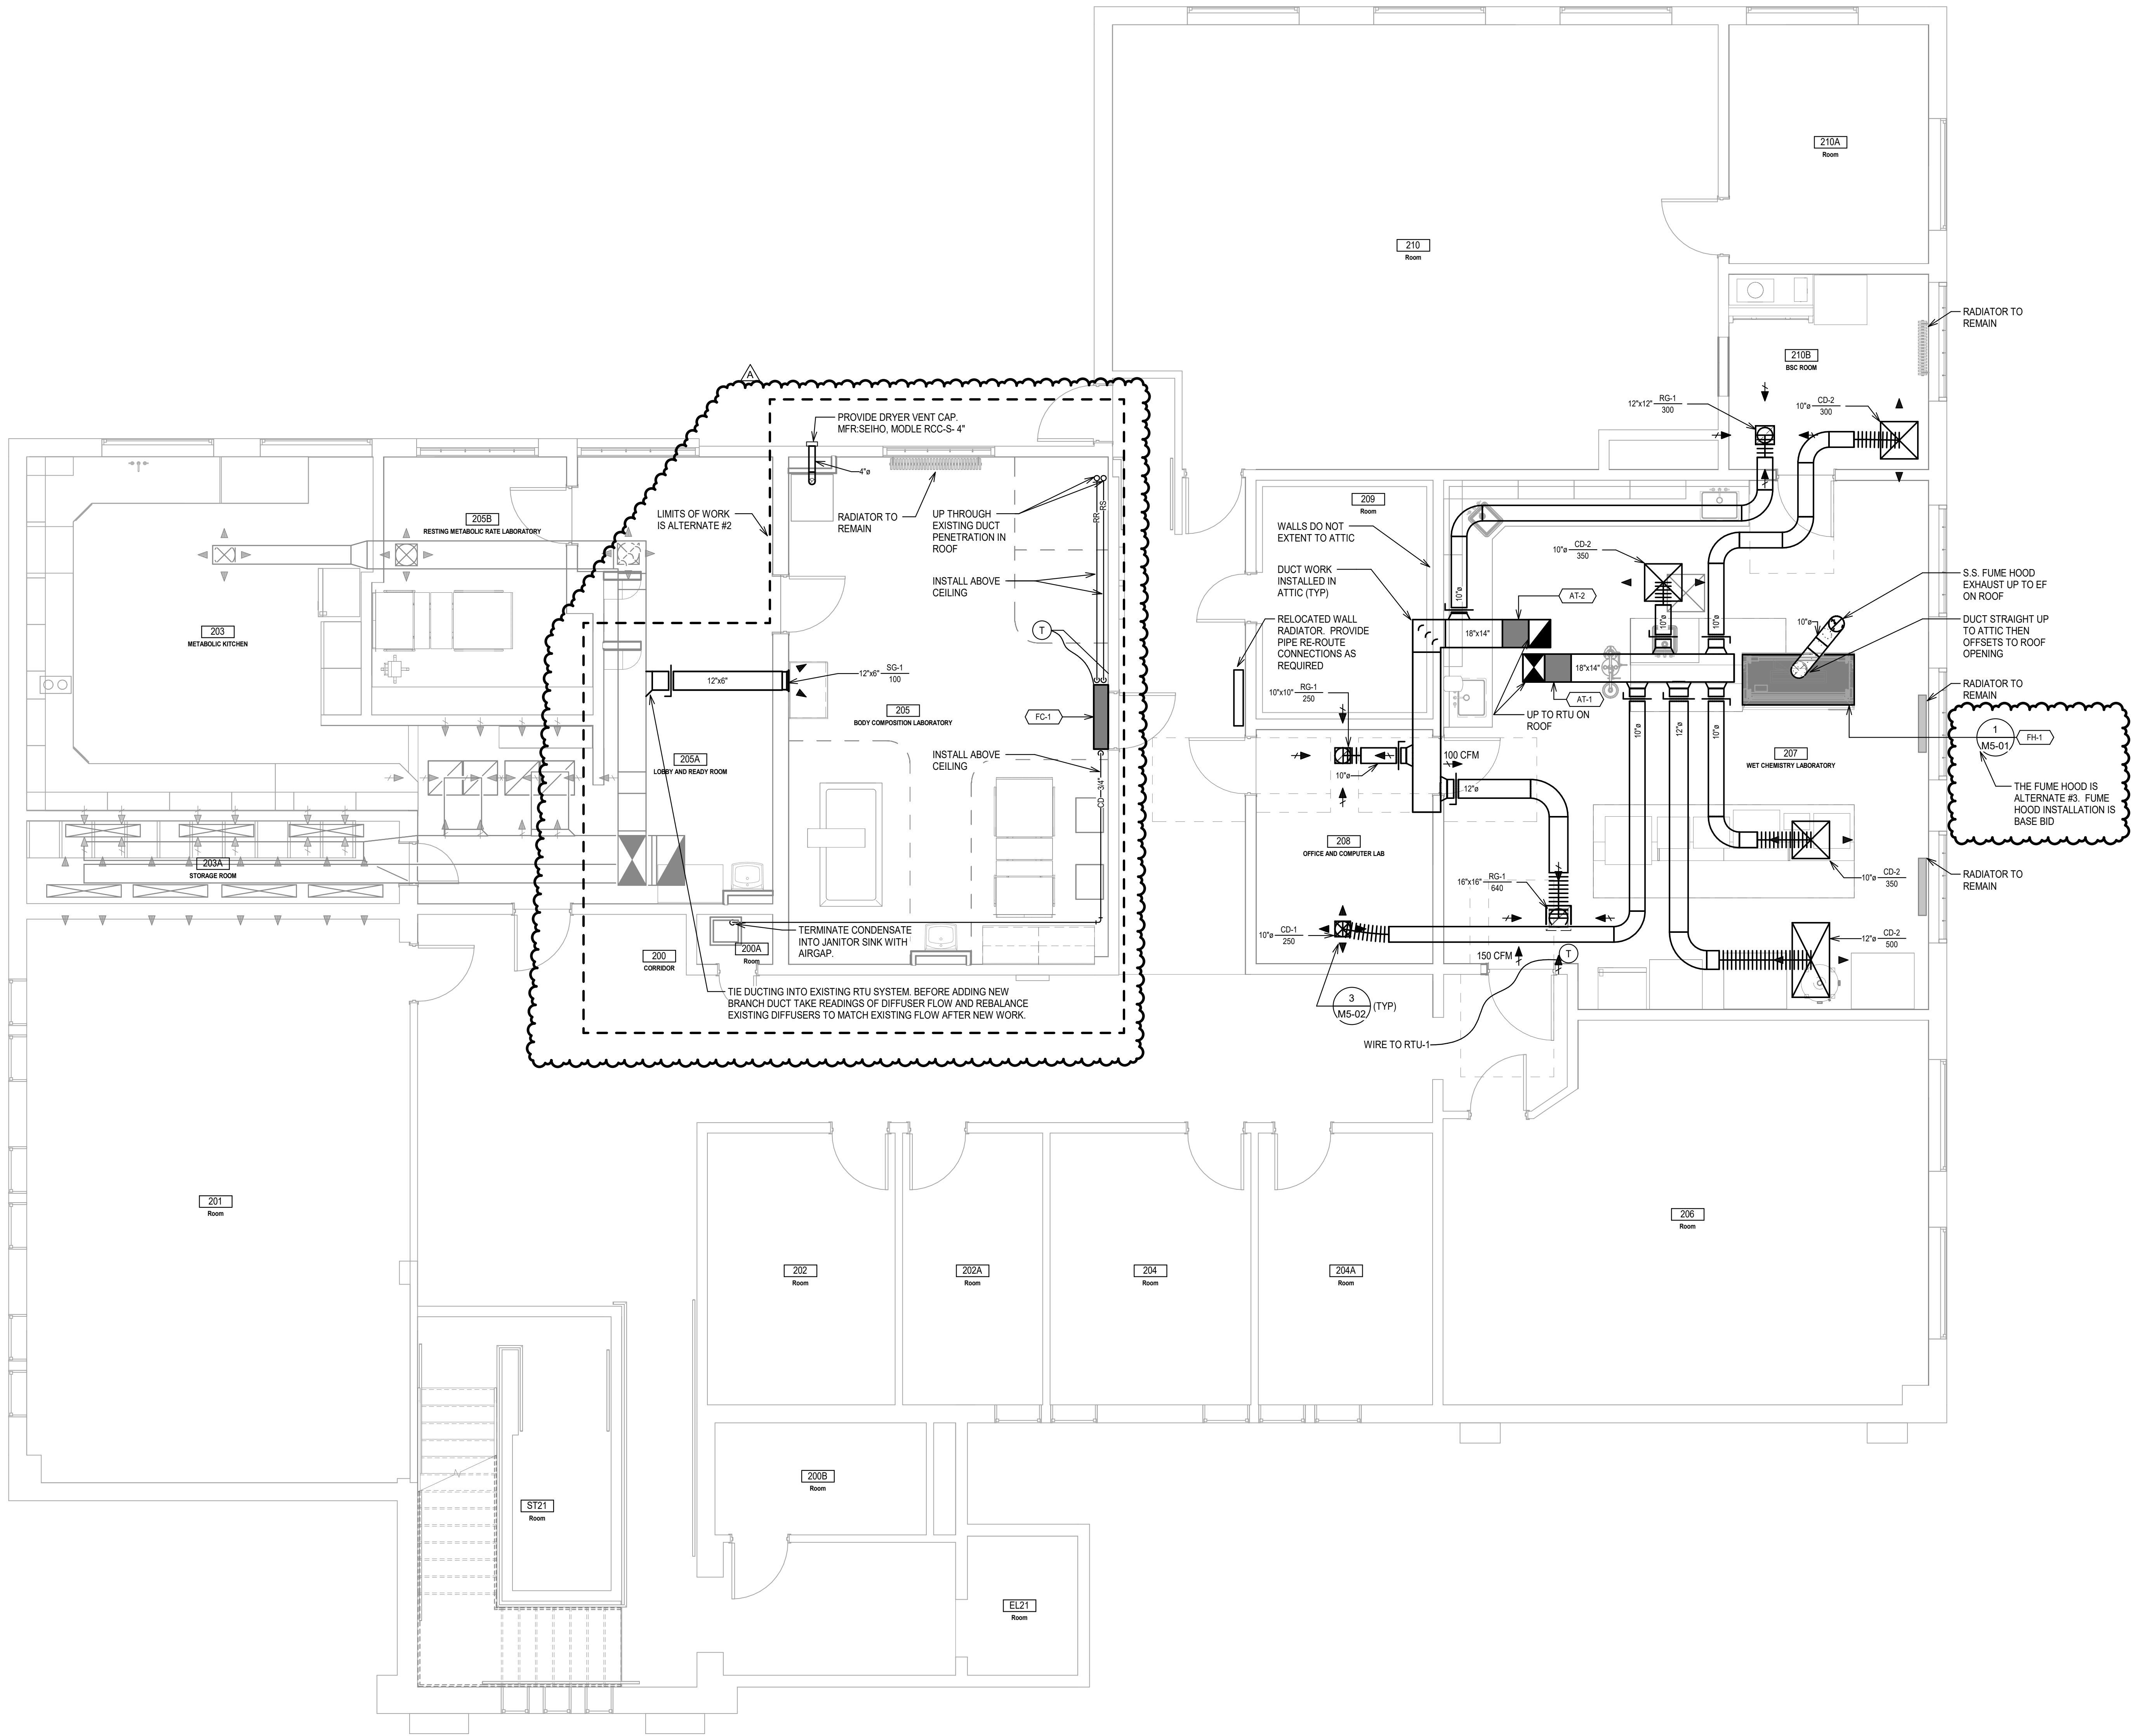

REV	DATE	COMMENT
A	7/21/2025	Owner Revisions

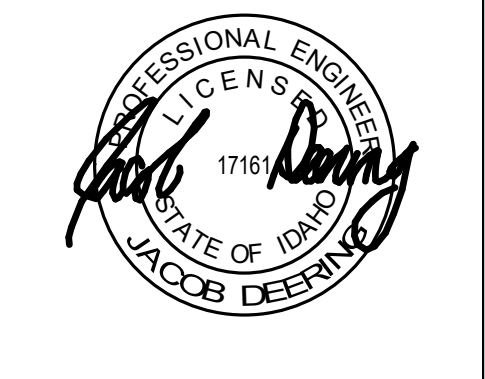

FLOOR PLAN - MECHANICAL
FOOD RESEARCH CENTER TI - PHASE 1 (BUILDING #: 005)
860 IDAHO AVE, MOSCOW, ID 83844
UNIVERSITY OF IDAHO



TITLE	PROJECT	CLIENT
JOB NO: 240004 CAPITAL PROJECT NO: CP220034		

M2-11



ROOF PLAN - MECHANICAL

1/4" = 1'-0"

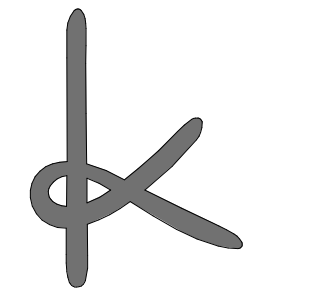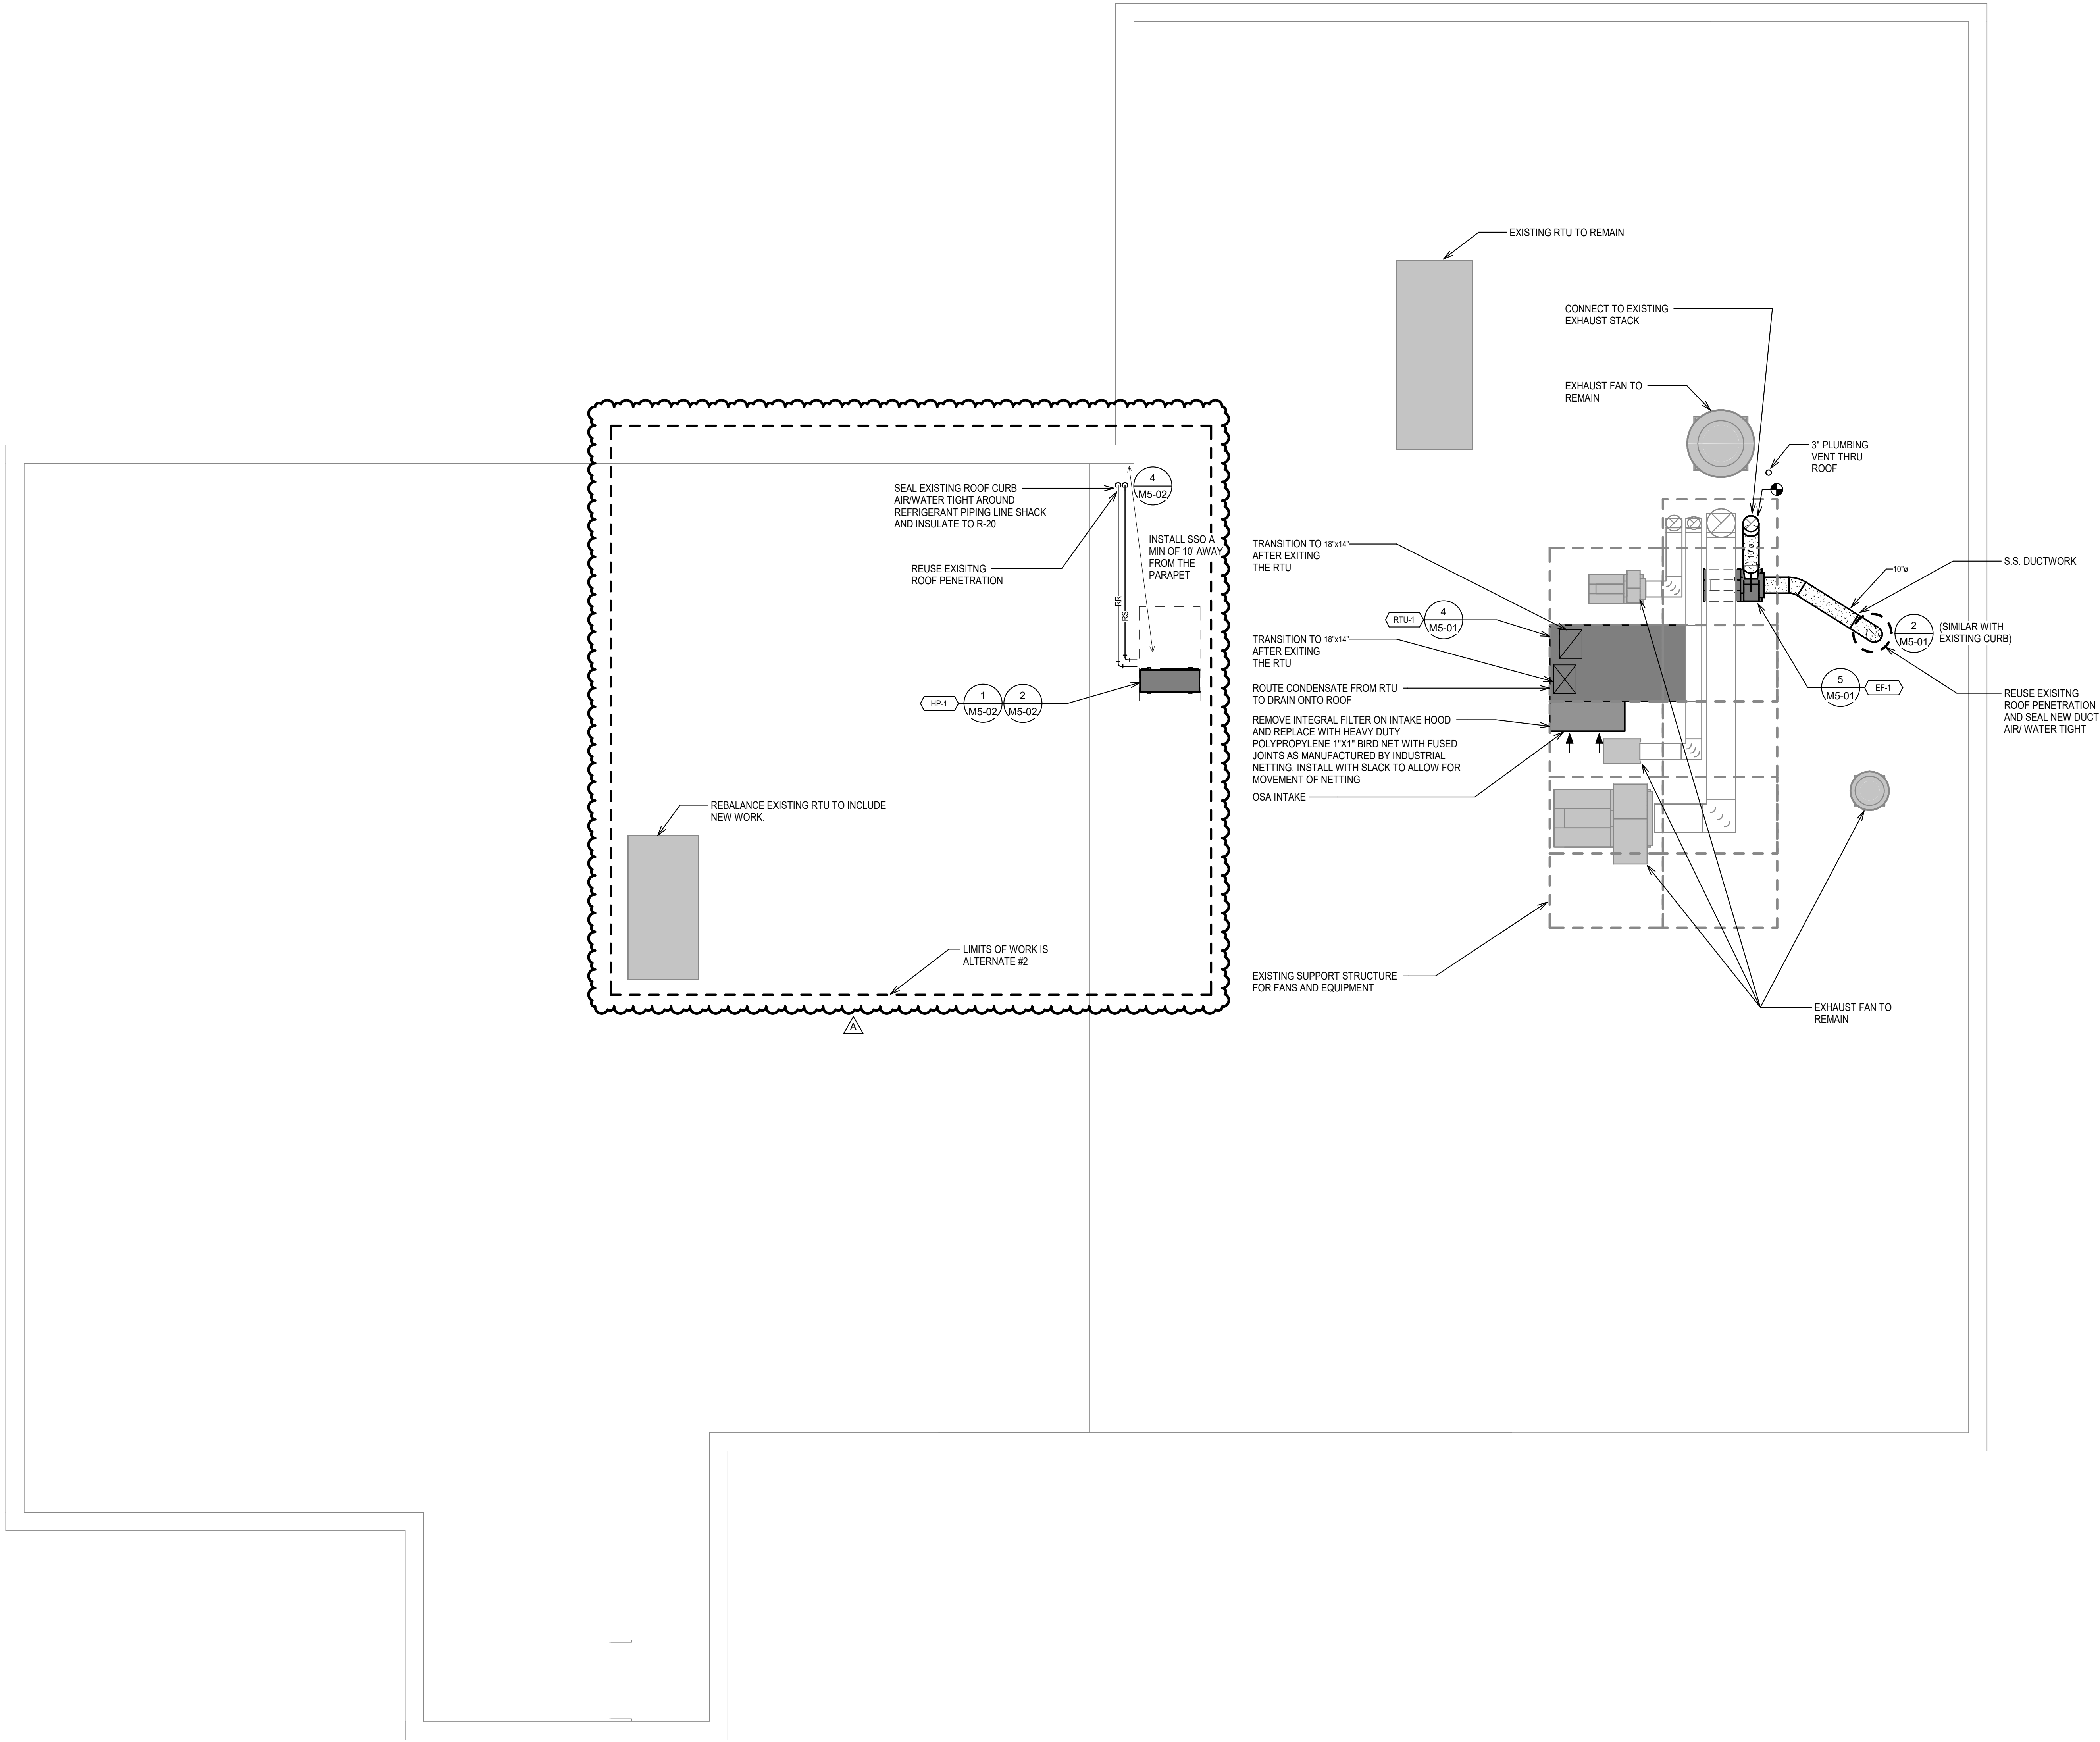


KNIT

knitstudios.com
THESE DOCUMENTS HAVE BEEN PRODUCED AS AN INSTRUMENT OF SERVICE AND ARE INTENDED SOLELY FOR THE PURPOSE OF CONSTRUCTING, USING AND MAINTAINING THE PROJECT. KNIT AS THE ARCHITECT OF RECORD FOR THE PROJECT RETAINS OWNERSHIP OF THESE DOCUMENTS.
ANY USE OF THESE DOCUMENTS OR USE OF THE DESIGN IDEAS OR CONCEPTS DESCRIBED HEREIN IN WHOLE OR IN PART BY ANY MEANS WHATSOEVER IS STRICTLY PROHIBITED EXCEPT BY WRITTEN CONSENT OF KNIT.
REPRODUCTION OF THIS DOCUMENT IS STRICTLY PROHIBITED EXCEPT BY WRITTEN CONSENT OF KNIT.



ISSUE DATE 07.21.2025

REV	DATE	COMMENT
A	7/21/2025	Owner Revisions

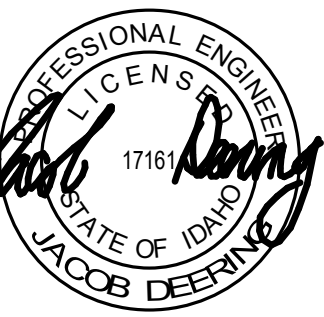

ROOF PLAN - MECHANICAL

FOOD RESEARCH CENTER TI - PHASE 1 (BUILDING #: 005)






860 IDAHO AVE, MOSCOW, ID 83844


UNIVERSITY OF IDAHO

TITLE	PROJECT	CLIENT
ROOF PLAN - MECHANICAL	FOOD RESEARCH CENTER TI - PHASE 1 (BUILDING #: 005)	UNIVERSITY OF IDAHO

JOB NO: 240004
CAPITAL PROJECT NO: CP220034

M2-12

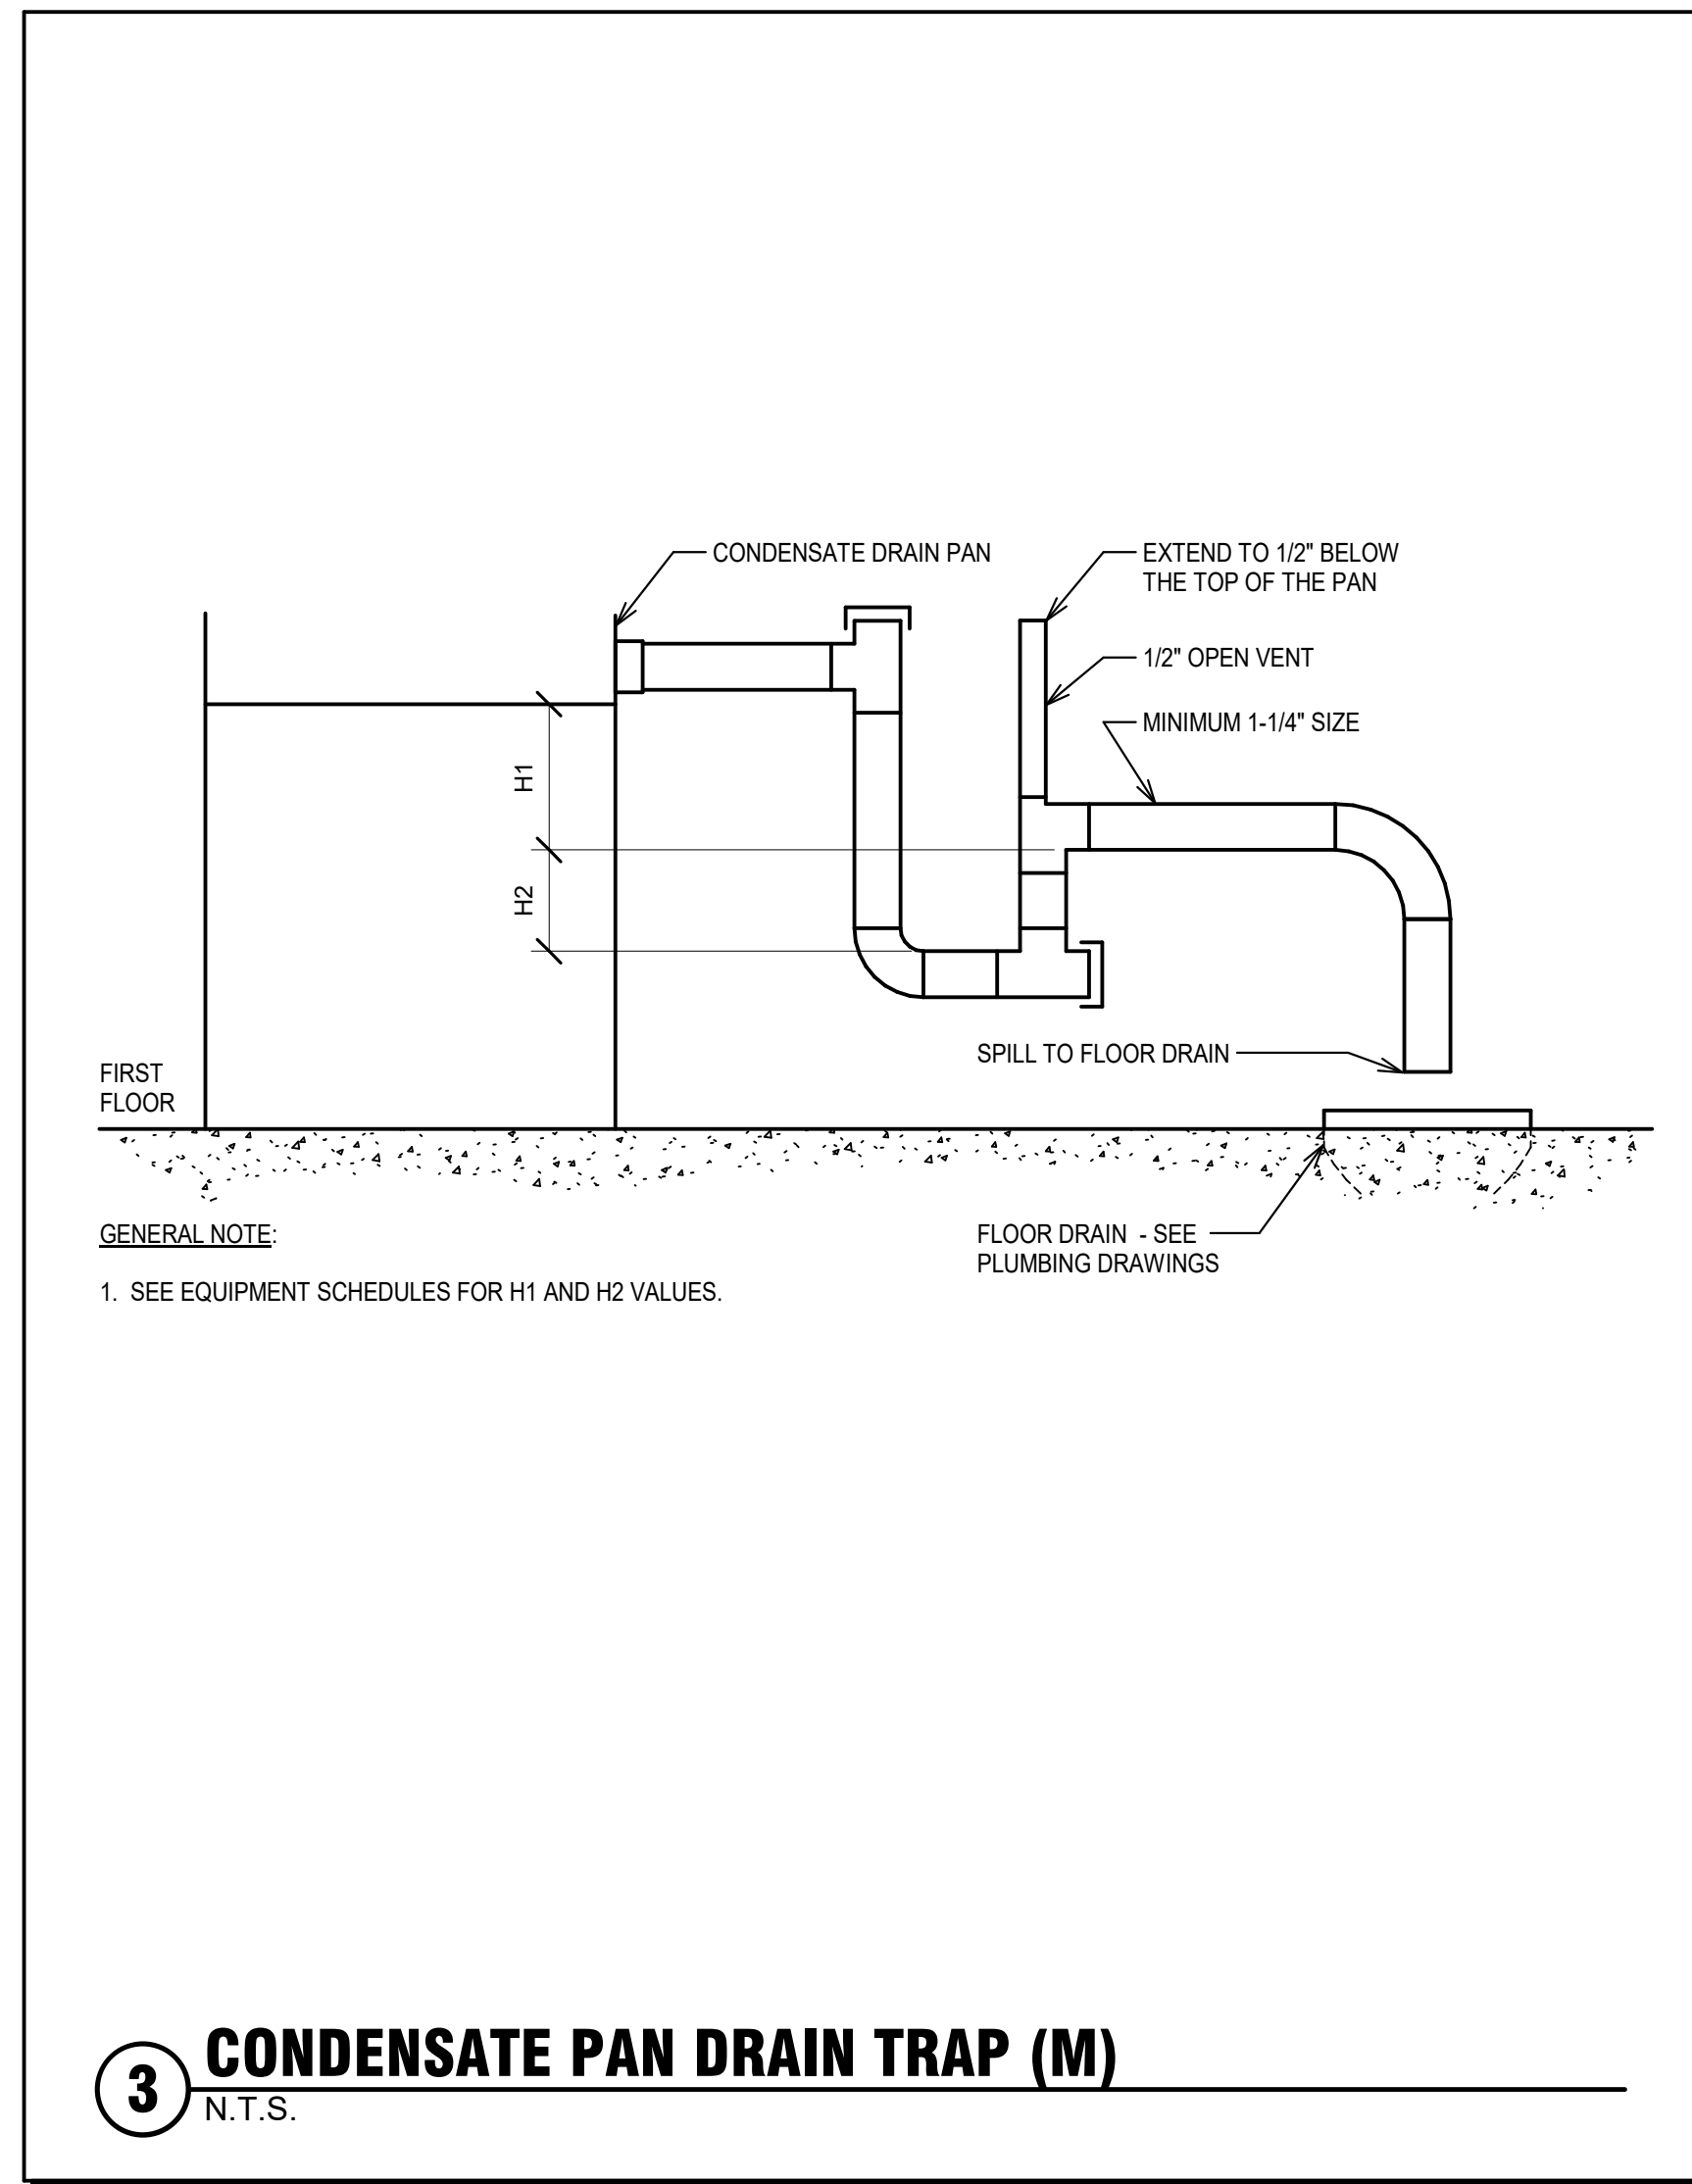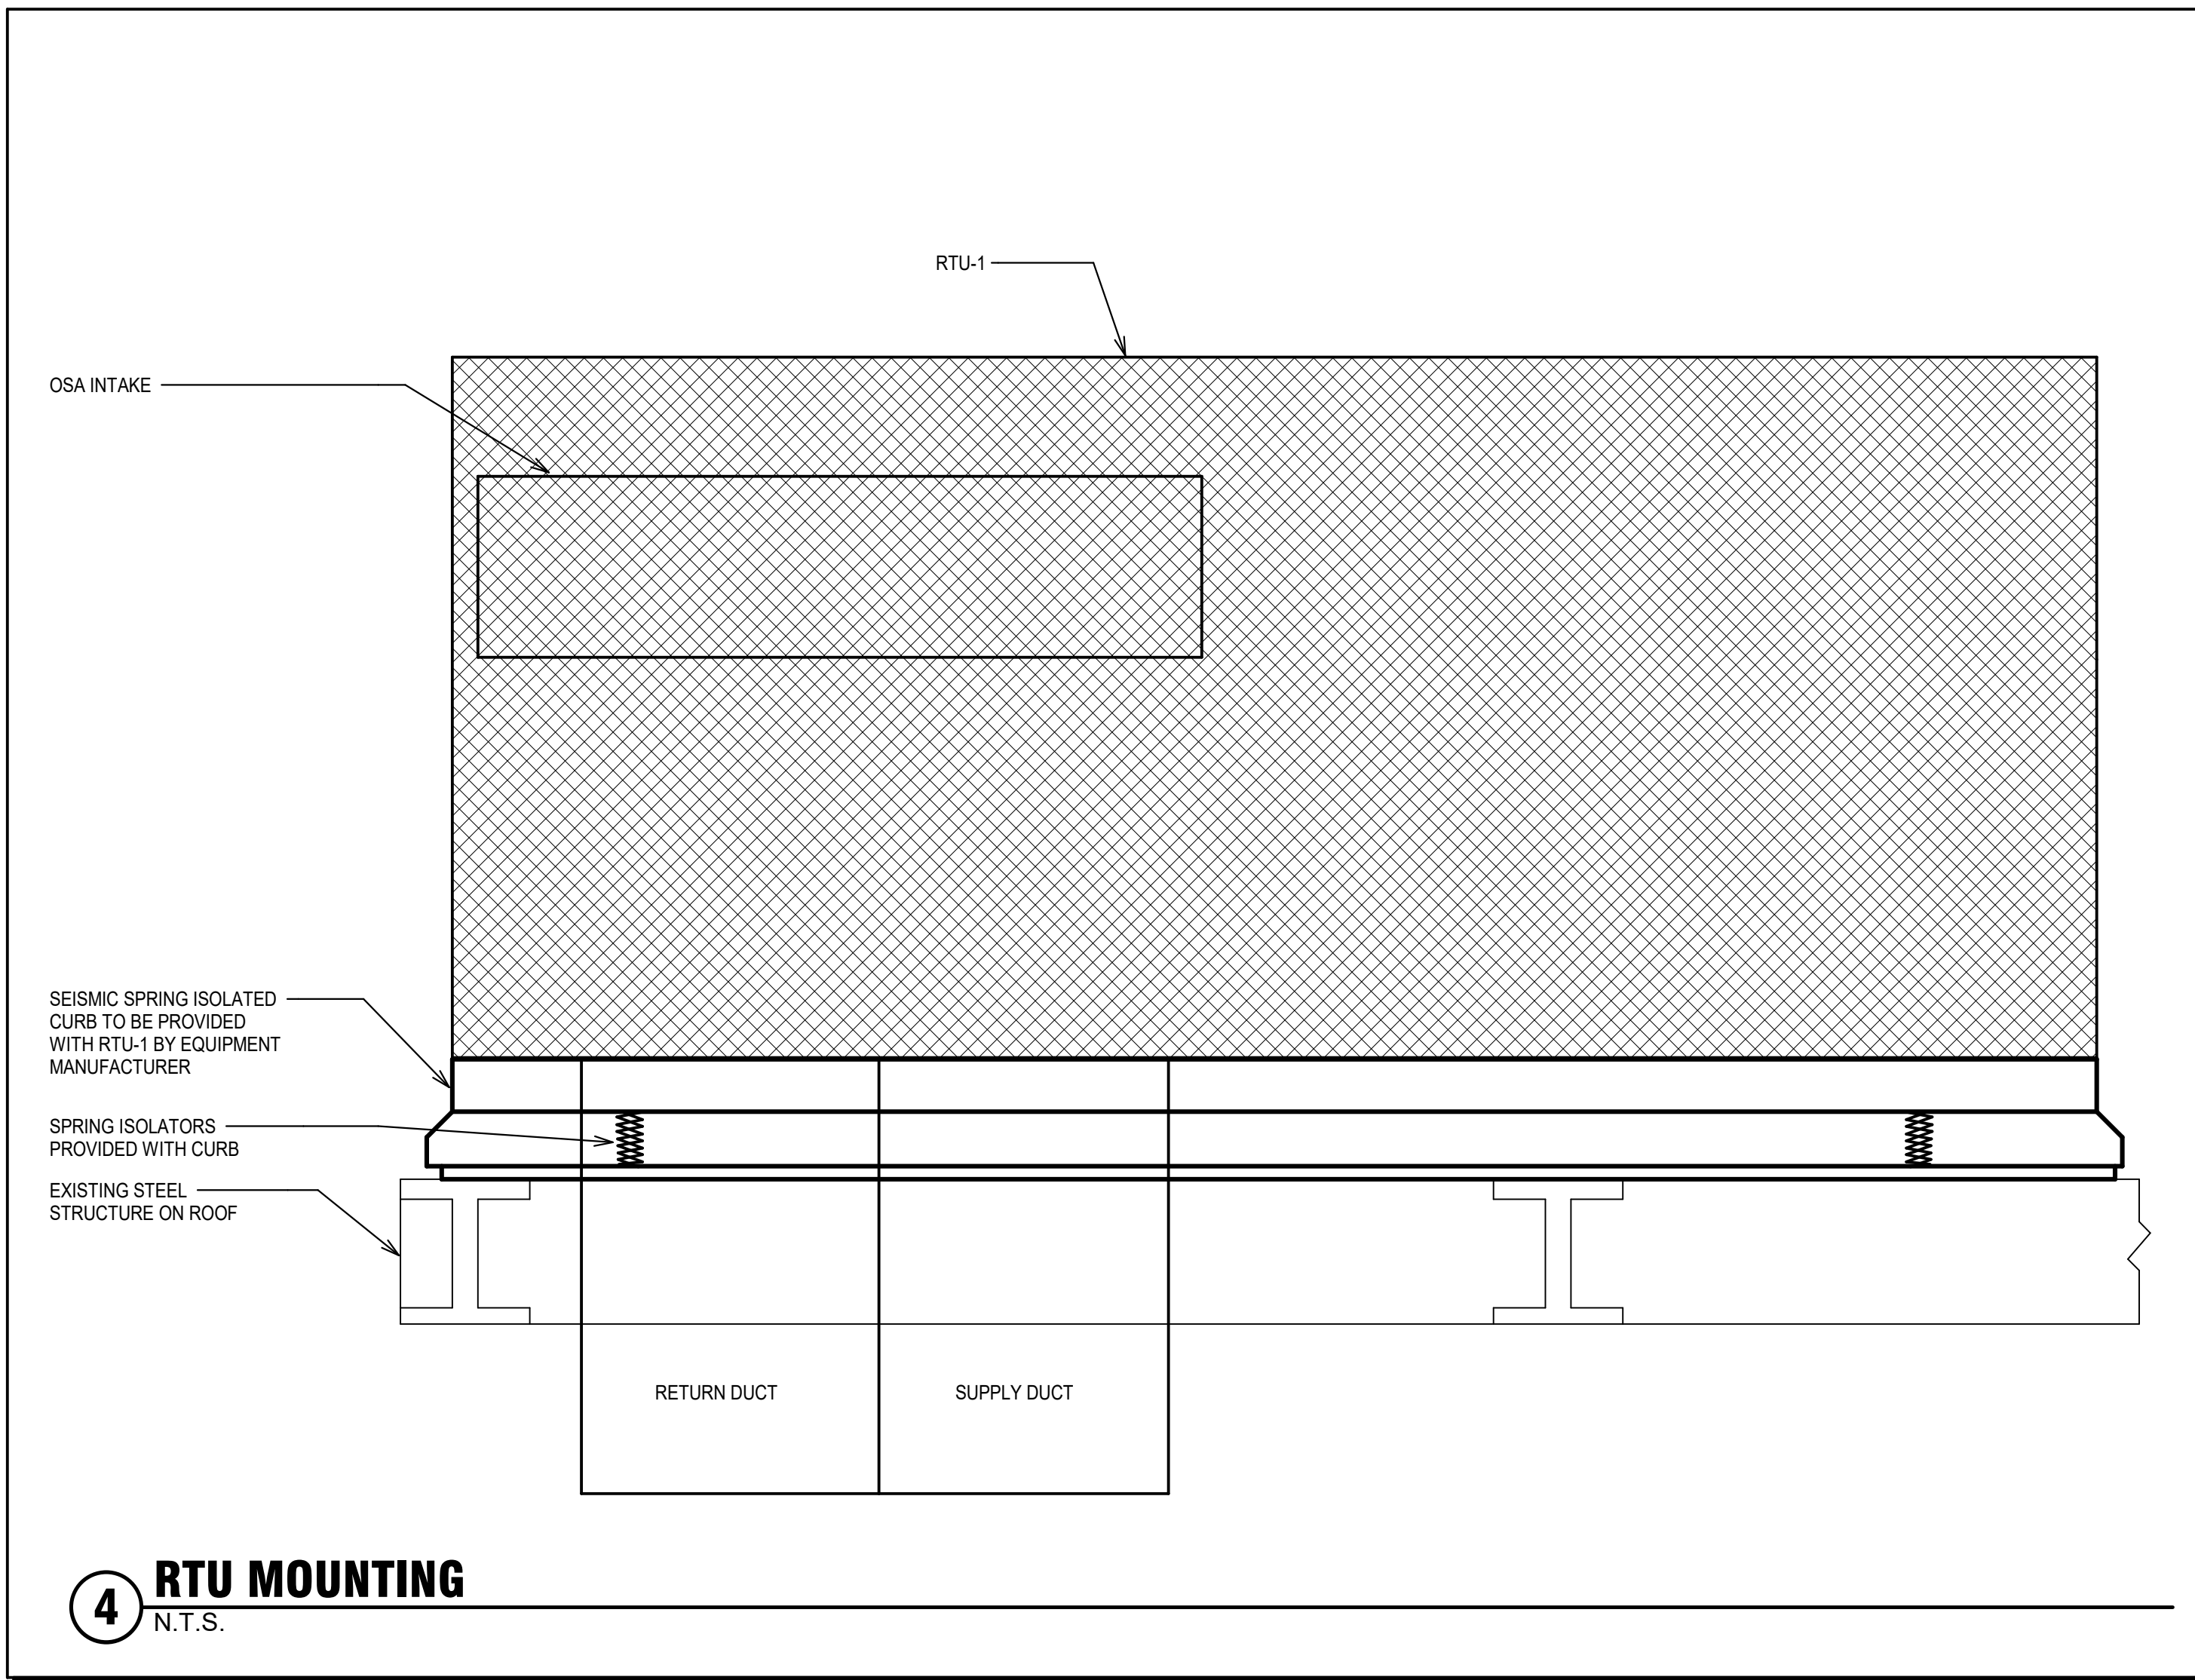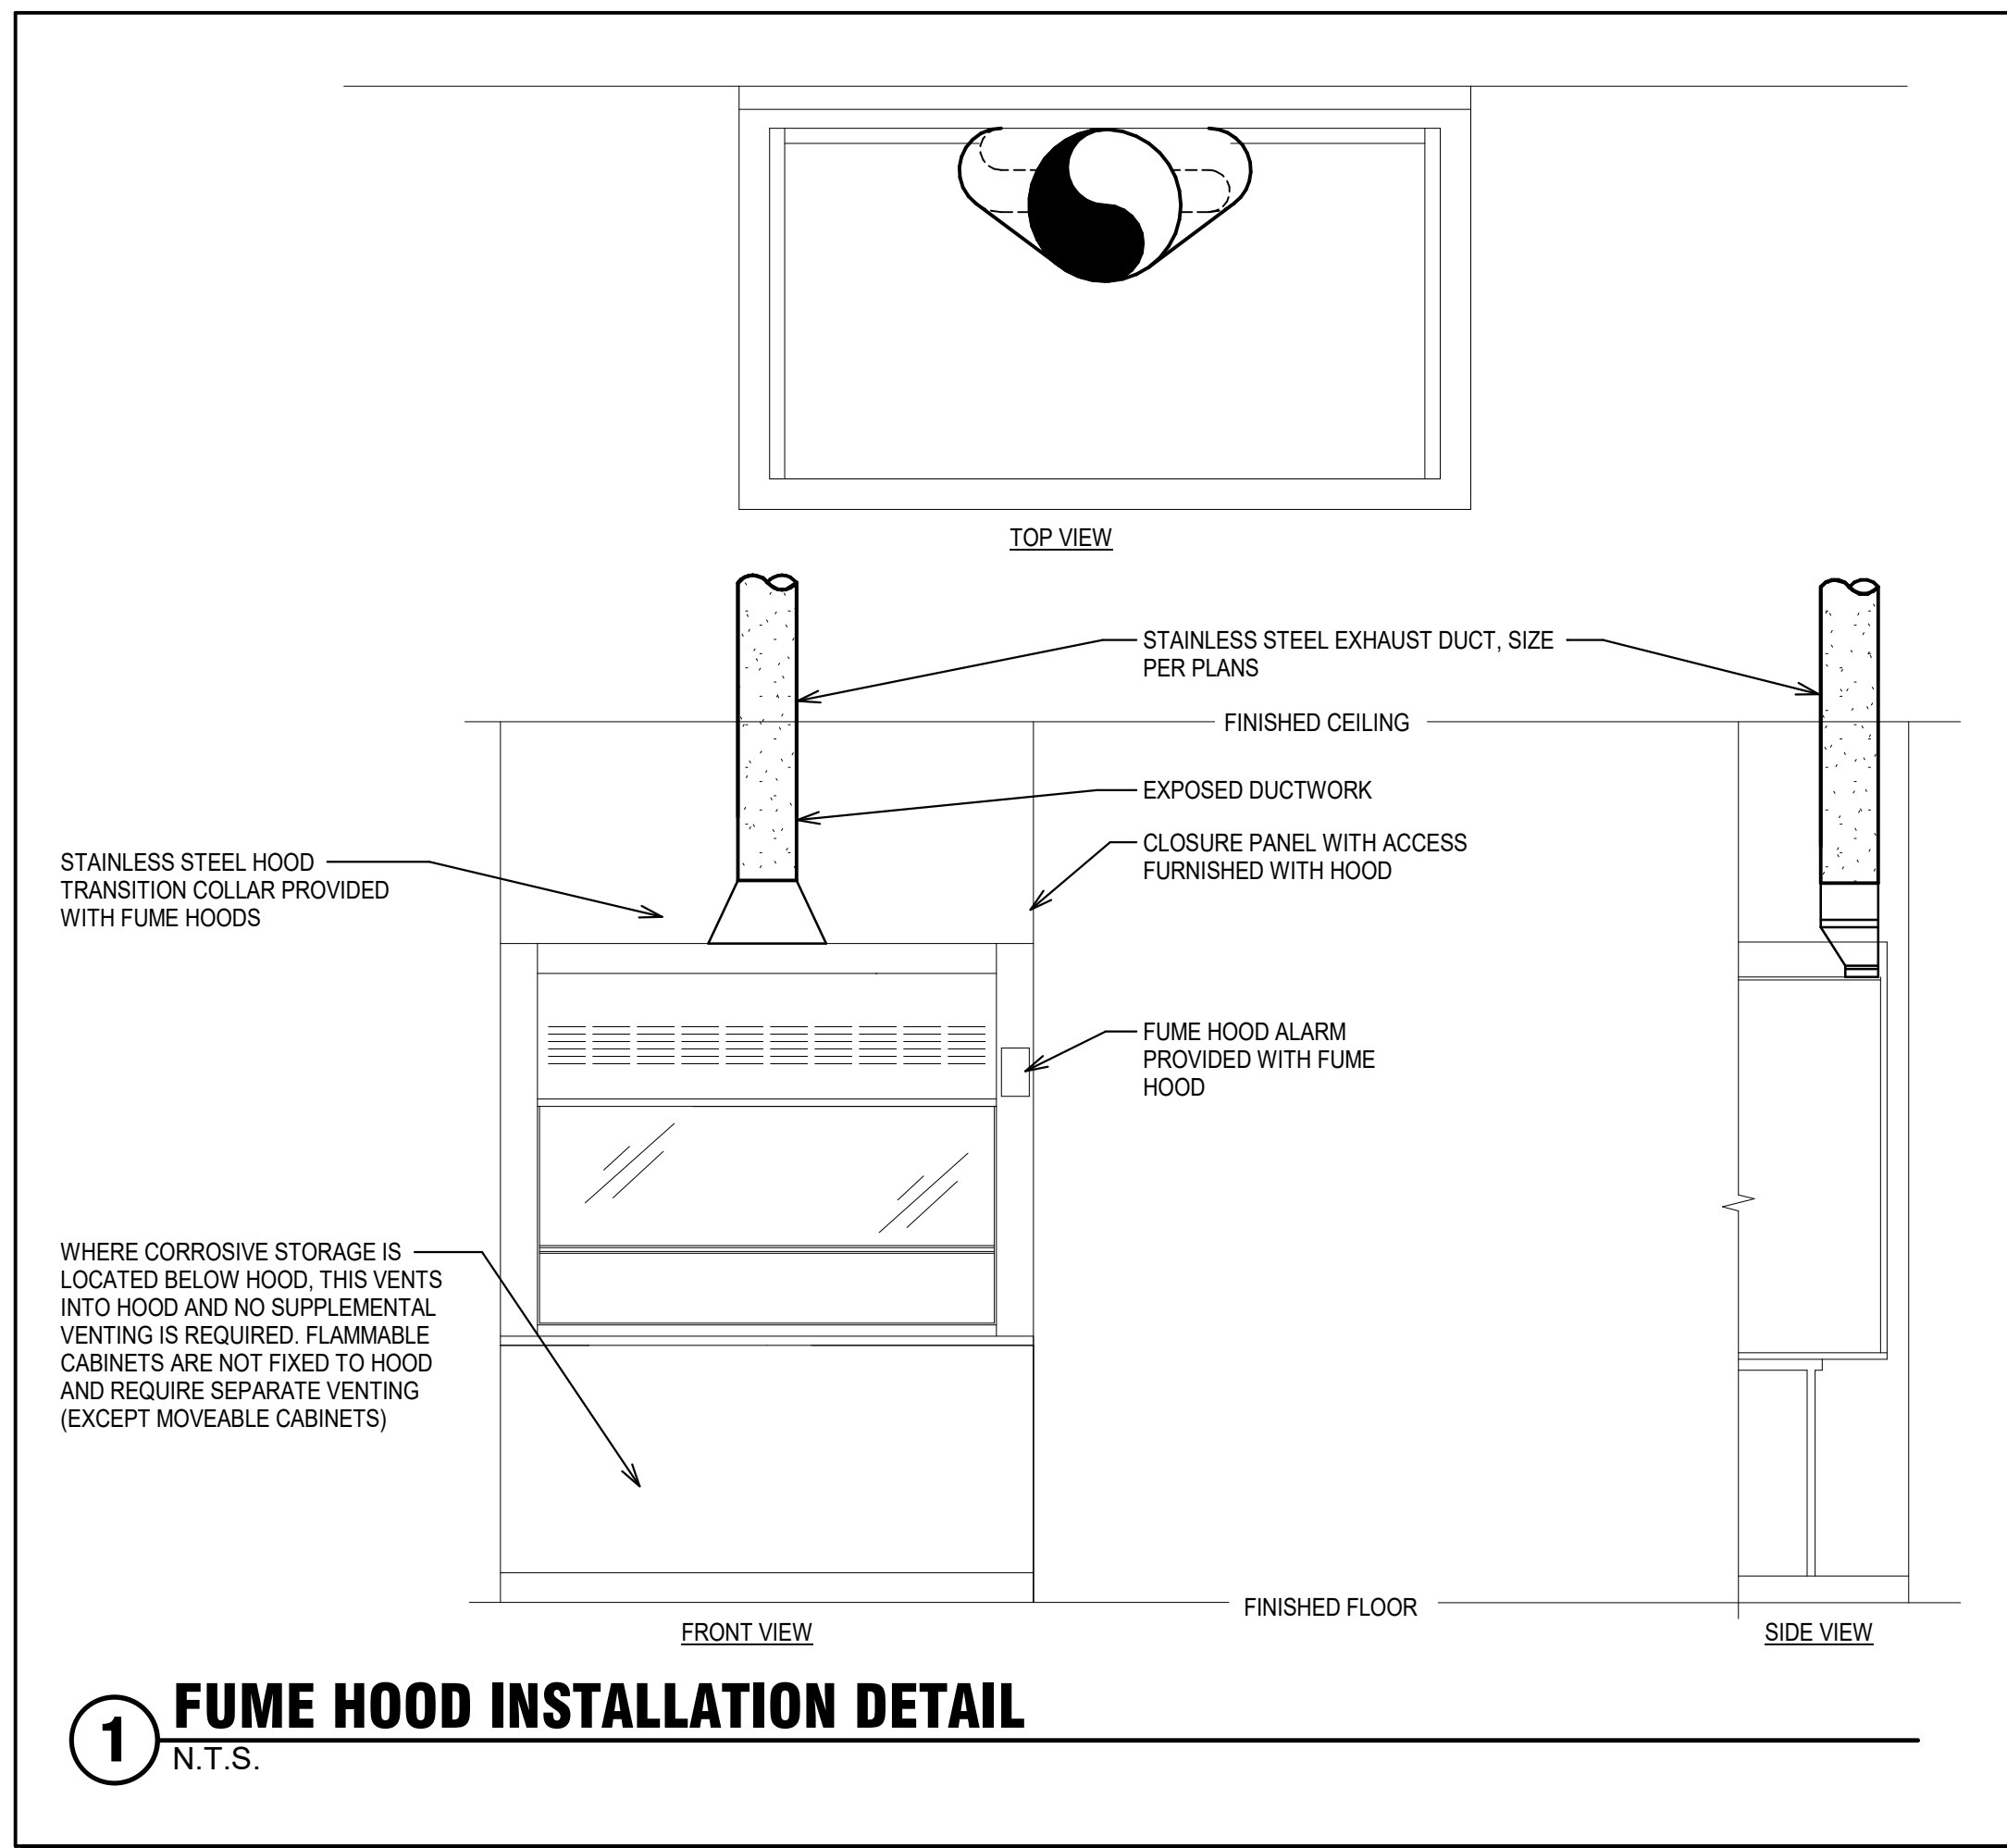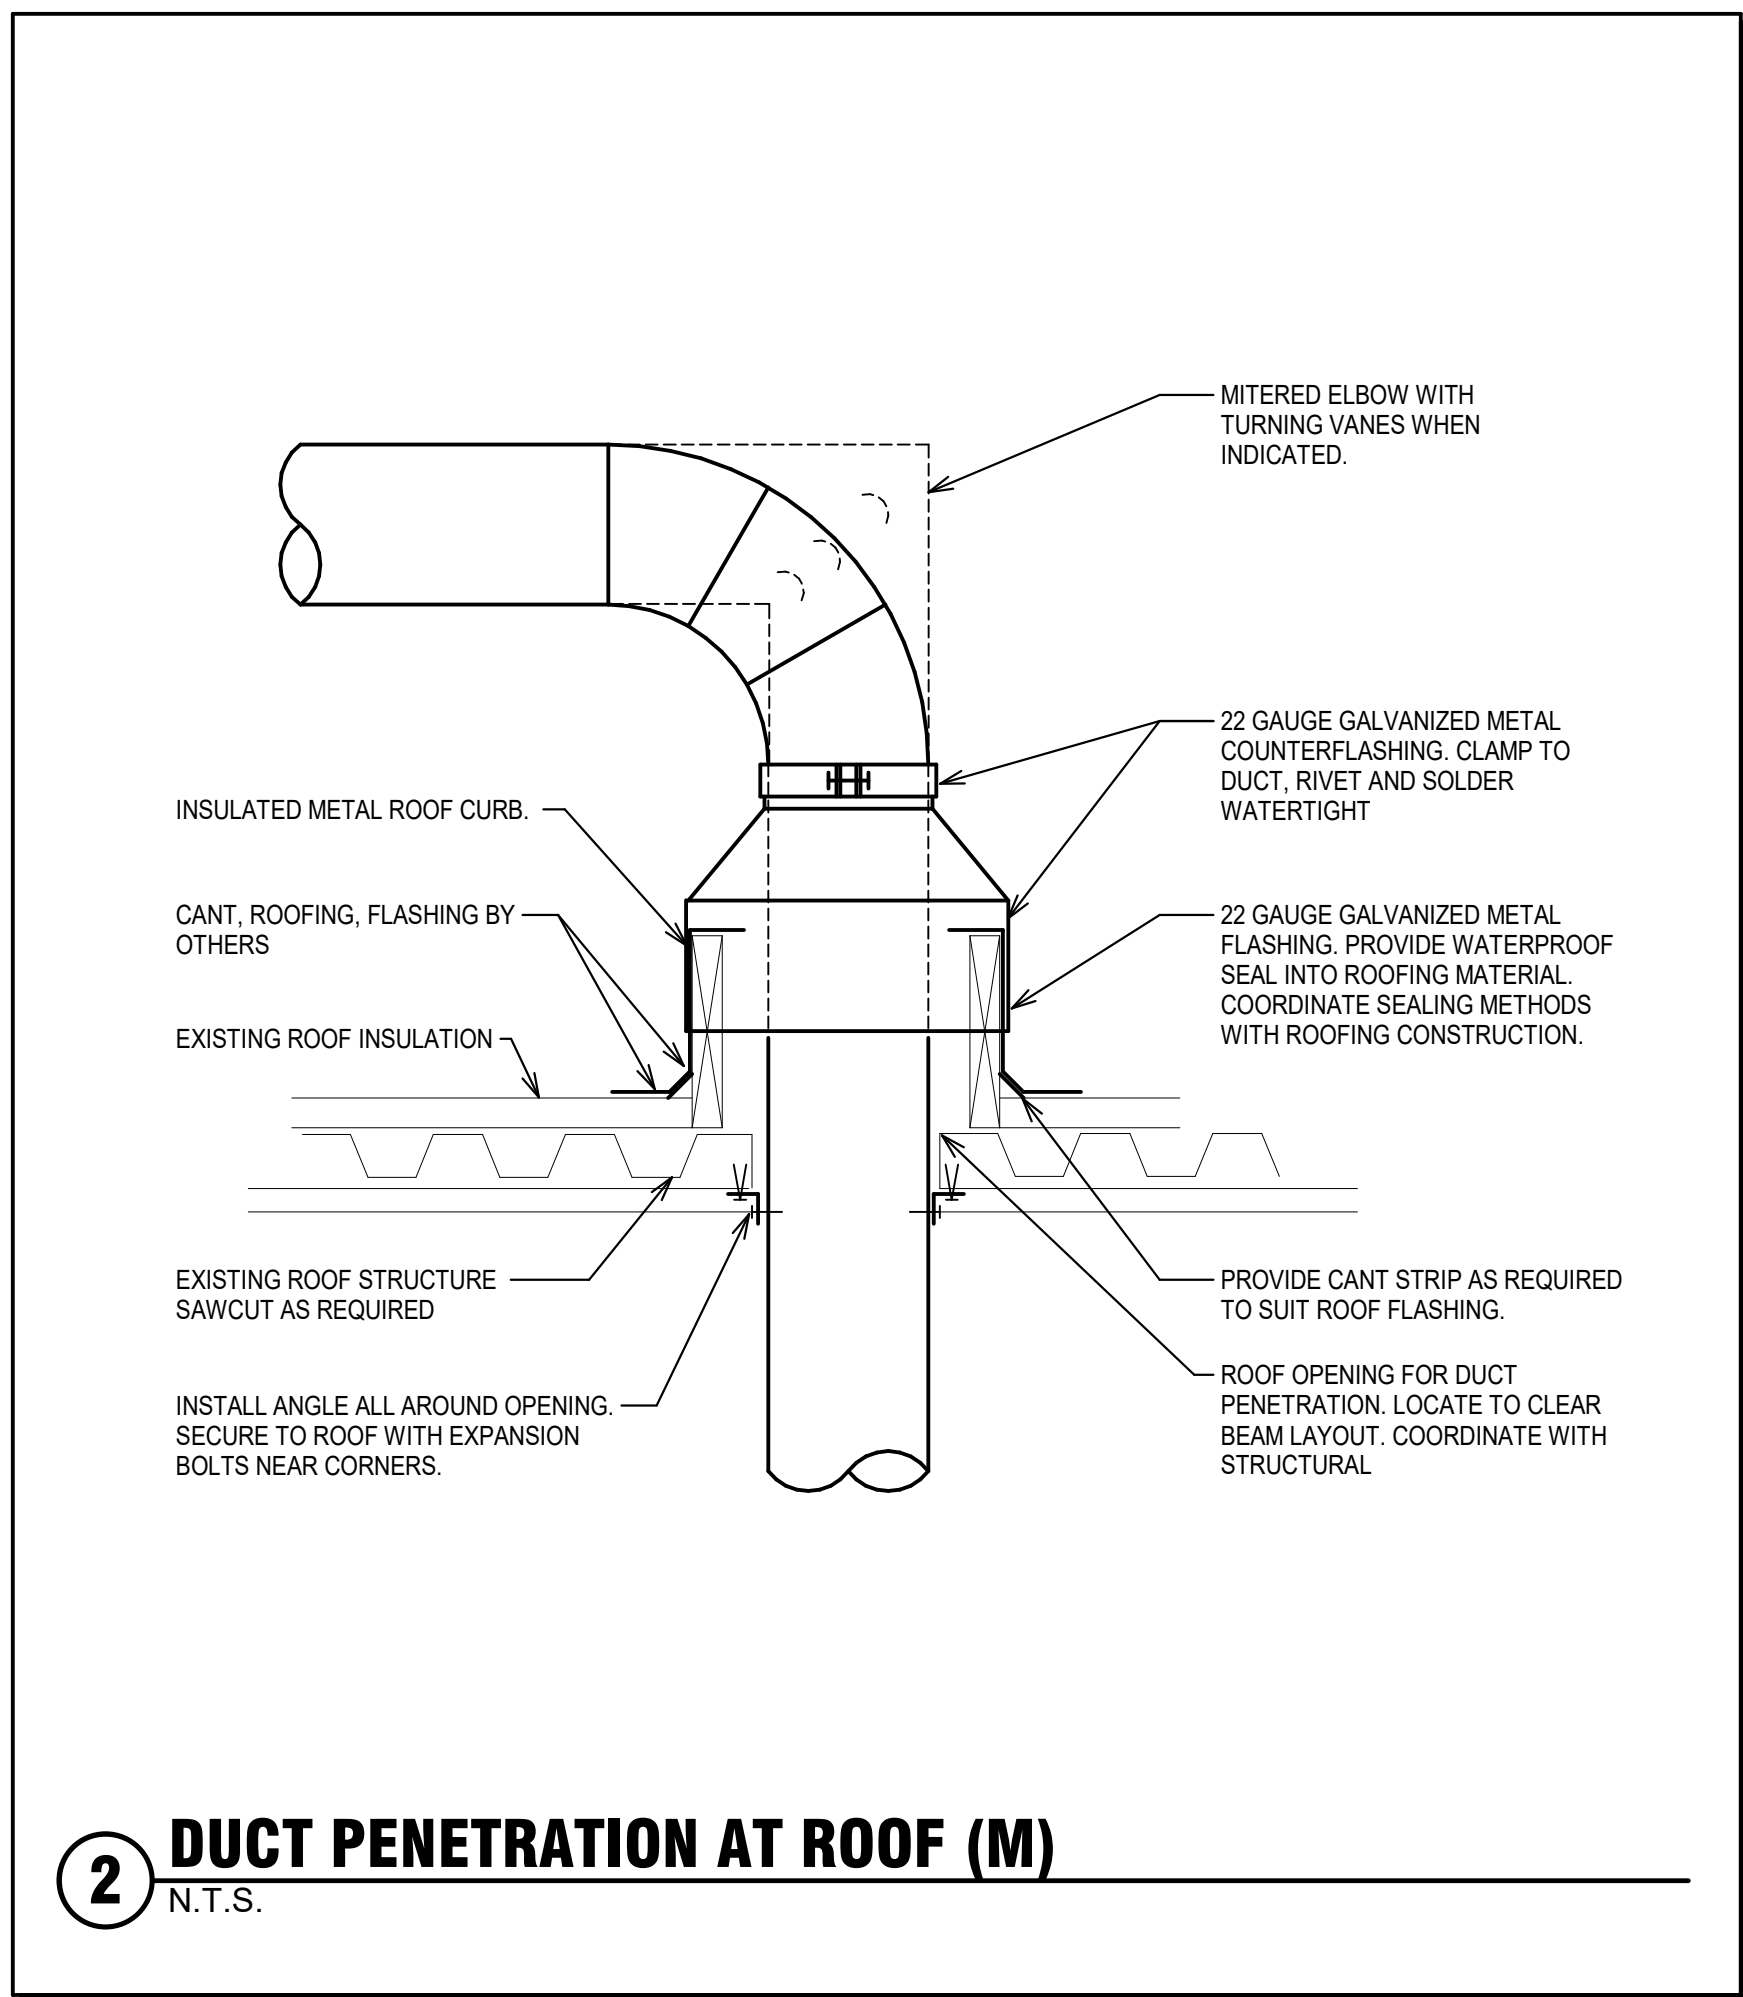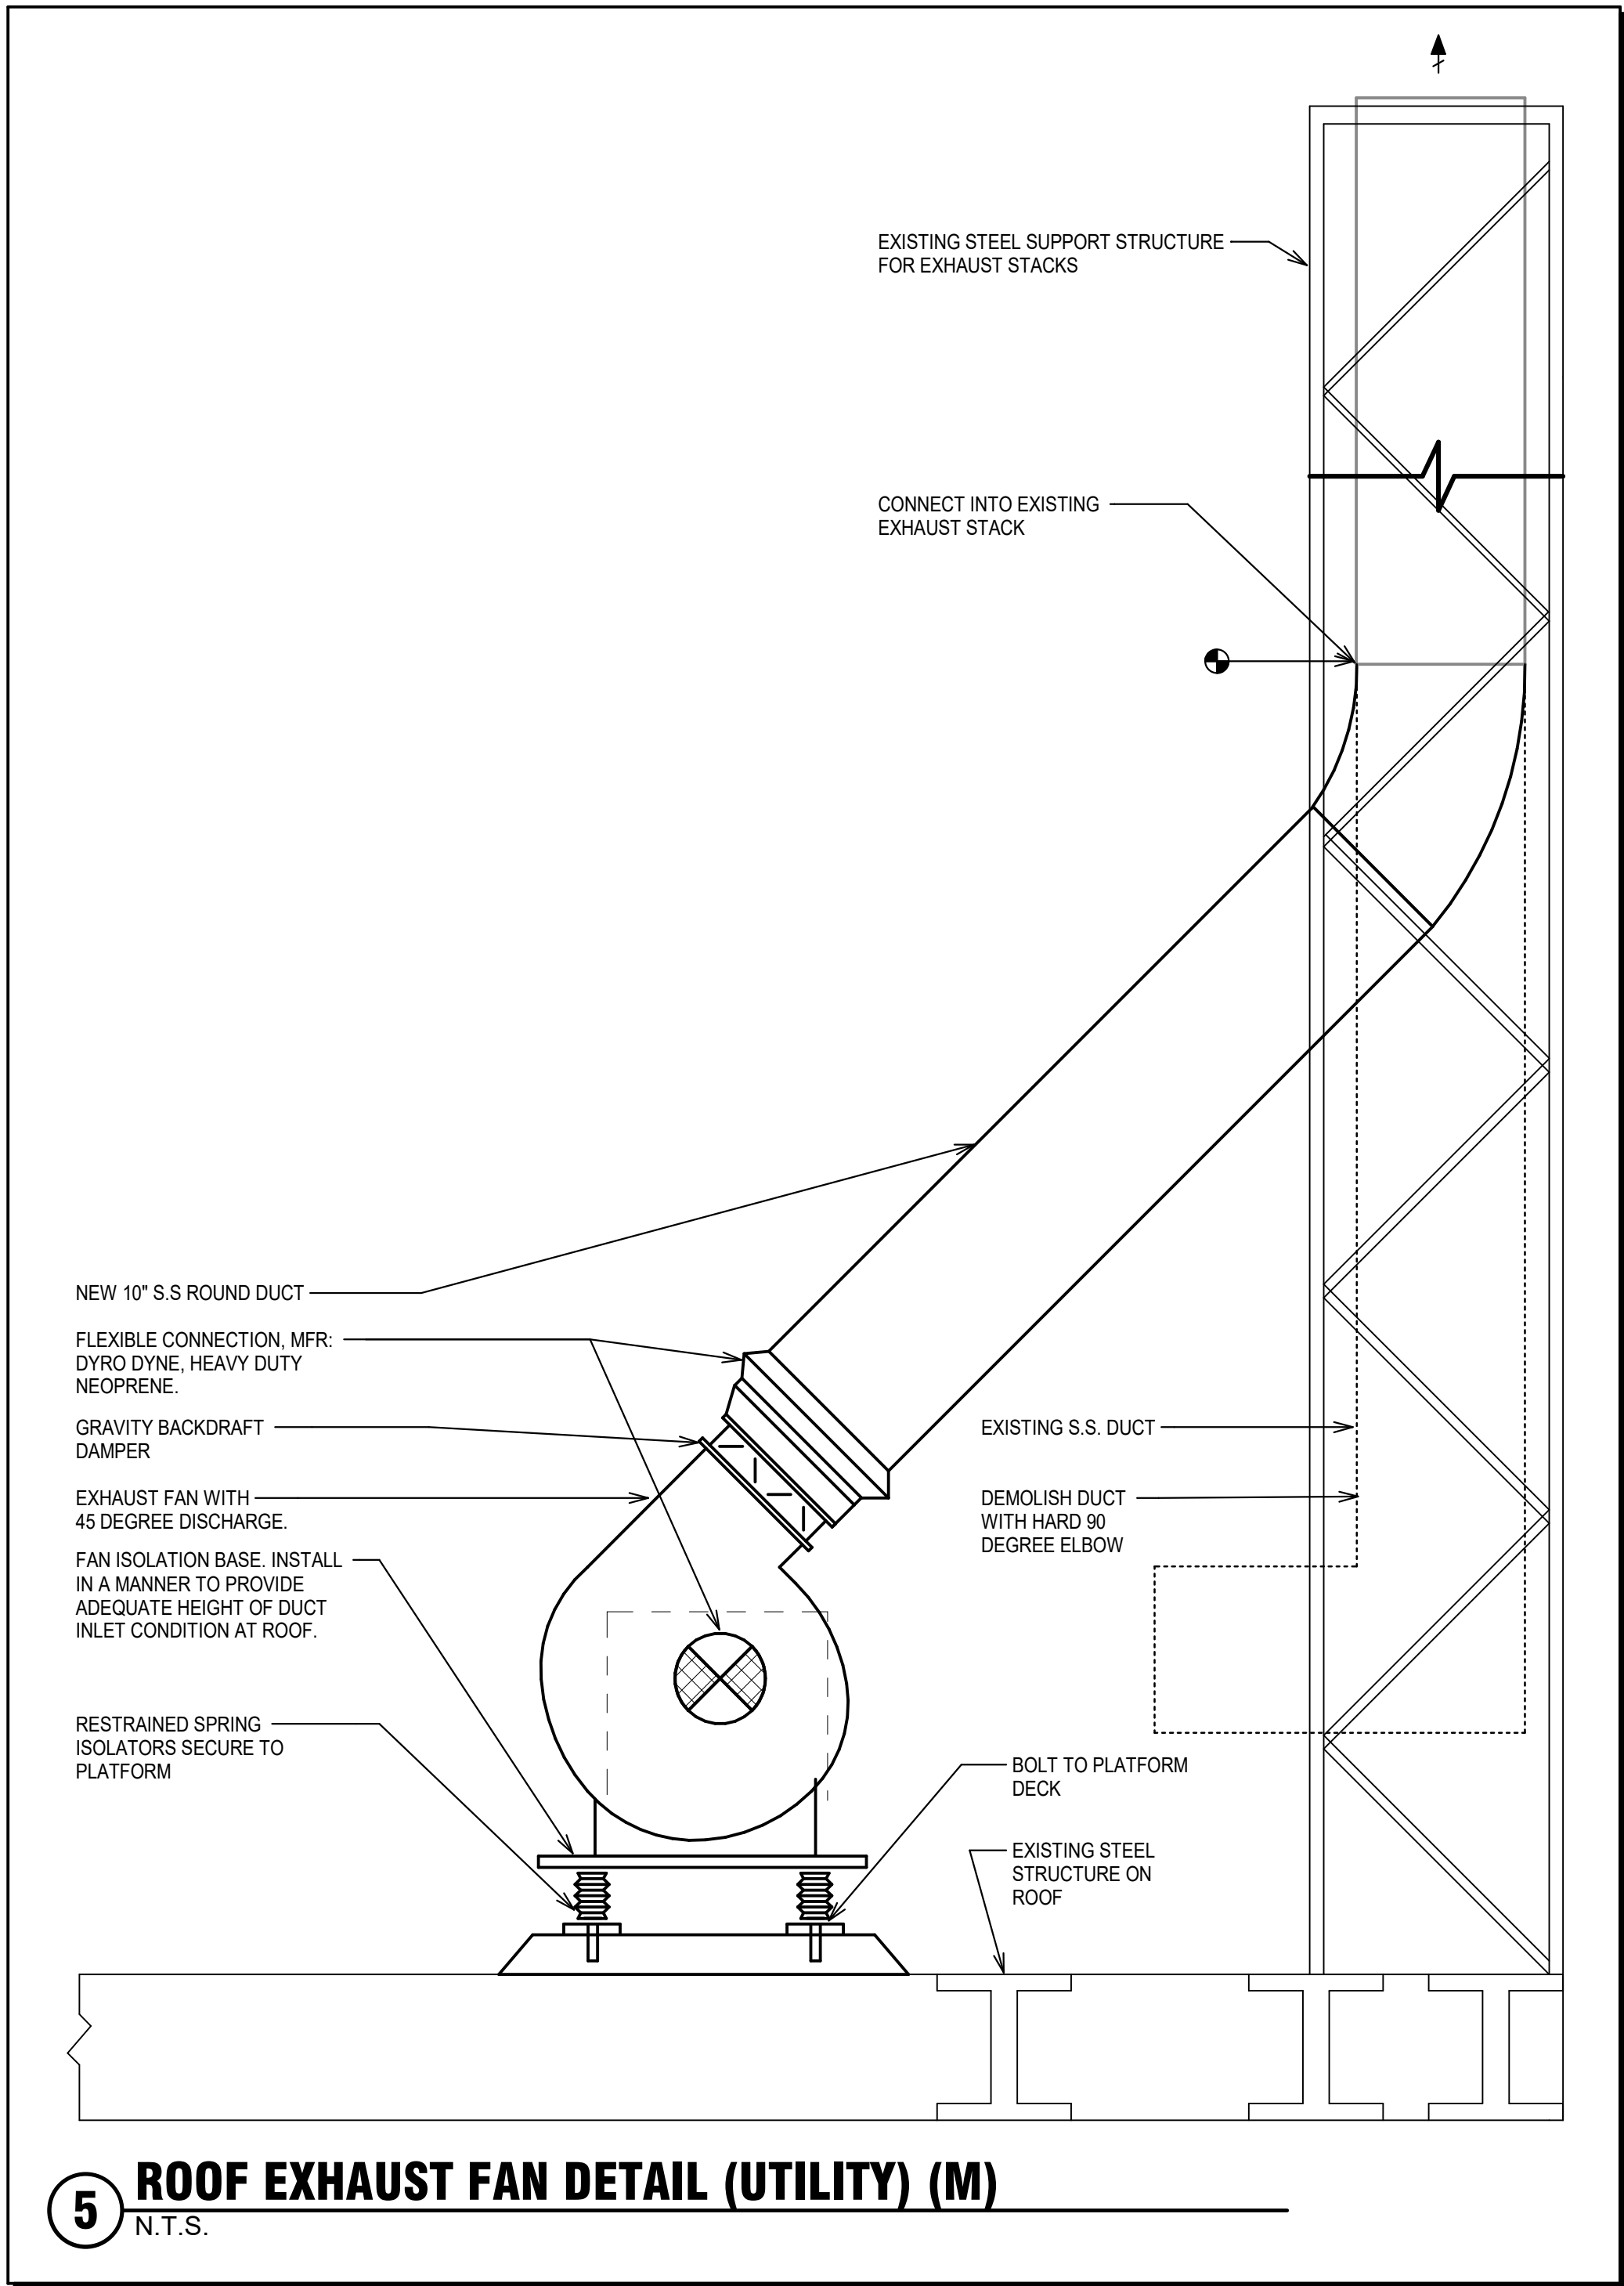

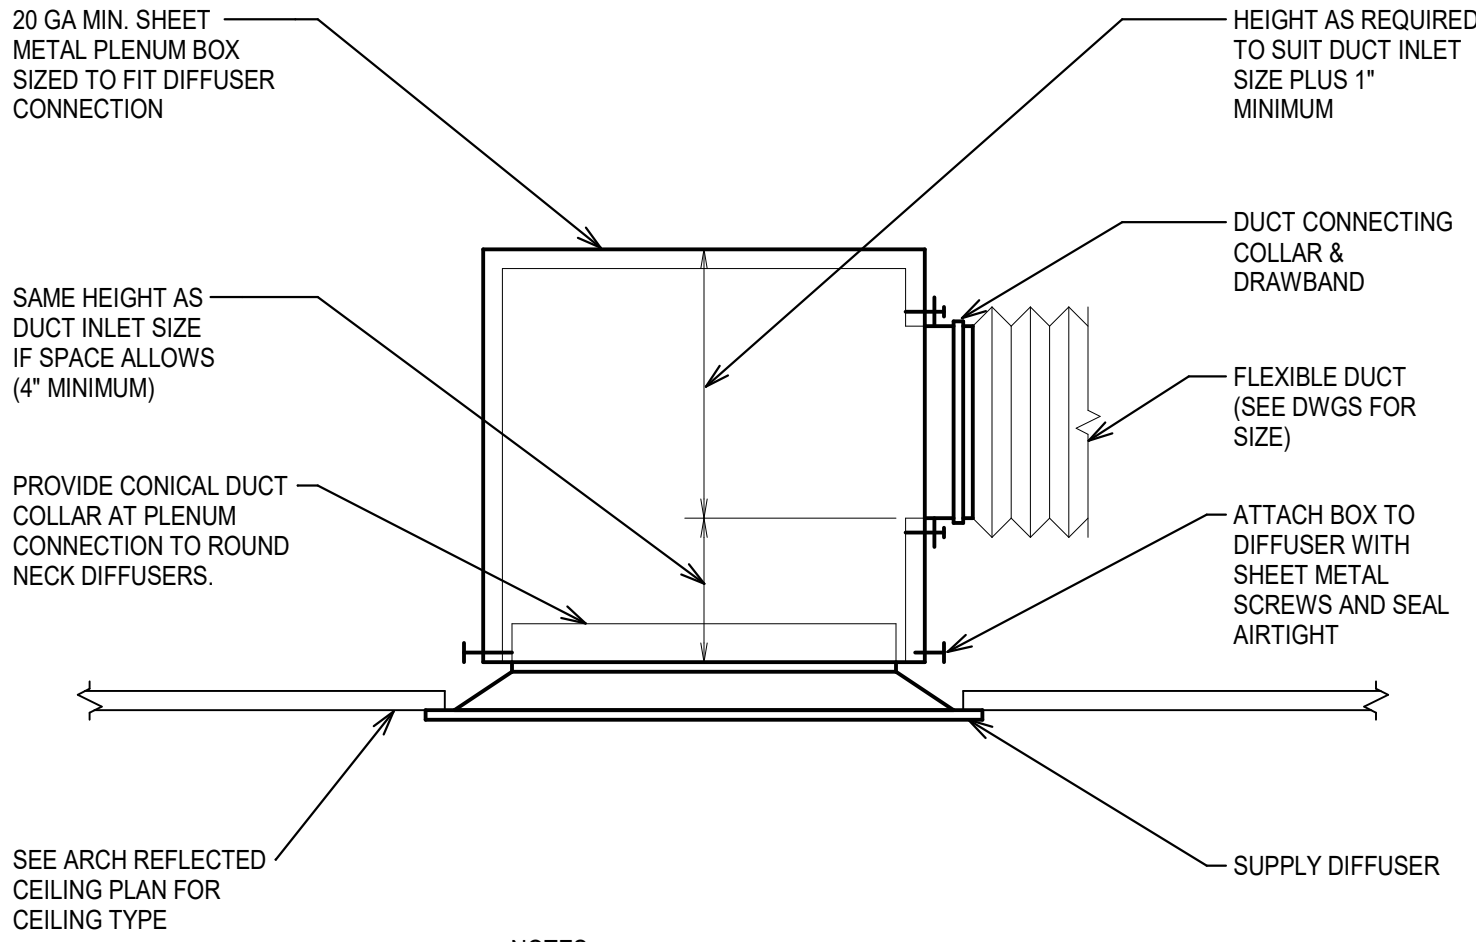

NOTES:


1. ONLY APPLICABLE WHEN SPACE CONDITIONS DO NOT ALLOW LONG RADIUS ELBOW AND STRAIGHT 12" AT DIFFUSER. SEE 'SUPPLY DIFFUSER CONNECTION DETAIL' FOR REQUIRED SUPPLY DIFFUSER INSTALLATION.

3 SUPPLY DIFFUSER BOX DETAIL (M)

N.T.S.


NOTES:

1. PRE-CHARGED, QUICK CONNECT HOSE KIT AVAILABLE FROM MANUFACTURER. CONTRACTOR OPTION TO USE.

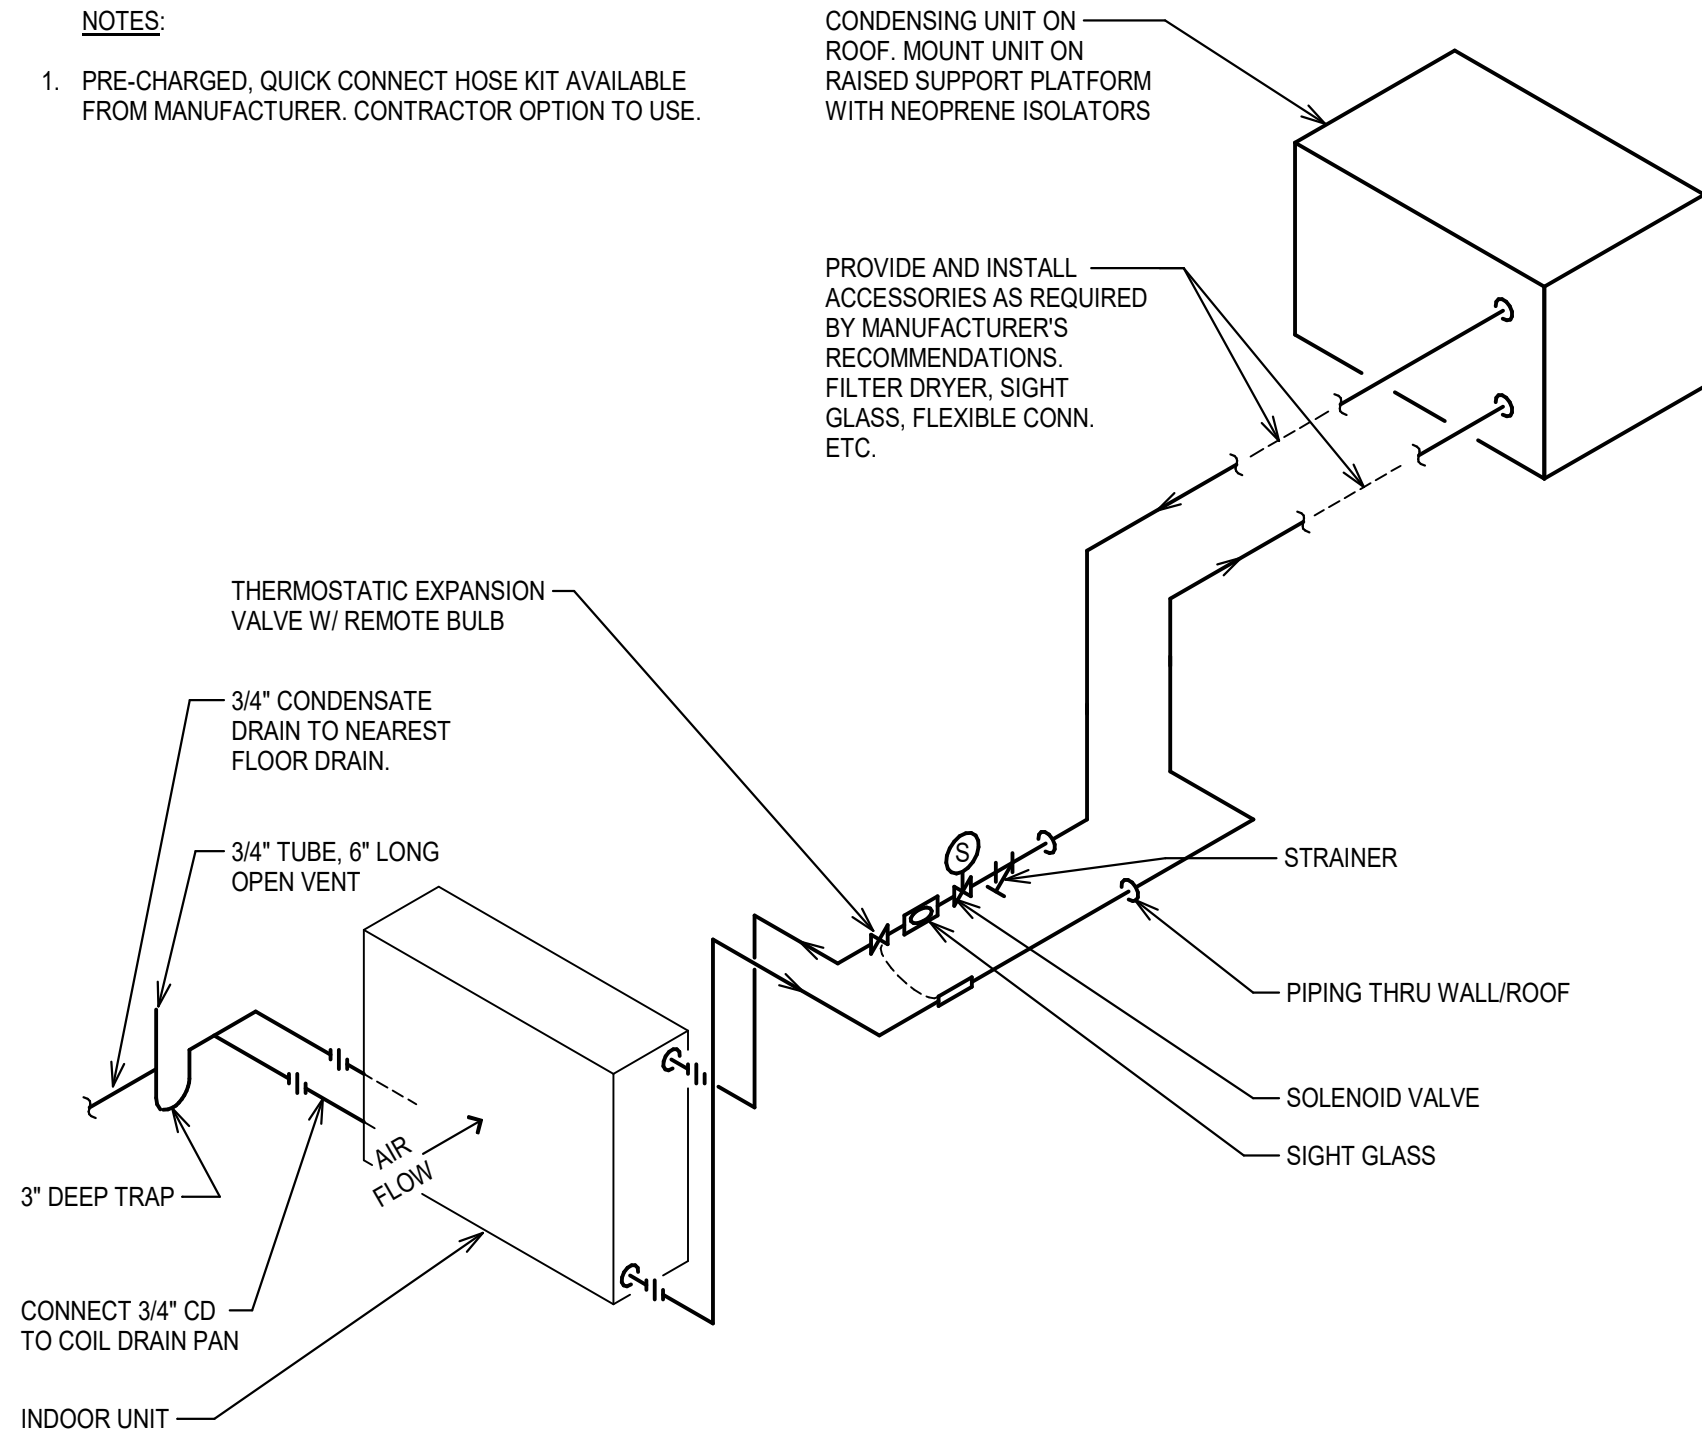

2 SPLIT SYSTEM REFRIGERANT PIPING DETAIL (M)

N.T.S.

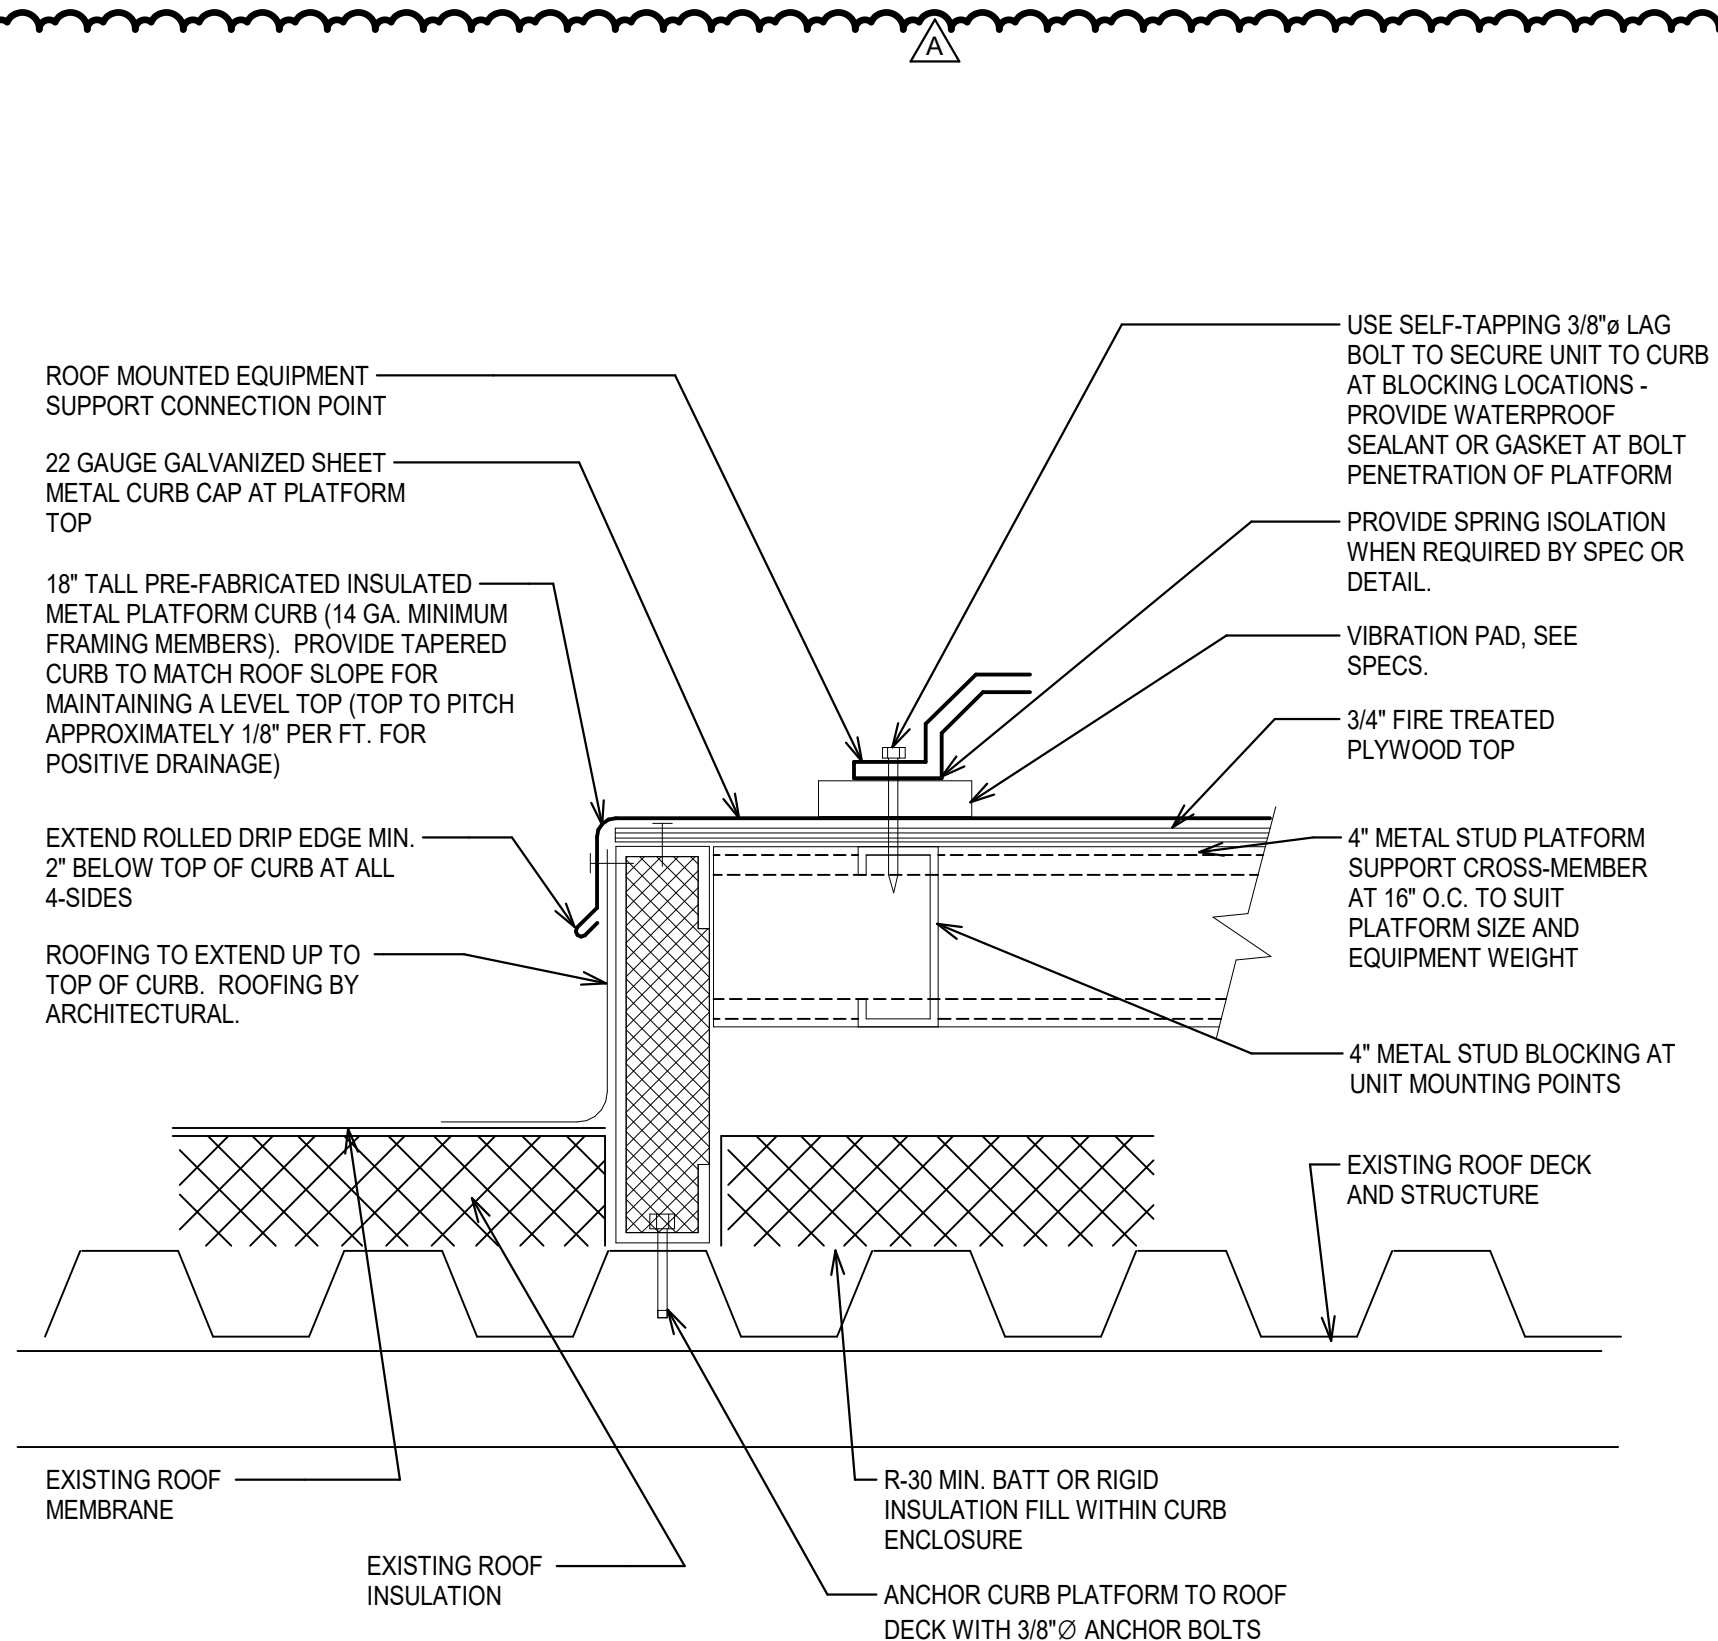


NOTES:

1. SIZE OF CURB TO EXTEND 6" BEYOND EQUIPMENT DIMENSIONS IN ALL DIRECTIONS AND A MINIMUM OF 8" ABOVE FINISHED ROOF.
2. SOLDER WATER-TIGHT ALL SHEET METAL SEAMS AND CORNER JOINTS OF CURB CAP.

1 ROOFTOP PLATFORM DETAIL

N.T.S.

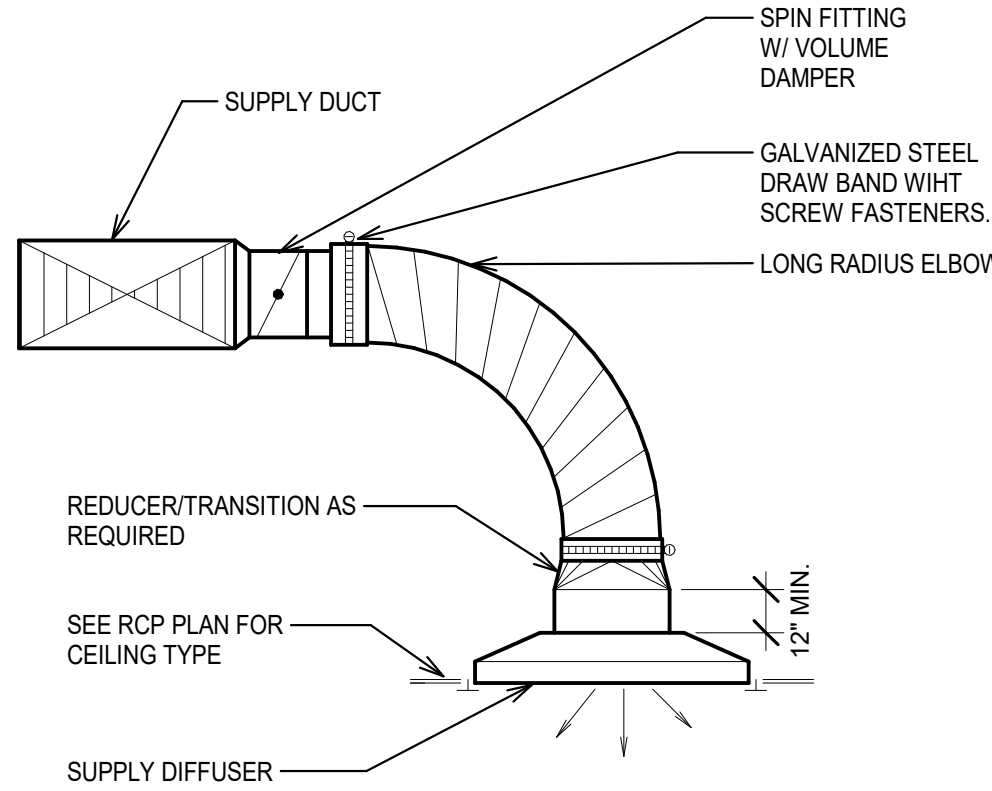


NOTES:

1. WHERE SPACE CONDITIONS DO NOT ALLOW LONG RADIUS ELBOW AND STRAIGHT 12" AT DIFFUSER, SEE 'SUPPLY DIFFUSER BOX (LINED) DETAIL'.

5 SUPPLY DIFFUSER CONNECTION DETAIL (M)


N.T.S.

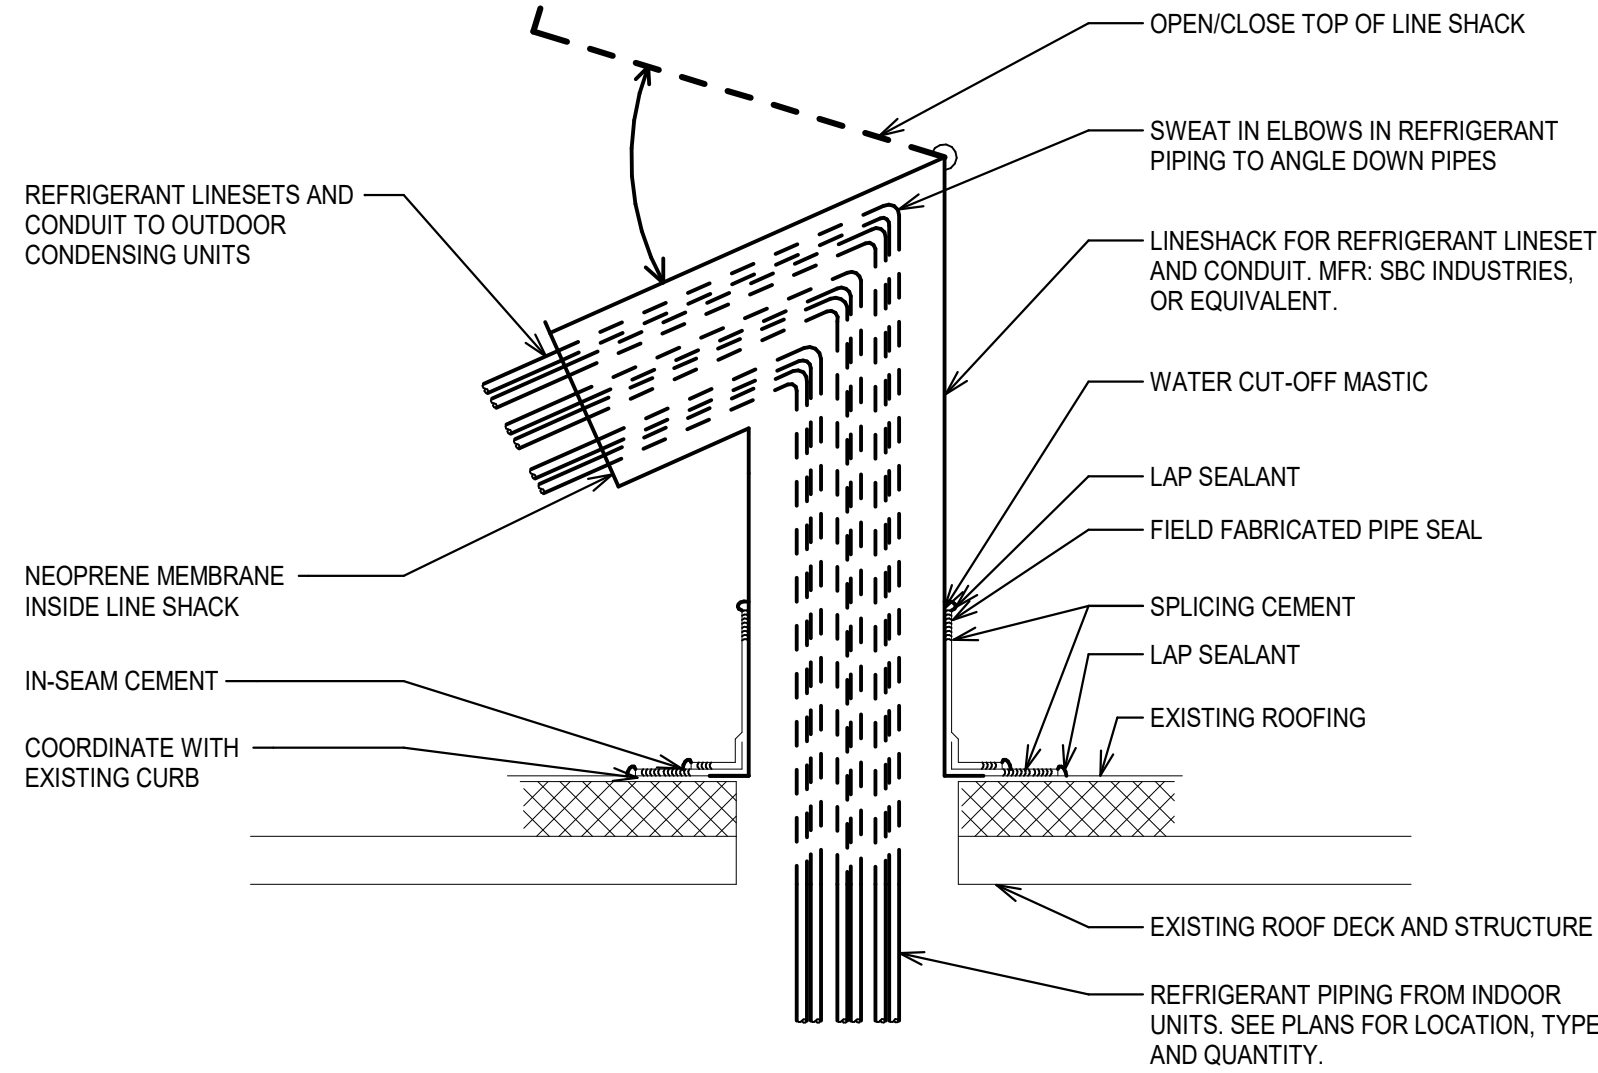

4 LINE SHACK DETAIL

N.T.S.

CLOUDED WORK IS ALTERNATE #2

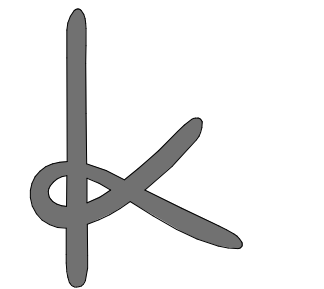

knitstudios.com

THESE DOCUMENTS HAVE BEEN PRODUCED AS AN INSTRUMENT OF SERVICE AND ARE INTENDED SOLELY FOR THE PURPOSE OF CONTRACTING. LINES AND MARKINGS THE PROJECT. KNIT AS THE ARCHITECT OF RECORD FOR THE PROJECT. RETAINING OWNERSHIP OF THESE DOCUMENTS. ANY USE OF THESE DOCUMENTS OR USE OF THE DESIGN IDEAS OR CONCEPTS DESCRIBED HEREIN IN WHOLE OR IN PART BY ANY MEANS WHATSOEVER IS STRICTLY PROHIBITED EXCEPT BY WRITTEN CONSENT OF KNIT. REPRODUCTION OF THIS DOCUMENT IS STRICTLY PROHIBITED EXCEPT BY WRITTEN CONSENT OF KNIT.



ISSUE DATE: 07.21.2025

REV DATE COMMENT
A 7/21/2025 Owner Revisions



DETAILS - MECHANICAL

FOOD RESEARCH CENTER TI - PHASE 1 (BUILDING #: 005)

860 IDAHO AVE. MOSCOW, ID 83844

UNIVERSITY OF IDAHO

TITLE PROJECT CLIENT

JOB NO: 240004
CAPITAL PROJECT NO: CP220034

M5-02




THESE DOCUMENTS HAVE BEEN PRODUCED AS AN INSTRUMENT OF SERVICE AND ARE INTENDED SOLELY FOR THE PURPOSE OF CONSTRUCTING, USING AND MAINTAINING THE PROJECT. KNIIT AS THE ARCHITECT OF RECORD FOR THE PROJECT RETAINS OWNERSHIP OF THESE DOCUMENTS.

ANY USE OF THESE DOCUMENTS OR USE OF THIS DESIGN, IDEAS OR CONCEPTS DESCRIBED HEREIN IN WHOLE OR PART BY ANY MEANS WHATSOEVER IS STRICTLY PROHIBITED EXCEPT BY WRITTEN CONSENT OF KNIIT.

REPRODUCTION OF THIS DOCUMENT IS STRICTLY PROHIBITED EXCEPT BY WRITTEN CONSENT OF KNIIT.



REV	DATE	COMMENT
A	7/21/2025	Owner Revisions

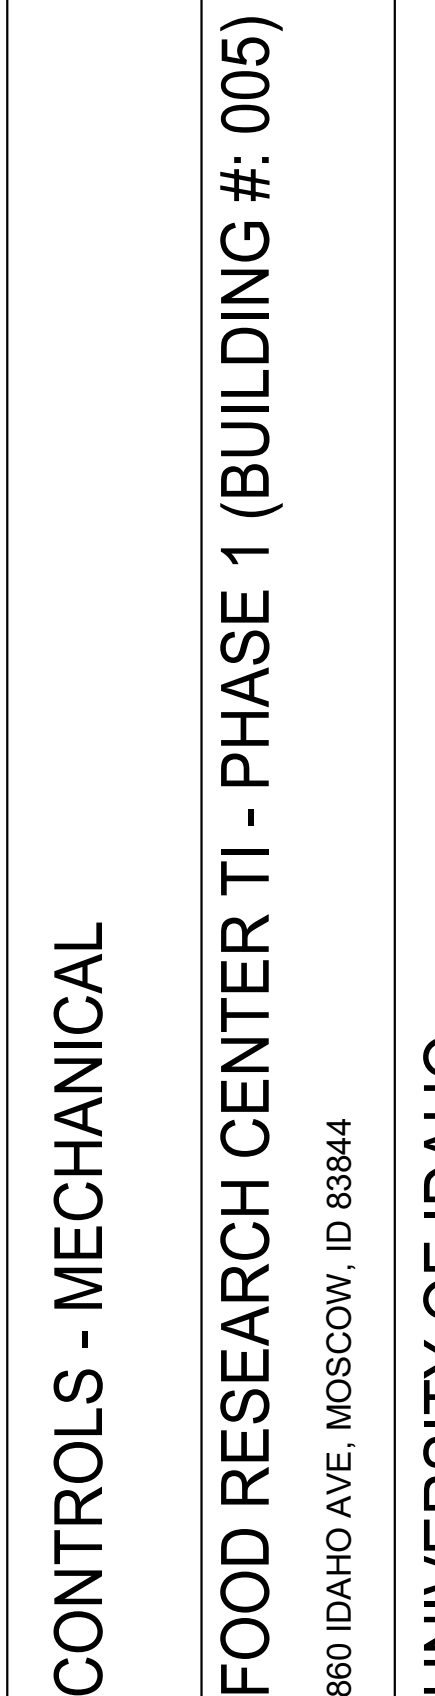

CONTROLS - MECHANICAL

FOOD RESEARCH CENTER TI - PHASE 1 (BUILDING #: 005)

860 IDAHO AVE, MOSCOW, ID 83844
UNIVERSITY OF IDAHO

TITLE	PROJECT	CLIENT
JOB NO:	240004	
CAPITAL PROJECT NO:	CP220034	

M7-01

SEQUENCE OF OPERATION

INDOOR FAN COIL AND CONDENSING UNIT SHALL CYCLE UPON DEMAND FOR COOLING FROM UNIT PROVIDED SPACE SENSOR.
WHEN THE RADIATOR SENSOR SENSES HEAT (ABOVE 110 DEGREES) ADJ. THE FAN COIL COOLING SHALL BE LOCKED OUT.

DUCTLESS SPL
ALTERNATE #2

SEQUENCE OF OPERATION

FAILURE OF FUME HOOD EXHAUST FAN EF-1 SHALL DISABLE THE RTU

OCCUPIED MODE

THE SUPPLY FAN SHALL BE ON AND SHALL OPERATE CONTINUOUSLY.

WITH NO DEMAND FOR COOLING (SPACE TEMPERATURE SATISFIED) AND A CALL FOR HEATING, THE HEAT PUMP SHALL OPERATE AS THE FIRST STAGE OF HEATING. ADDITIONAL CALL FOR HEAT SHALL ENABLE THE ELECTRIC RESISTANCE HEATING. THE HEATING COIL SHALL MODULATE STAGES OF HEAT TO MAINTAIN THE LEAVING AIR TEMPERATURE SETPOINT. THE REVERSE SHALL OCCUR UPON A REDUCED DEMAND FOR HEATING.

A CALL FOR COOLING TO MAINTAIN THE DISCHARGE AIR TEMPERATURE SHALL ENABLE THE HEAT PUMP COOLING. COOLING SETPOINT SHALL BE RESET BETWEEN 52 AND 60 (ADJ). THE COMPRESSOR SHALL BE ENABLED AND SHALL MODULATE TO MAINTAIN THE REQUIRED DISCHARGE AIR TEMPERATURE. THE REFRIGERATION CONTROLS SHALL BE SENSITIVE TO RAPID CYCLING OF COMPRESSORS AS IT AFFECTS COOLING COIL DISCHARGE AIR TEMPERATURE STABILITY. WHEN THE RADIATOR SENSOR SENSES HEAT (ABOVE 110 DEGREES) ADJ. THE RTU COOLING SHALL BE LOCKED OUT.

THE CONDENSING UNIT FACTORY CONTROLS SHALL START/STOP/MODULATE THE CONDENSING UNIT FAN

OUTSIDE AIR DAMPER SHALL BE SET TO A FIXED POSITION TO SUPPLY MAKE-UP AIR TO THE FUME HOOD EXHAUST

UNOCCUPIED MODI

UNOCCUPIED MODE
DEMAND FOR UNOCCUPIED PERIOD HEATING/COOLING SHALL OPERATE AS DESCRIBED IN OCCUPIED MODE. UNOCCUPIED HEATING SETPOINTS SHALL BE 10 DEGREES LOWER AND COOLING SHALL BE 10 DEGREES HIGHER THAN OCCUPIED SETPOINTS. UNIT IS EXPECTED TO OPERATE 24 HOURS A DAY TO PROVIDE MAKEUP AIR TO THE FUME HOOD EXHAUST FAN.



SEQUENCE OF OPERATION

FUME HOOD CONTROL: FUM

FUME HOOD CONTROL: FUME HOODS ARE CONSTANT VOLUME WITH A SASH BYPASS.

FUME HOOD AND LAB ARE EXPECTED TO OPERATE IN OCCUPIED MODE 24/7

OCCUPIED MODE: THE EXHAUST FAN SHALL MAINTAIN MAXIMUM SCHEDULED CFM.

FAILURE OF EXHAUST FAN SHALL ALARM THE BAS

UNOCCUPIED MODE: THE EXHAUST FAN SHALL BE OFF



N.T.S.



THESE DOCUMENTS HAVE BEEN PRODUCED AS AN INSTRUMENT OF SERVICE AND ARE INTENDED SOLELY FOR THE PURPOSE OF CONSTRUCTING, USING AND MAINTAINING THE PROJECT. KNIIT AS THE ARCHITECT OF RECORD FOR THE PROJECT RETAINS OWNERSHIP OF THESE DOCUMENTS.

ANY USE OF THESE DOCUMENTS OR USE OF THIS DESIGN, IDEAS OR CONCEPTS DESCRIBED HEREIN IN WHOLE OR PART BY ANY MEANS WHATSOEVER IS STRICTLY PROHIBITED EXCEPT BY WRITTEN CONSENT OF KNIIT.

REPRODUCTION OF THIS DOCUMENTS IS STRICTLY PROHIBITED EXCEPT BY WRITTEN CONSENT OF KNIIT.



ISSUE DATE: 07.21.2025


REV	DATE	COMMENT
A	7/21/2025	Owner Revisions



8860 IDAHO AVE, MOSCOW, ID 83844


JOB NO: **240004**
CAPITAL PROJECT NO: **CP220034**

PD2-11

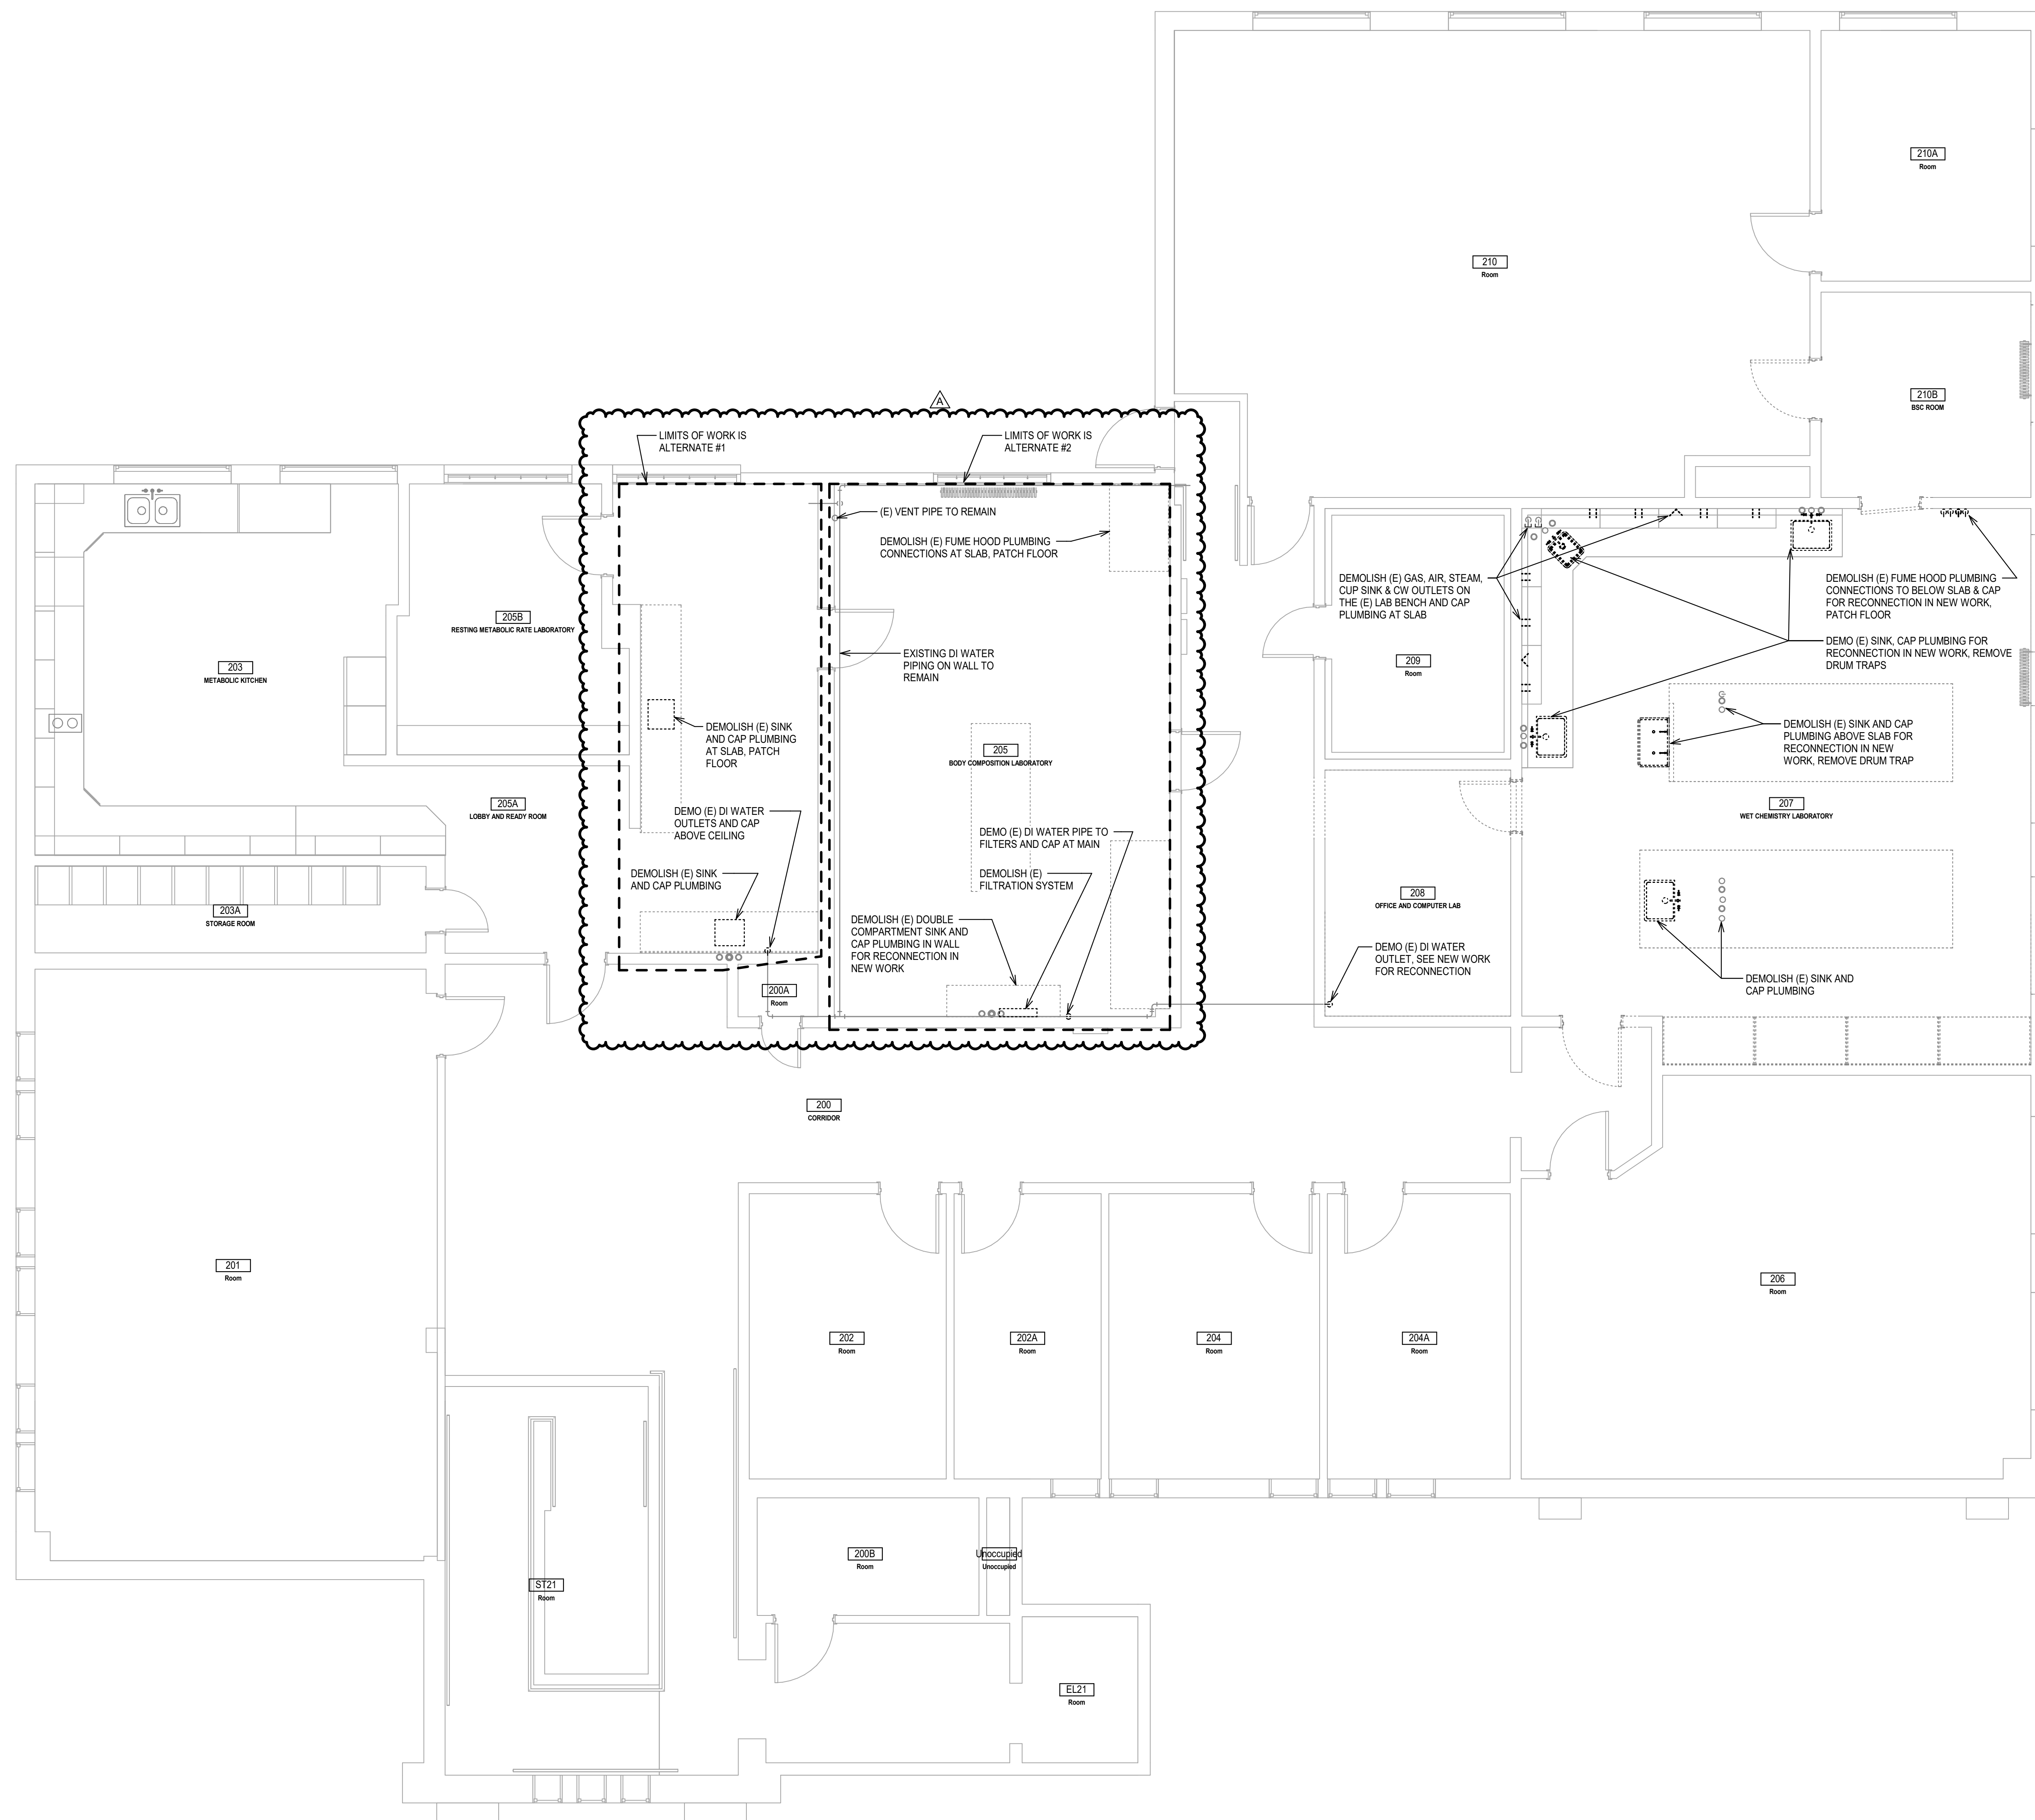


LEVEL 2 - DEMOLITION PLAN - PLUMBING

$$\frac{1}{4}'' = 1'-0''$$

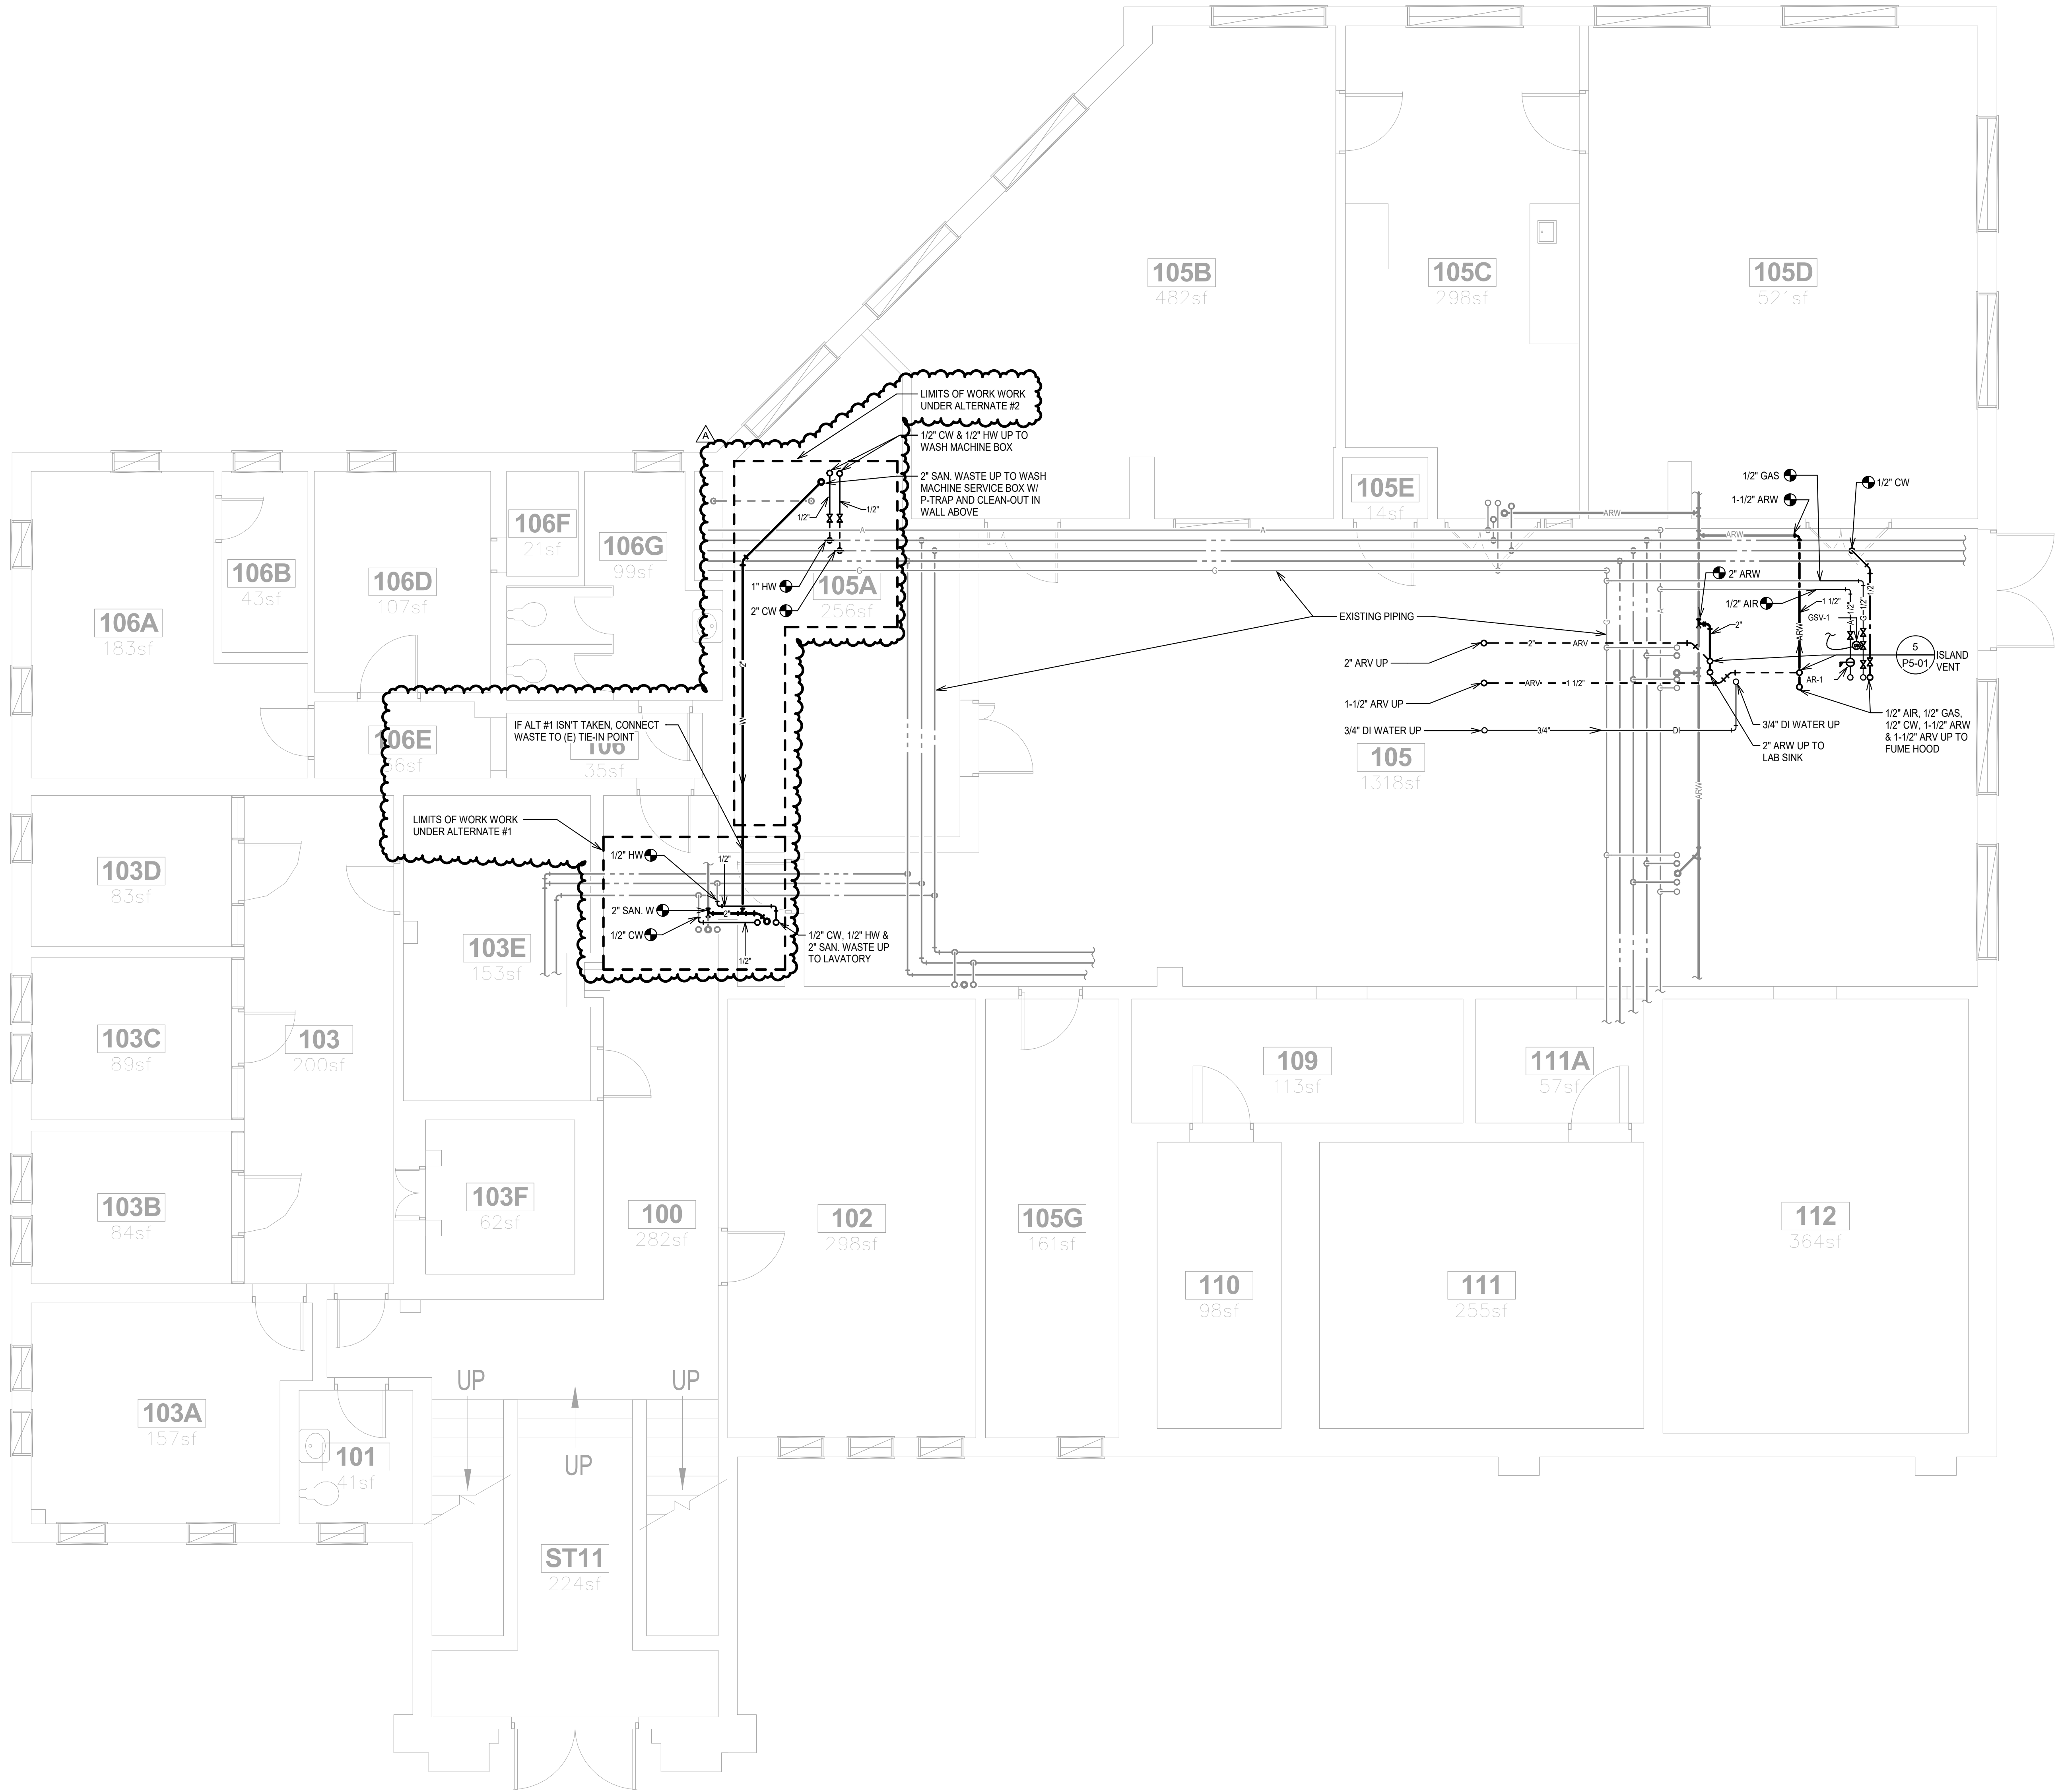


GENERAL NOTES:
1. ALL WASTE PIPING 4" AND LARGER IN SIZE SHALL SLOPE AT 1% GRADE.
2. ALL WASTE PIPING 3" AND LESS IN SIZE SHALL SLOPE AT 2% GRADE.
3. ALL VENT PIPING SHALL SLOPE AT 1% GRADE OR FLAT.
4. ALL PLUMBING FIXTURES SHALL BE PROVIDED WITH WATER HAMMER ARRESTORS WHETHER INDICATED ON PLANS OR DETAILS OR NOT PER DIV. 22 SPECIFICATIONS.

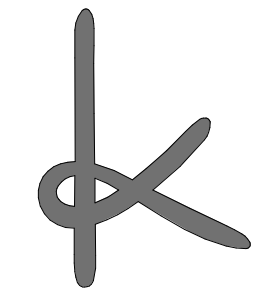

KNIT
knitstudios.com


THESE DOCUMENTS HAVE BEEN PRODUCED AS AN INSTRUMENT OF SERVICE AND ARE INTENDED SOLELY FOR THE PURPOSES OF CONSTRUCTING, USING AND MAINTAINING THE PROJECT. KNIT AS THE ARCHITECT OF RECORD FOR THE PROJECT RETAINS OWNERSHIP OF THESE DOCUMENTS. ANY USE OF THESE DOCUMENTS OR USE OF THE DESIGN IDEAS OR CONCEPTS DESCRIBED HEREIN IN WHOLE OR IN PART BY ANY MEANS WHATSOEVER IS STRICTLY PROHIBITED EXCEPT BY WRITTEN CONSENT OF KNIT. REPRODUCTION OF THIS DOCUMENT IS STRICTLY PROHIBITED EXCEPT BY WRITTEN CONSENT OF KNIT.



MW Engineers
601 W First Ave, Ste 1300
Snohomish, WA 98290, USA
509.836.8020
mwengineers.com

ISSUE DATE: **07.21.2025**

REV	DATE	COMMENT
A	7/21/2025	Owner Revisions

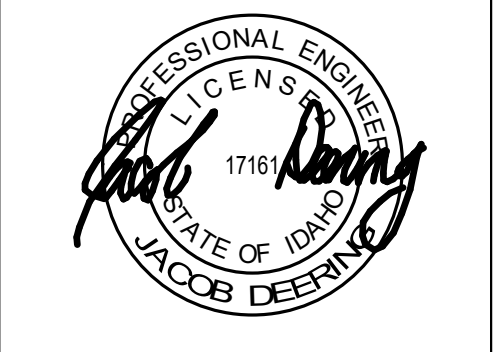


LEVEL 1 FLOOR PLAN - PLUMBING


FOOD RESEARCH CENTER TI - PHASE 1 (BUILDING #: 005)

860 IDAHO AVE, MOSCOW, ID 83844

UNIVERSITY OF IDAHO

 **LEVEL 1 - PLUMBING**
1/4" = 1'-0"

TITLE	PROJECT	CLIENT
JOB NO: 240004 CAPITAL PROJECT NO: CP220034		
P2-10		

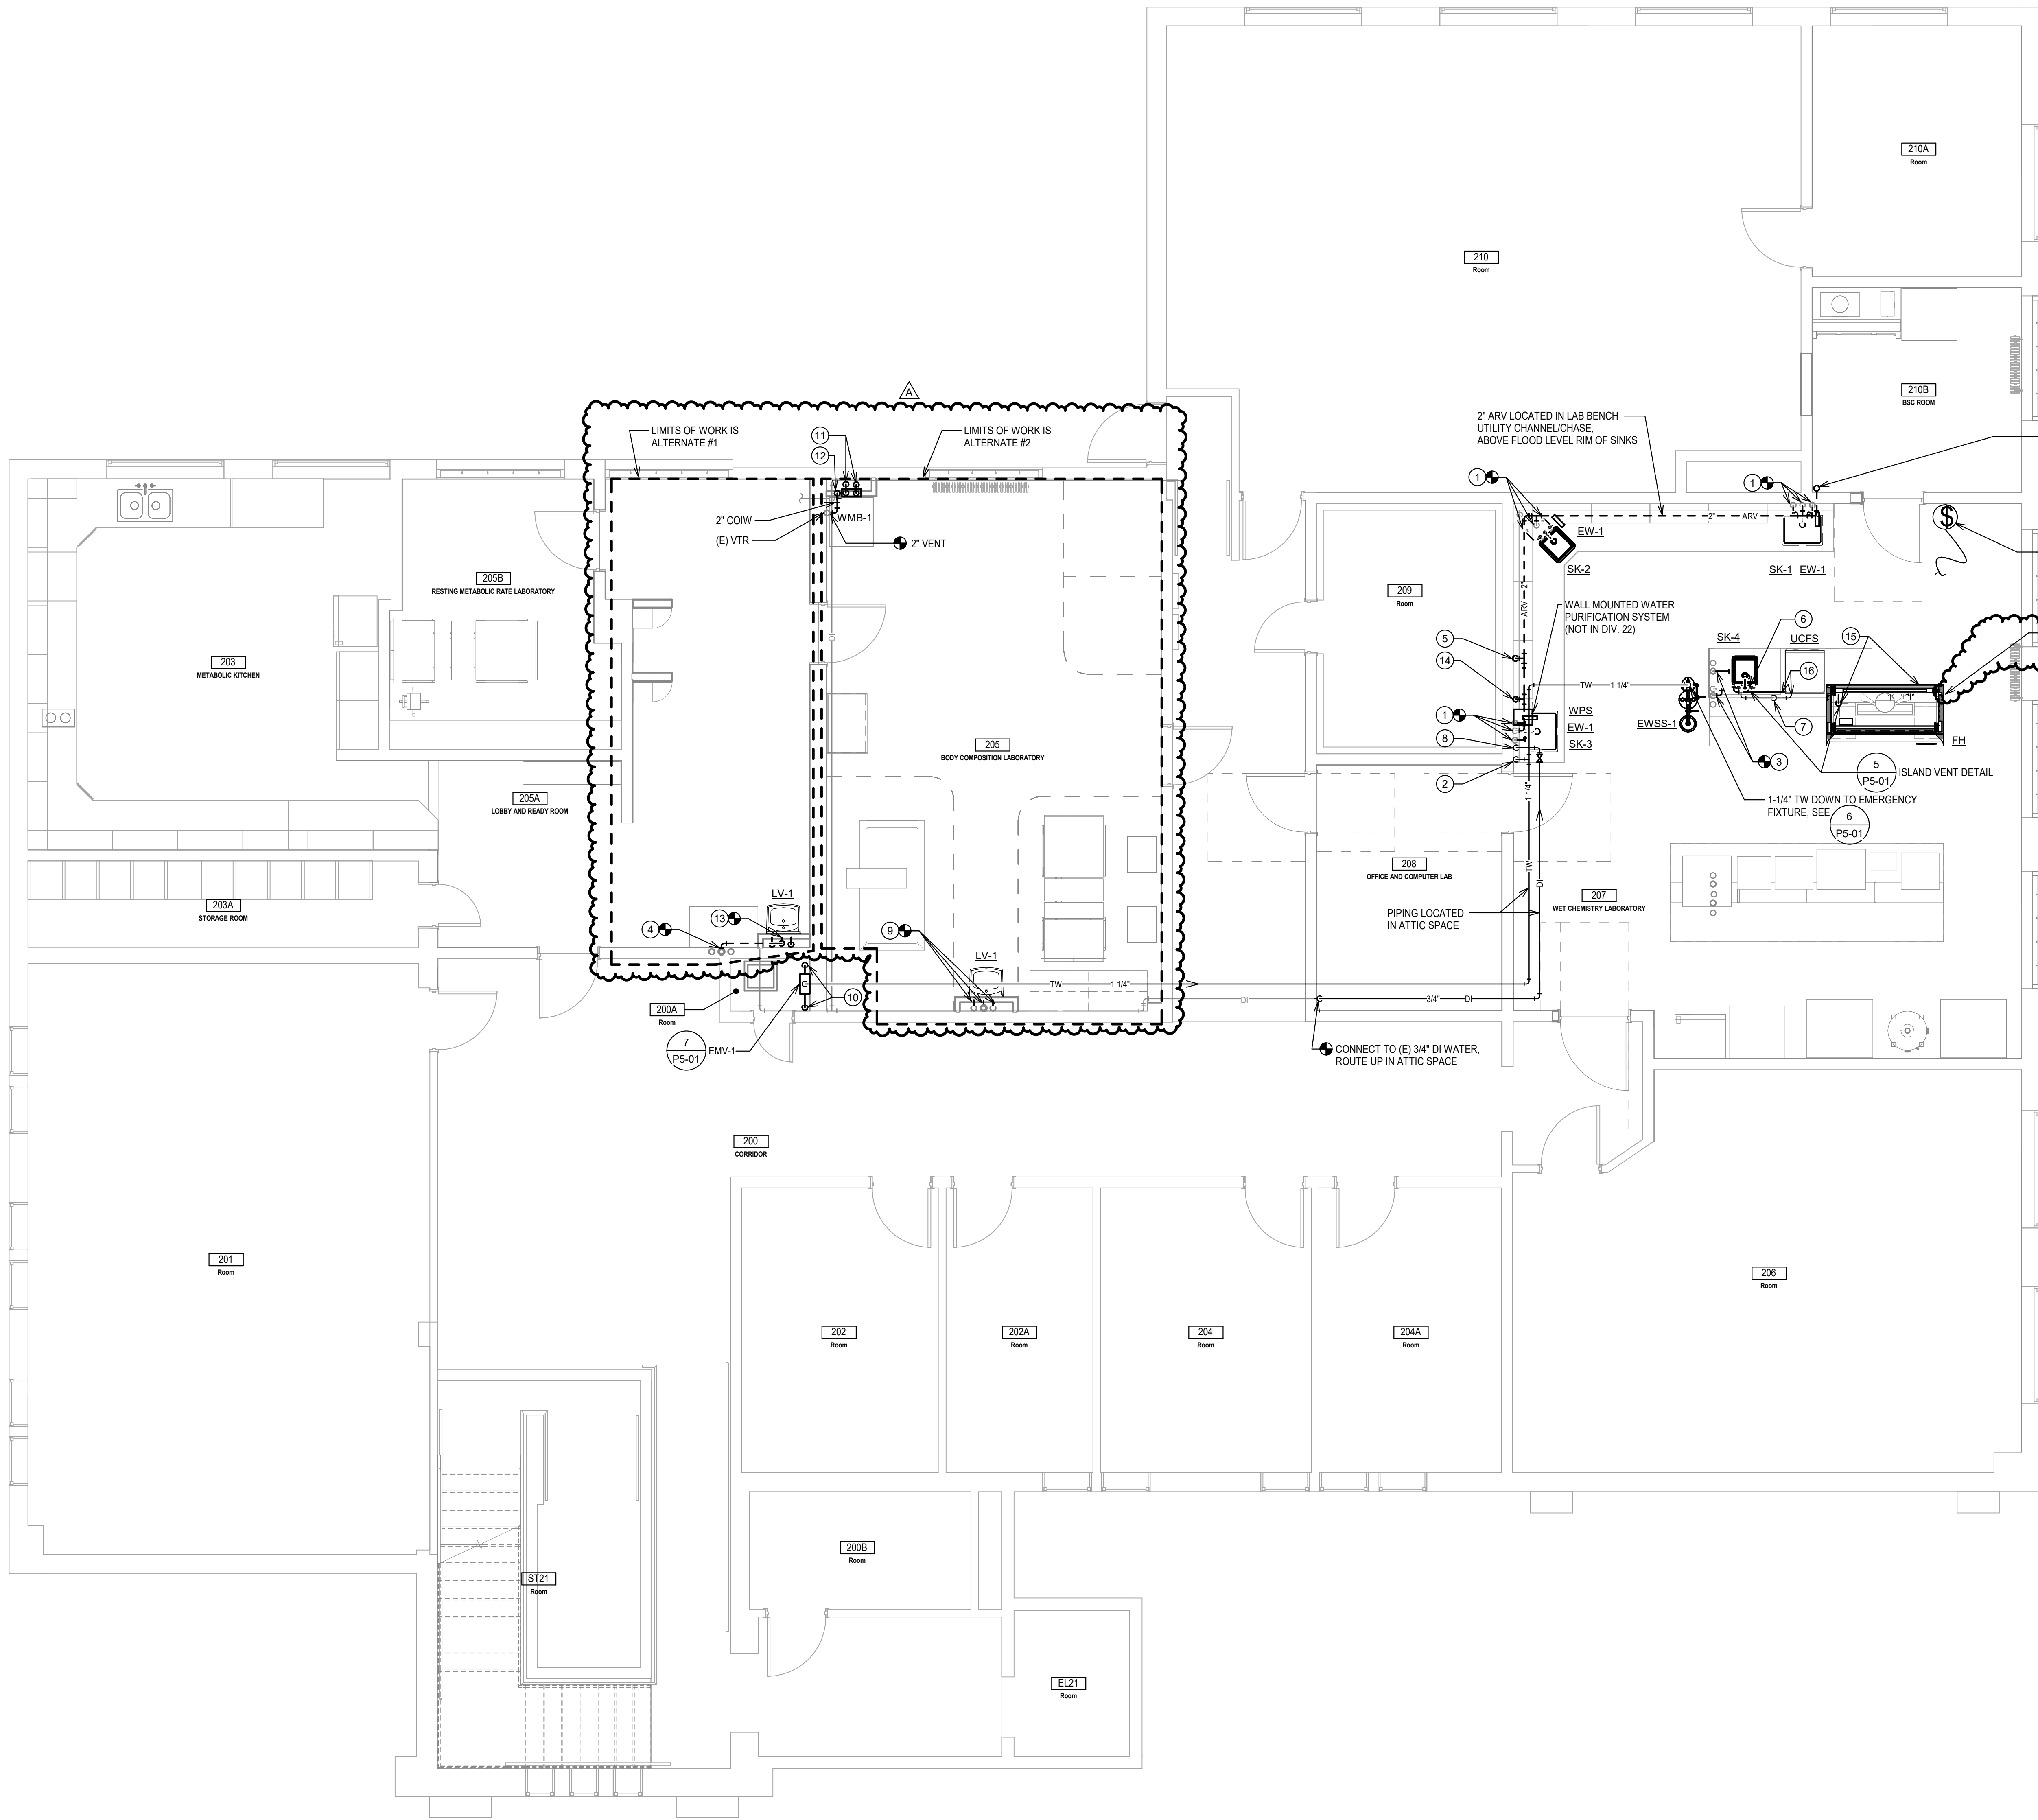


GENERAL NOTES:

1. ALL WASTE PIPING 4" AND LARGER IN SIZE SHALL SLOPE AT 1% GRADE.
2. ALL WASTE PIPING 3" AND LESS IN SIZE SHALL SLOPE AT 2% GRADE.
3. ALL VENT PIPING SHALL SLOPE AT 1% GRADE OR FLAT.
4. ALL PLUMBING FIXTURES SHALL BE PROVIDED WITH WATER HAMMER ARRESTORS WHETHER INDICATED ON PLANS OR DETAILS OR NOT PER DIV. 22 SPECIFICATIONS.

ISSUE DATE: 07.21.2025

REV	DATE	COMMENT
A	7/21/2025	Owner Revisions

- KEY NOTES:
1. CONNECT NEW LAB SINK TO EXISTING 1/2" CW, 1/2" HW & 1-1/2" ARW IN LAB BENCH. PROVIDE NEW WATER SUPPLY STOPS. PROVIDE NEW ARV ROUTED THRU ROOF IN LIEU OF EXISTING DRUM TRAPS.
 2. 1/2" TW DOWN ON WALL AND ROUTED INSIDE LAB BENCH CABINET SPACE W/ 1/2" TW TO EACH EMERGENCY EYEWASH.
 3. CONNECT NEW LAB SINK TO EXISTING 1/2" CW & 1/2" HW UNDER LAB BENCH. PROVIDE NEW 2" ARW AND 2" ACID RESISTANT ISLAND VENT THRU ROOF IN ATTIC SPACE.
 4. CONNECT NEW 1-1/2" VENT FROM LAVATORY TO EXISTING VENT THRU ROOF IN ATTIC SPACE.
 5. 2" ARV DOWN THRU FLOOR.
 6. 2" ARV ISLAND VENT DOWN THRU FLOOR.
 7. 3/4" DI WATER DOWN THRU FLOOR.
 8. 3/4" DI WATER DOWN ON WALL TO BELOW LAB BENCH. ROUTE 3/4" DI WATER TO WATER PURIFICATION SYSTEM AND 3/4" DI WATER CONTINUING DOWN IN LAB BENCH CABINET SPACE TO BELOW FLOOR.
 9. CONNECT NEW LAVATORY TO EXISTING 1/2" CW, 1/2" HW, 1-1/2" VENT & 2" WASTE IN WALL. PROVIDE NEW WATER SUPPLY STOPS. ROUTE & CONNECT NEW 3/4" CW & 3/4" HW TO NEAREST (E) 3/4" HW & CW PIPES.
 10. 1/2" CW & 1/2" HW DOWN IN CHASE THRU FLOOR.
 11. 1/2" CW, 1/2" HW & 2" VENT DOWN IN WALL TO WASH MACHINE BOX. PROVIDE 2" WASTE OUTLET FROM BOX W/ P-TRAP IN WALL.
 12. 1/2" CW, 1/2" HW & 2" WASTE UP FROM BELOW SLAB TO LAVATORY.
 13. 1-1/2" ARV DOWN THRU FLOOR.
 14. 1/2" AIR, 1/2" GAS, 1/2" CW, 1-1/2" ARW & 1-1/2" ACID RESISTANT ISLAND VENT UP THRU FLOOR TO FUME HOOD UTILITY CHASE.
 15. EXTEND 1/2" DI WATER AND 1/2" HW TO FLASK SCRUBBER.

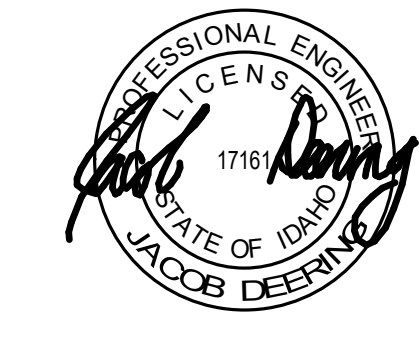

LEVEL 2 FLOOR PLAN - PLUMBING


FOOD RESEARCH CENTER TI - PHASE 1 (BUILDING #: 005)

860 IDAHO AVE, MOSCOW, ID 83844

UNIVERSITY OF IDAHO

TITLE	PROJECT	CLIENT
JOB NO: 240004 CAPITAL PROJECT NO: CP220034		

P2-11

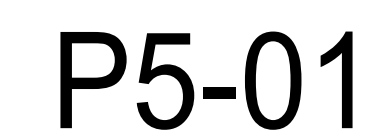

PLUMBING FIXTURE SCHEDULE																							
NOTES: 1. VERIFY SIZES ON SITE AND COORDINATE INSTALLATION IN EXISTING COUNTERTOP & CASEWORK, SEE DETAIL 2 ON P5-01 2. PROVIDE NEW BRASSCRAFT STOPS & SUPPLIES (KTSOR19X-C)								3. PROVIDE WITH CHICAGO FAUCETS 131-ABNF THERMOSTATIC MIXING VALVE & TRUEBRO LAV SHIELD #82202 4. DI WATER FAUCET: WATERSAVER L694-LH "LAV GUARD 2 E-Z SERIES" ADA SCALD PROTECTION AND DISHWASHER AIRGAP KIT.															
TAG	FIXTURE DESCRIPTION	MANUFACTURER	MODEL	MOUNTING	FIXTURE TYPE	MATERIAL	SIZE	MFR & MODEL # OF FAUCET & VALVE	DRAIN TYPE	TRAP	CARRIER	ACCESSORIES	WASTE	VENT	HW	CW	ARW	ARV	DI WATER	TW	ELECTRICAL REMARKS	SUPPLIES	NOTES
EW-1	EMERGENCY EYEWASH	GUARDIAN	G5022BP-FSH	DECK	DRENCH HOSE	BRASS & NYLON	10-1/8" TALL	INTEGRAL	-	-	-	8 FT. FLEXIBLE ST. STL. HOSE	-	-	-	-	-	-	-	1/2"	-	BRASSCRAFT KTSOR19X-C	5 GPM, ROUTE TW FROM MIXING VALVE MV-1
EWSS-1	EMERGENCY EYEWASH & SAFETY SHOWER	ULINE	H-6697	FREE STANDING	SHOWER/EYE WASH COMBO	POWDER COATED STEEL & PLASTIC	94-3/4" TALL	INTEGRAL	-	1-1/2" x 17 GA.	-	-	-	-	-	-	-	-	-	1-1/4"	-	-	25 GPM, ROUTE TW FROM MIXING VALVE MV-1
LV-1	ADA LAVATORY	KOHLER	"GREENWICH" K-2031	WALL	SELF-DRAINING DECK	VITREOUS CHINA	20-3/4"x18-1/4"x12-7/8"	CHICAGO FAUCETS 116.858.AB.1	ELKAY LK174	1-1/2" x 17 GA.	JAY R SMITH 0710	NOTE 3	2"	1-1/2"	1/2"	1/2"	-	-	-	1/2"	PROVIDE WITH BATTERIES	BRASSCRAFT KTSOR19X-C	INSTALL PER ADA REQUIREMENTS. <u>UNDER ALTERNATE #1 & 2</u>
SK-1	LAB SINK	DURCON	U52	IN EXISTING COUNTERTOP	UNDERMOUNT	EPOXY	23.-2/3"x17-2/3"x10-3/4"	WATERSAVER L414	DURCON STRAINER	BOTTLE TRAP SPEARS CPVC DILUTION TANK	-	-	-	-	1/2"	1/2"	1-1/2"	1-1/2"	-	-	-	NOTE 2	NOTE 1
SK-2	LAB SINK	DURCON	U20	IN EXISTING COUNTERTOP	UNDERMOUNT	EPOXY	16"x16"x7-1/2"	WATERSAVER L414	DURCON STRAINER	BOTTLE TRAP SPEARS CPVC DILUTION TANK	-	-	-	-	1/2"	1/2"	1-1/2"	1-1/2"	-	-	-	NOTE 2	NOTE 1
SK-3	LAB SINK	DURCON	U52	IN EXISTING COUNTERTOP	UNDERMOUNT	EPOXY	23.-2/3"x17-2/3"x10-3/4"	WATERSAVER L414	DURCON STRAINER	BOTTLE TRAP SPEARS CPVC DILUTION TANK	-	DI WATER FAUCET: WATERSAVER L691-LH	-	-	-	1/2"	1/2"	1-1/2"	1-1/2"	1/2"	-	NOTE 2	NOTE 1, CONNECT DI WATER FAUCET TO ADJACENT WATER PURIFICATION SYSTEM
SK-4	ADA LAB SINK	DURCON	U20	COUNTERTOP	UNDERMOUNT	EPOXY	16"x16"x7-1/2"	WATERSAVER L414-BH	DURCON STRAINER	BOTTLE TRAP SPEARS CPVC DILUTION TANK	-	NOTE 4	-	-	-	1/2"	1/2"	1-1/2"	1-1/2"	1/2"	-	NOTE 2	NOTE 1, INSTALL PER ADA REQUIREMENTS
WMB-1	WASH MACHINE SERVICE BOX	GUY GRAY	MWB13	WALL	RECESSED IN WALL	POWDER COATED STEEL	10-7/8"x8-3/8"	QUARTER TURN VALVES	OPEN HUB	2"x17 GA STANDPIPE	-	-	2"	2"	1/2"	1/2"	-	-	-	-	-	-	SEE DETAIL 3, SHEET P5-01. <u>UNDER ALTERNATE #2</u>

SOLENOID VALVE SCHEDULE							MFR BASIS OF DESIGN: ASCO
SYMBOL	MANUFACTURER	CATALOG NO.	SIZE	OPERATION	SERVICE	ELECTRICAL	NOTES
GSV-1	ASCO	SERIES 8040	1/2"	NORMALLY CLOSED	NAT-GAS (SERVES LAB GAS OUTLETS AS INDICATED ON PLANS)	120V / 60Hz / 15W / 1 AMP	①②③
NOTES:							
① VALVE SHALL BE LINE SIZE		③ PROVIDE W/ AMERICAN GAS SAFETY MODEL "AGSEGOTV" EMERGENCY GAS SHUT OFF PUSH BUTTON WITH TWIST-RESET					
② VALVE IS OPEN WHEN ENERGIZED; CLOSED WHEN DE-ENERGIZED							

WATER HAMMER ARRESTER SIZING CHART			
SYMBOL	FIXTURE UNIT RATING	JAY R. SMITH FIG. NO.	CONNECTION TO SUPPLY PIPE
WHA-1	1-11	5005	3/4"
WHA-2	12-32	5010	1"
WHA-3	33-60	5020	1"
NOTE: WATER HAMMER ARRESTERS SHALL BE SIZED AND INSTALLED IN ACCORDANCE WITH MANUFACTURER'S REQUIREMENTS AND IN ACCORDANCE WITH THIS SCHEDULE. INSTALL WATER HAMMER ARRESTERS AT ALL QUICK CLOSING VALVES, SOLENOID VALVES, EACH PLUMBING FIXTURE AND AT EACH BATTERY OF FIXTURES IN DOMESTIC HOT AND COLD WATER SYSTEMS.			

LAB EQUIPMENT CONNECTION SCHEDULE												
NOTES: EQUIPMENT NOT IN DIV. 22												
TAG	DESCRIPTION	MOUNTING	TRAP	ARW	ARV	HW	CW	GAS	AIR	IW	DI WATER	REMARKS
FH	FUME HOOD	FREE STANDING	BOTTLE TRAP SPEARS CPVC DILUTION TANK	1-1/2"	1-1/2"	-	1/2"	1/2"	1/2"	-	-	SEE DETAIL 1 ON SHEET P5-01
UCFS	UNDERCOUNTER FLASK SCRUBBER	FLOOR	-	-	-	1/2"	-	-	-	3/4"	1/2"	ROUTE IW TO ADJACENT SINK W/ DISHWASHER AIRGAP. PROVIDE SUPPLY HOSE AND STOPS.
WPS	WATER PURIFICATION SYSTEM	WALL	-	-	-	-	-	-	-	-	3/4"	-

EMERGENCY MIXING VALVE SCHEDULE									
MV-#	MFR	MODEL	CW INLET	HW INLET	BW OUTLET	MOUNTING TYPE	MOUNTING HEIGHT	OUTLET TEMPERATURE	NOTES
EMV-1	GUARDIAN	G6042	3/4"	3/4"	1 1/4"	WALL	6" - 0"	85 °F	EMERGENCY MIXING VALVE FOR EMERGENCY SHOWERS, SEE DETAIL 7, SHEET P5-01

AIR PRESSURE REGULATORS SCHEDULE								
TAG	MANUFACTURER	MODEL #	UNIT SIZE (INCHES)	INLET PRESSURE (PSIG)	OUTLET PRESSURE SETTING (PSIG)	REGULATOR CAPACITY (SCFM)	LOAD (SCFM)	NOTES
AR-1	WILKERSON	RB3	1/2"	VERIFY EXISTING	15	14 CFM	1.0	PROVIDE WITH GAUGE



knitstudios.com


THESE DOCUMENTS HAVE BEEN PRODUCED AS AN INSTRUMENT OF SERVICE AND ARE INTENDED SOLELY FOR THE PURPOSES OF CONSTRUCTING, LEASING AND MAINTAINING THE PROJECT. KNIT AS THE ARCHITECT OF RECORD FOR THE PROJECT RETAINS OWNERSHIP OF THESE DOCUMENTS. ANY USE OF THESE DOCUMENTS OR USE OF THE DESIGN IDEAS OR CONCEPTS DESCRIBED HEREIN IN WHOLE OR IN PART BY ANY MEANS WHATSOEVER IS STRICTLY PROHIBITED EXCEPT BY WRITTEN CONSENT OF KNIT. REPRODUCTION OF THIS DOCUMENT IS STRICTLY PROHIBITED EXCEPT BY WRITTEN CONSENT OF KNIT.



MW Engineers
601 W First Ave, Ste 1300
Schaumburg, IL 60196
630.831.2023
mwengineers.com

ISSUE DATE: **07.21.2025**

REV DATE COMMENT
A 7/21/2025 Owner Revisions

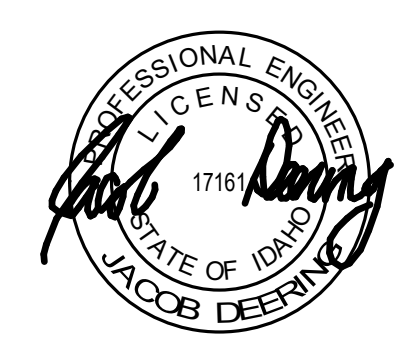

SCHEDULES - PLUMBING

FOOD RESEARCH CENTER T1 - PHASE 1 (BUILDING #: 005)

860 IDAHO AVE, MOSCOW, ID 83844

UNIVERSITY OF IDAHO

TITLE

PROJECT

CLIENT

JOB NO: **240004**

CAPITAL PROJECT NO: **CP220034**

P6-01

ELECTRICAL SPECIFICATIONS

GENERAL

ELECTRICAL WORK SHALL INCLUDE FURNISHING ALL LABOR, MATERIALS, EQUIPMENT, AND SERVICES TO CONSTRUCT AND INSTALL THE COMPLETE ELECTRICAL SYSTEMS AS SHOWN ON THESE DRAWINGS AND DESCRIBED IN THESE SPECIFICATIONS.

CODES, PERMITS AND FEES

THE INSTALLATION OF THIS WORK SHALL COMPLY IN EVERY WAY WITH THE REQUIREMENTS OF ALL APPLICABLE LAWS, ORDINANCES, AND RULES OF THE STATE OF IDAHO, OSHA, THE NATIONAL BOARD OF FIRE UNDERWRITERS, AND THE NATIONAL ELECTRICAL CODE. IF ANY CONFLICT OCCURS BETWEEN THESE RULES AND THIS SPECIFICATION, THE RULES SHALL GOVERN. NOTHING IN THESE DRAWINGS AND SPECIFICATIONS SHALL BE CONSTRUED TO PERMIT WORK NOT CONFORMING WITH GOVERNING CODES. THIS SHALL NOT BE CONSTRUED AS RELIEVING THE CONTRACTOR FROM COMPLYING WITH REQUIREMENTS OF THE PLANS OR SPECIFICATIONS WHICH MAY BE IN EXCESS OF REQUIREMENTS OF HEREIN BEFORE MENTIONED RULES AND NOT CONTRARY TO SAME. OBTAIN AND PAY FOR ALL REQUIRED STATE AND LOCAL INSTALLATION INSPECTIONS. DELIVER ORIGINALS OF THESE CERTIFICATES IN THE OPERATING AND MAINTENANCE INSTRUCTIONS. ALL MATERIALS SHALL BE UL LISTED AND LABELED.

RACEWAYS AND FITTINGS

RIGID METAL CONDUIT (RMC) AND INTERMEDIATE METALLIC CONDUIT (IMC) HEAVY WALL, GALVANIZED STEEL, SCHEDULE 40, THREADED. FITTINGS SHALL BE THREADED GALVANIZED OR CADMIUM PLATED STEEL FITTINGS. ELECTRIC METALLIC TUBING (EMT) SHALL BE GALVANIZED TUBING. FITTINGS: STEEL, RAIN TIGHT COMPRESSION TYPE WITH NYLON INSULATED THROATS ON CONNECTORS OUTDOOR OR 2" AND GREATER. STEEL SET-SCREW TYPE WITH NYLON INSULATED THROATS ON CONNECTORS UNDER 2" AND INDOOR. FLEXIBLE METAL CONDUIT SHALL BE FLEXIBLE, INTERLOCKED, GALVANIZED STEEL CONSTRUCTION, SPIRAL STRIP. FITTINGS AND CONDUIT BODIES: ANSINEMAFB 1. ALL STEEL, GALVANIZED, COMPRESSION TYPE, SPECIFICALLY DESIGNED FOR THE PURPOSE. LIQUID TIGHT FLEXIBLE CONDUIT SHALL BE FLEXIBLE, INTERLOCKED, GALVANIZED STEEL, SPIRAL STRIP WITH AN OUTER LIQUIDTIGHT, NON-METALLIC, SUNLIGHT-RESISTANT JACKET. FITTINGS: PLASTIC CONDUIT SHALL BE SCHEDULE 40 PVC MINIMUM, LISTED, SUNLIGHT RESISTANT, RATED FOR 90 DEGREES C CONDUCTORS.

ELECTRICAL BOXES

SHEET METAL OUTLET BOXES: GALVANIZED STEEL, WITH 3/8" MALE FIXTURE STUDS WHERE REQUIRED. LUMINAIRE AND EQUIPMENT SUPPORTING BOXES: RATED FOR WEIGHT FOR EQUIPMENT SUPPORTED.

PULL AND JUNCTION BOXES

OUTLET, PULL BOXES AND JUNCTION BOXES SHALL BE GALVANIZED STEEL, MINIMUM 4 INCH SQUARE BY 2 1/8" INCHES DEEP FOR USE WITH 1 INCH CONDUIT AND SMALLER, ON CONDUIT SYSTEMS USING 1 1/4" OR LARGER, PULL AND JUNCTION BOXES SHALL BE SIZED PER NEC BUT NOT LESS THAN 4 11/16" SQUARE. OUTLET BOXES OUTDOORS SHALL BE CAST METAL WITH THREADED BUSH. PROVIDE DIE-CAST RINGS, SIZE AS REQUIRED. FOR TELECOMMUNICATION, SECURITY, AND OTHER LOW VOLTAGE CABLE INSTALLATIONS, THE BOXES SHALL BE A 4 11/16" SQUARE BOX WITH SINGLE GANG MUDDING AND BLANK COVERPLATE.

WIRE AND CABLE

SINGLE CONDUCTOR, TYPE THHN/TWN OR XHHW INSULATION, RATED 600 VOLTS, SPLIT BOLT CONNECTORS ARE NOT ACCEPTABLE. NO CONDUCTOR LESS THAN 10 AWG SHALL BE INSTALLED IN EXTERIOR UNDERGROUND CONDUIT. ALL CONDUCTORS #1 AND SMALLER SHALL BE COPPER.

METAL-CLAD CABLE

METAL-CLAD CABLE SHALL BE TYPE MC PRE-MANUFACTURED CABLE ASSEMBLIES CONSISTING OF COLOR-CODED PHASE, NEUTRAL, AND GROUND CONDUCTORS BUNDLED TOGETHER WITH AN OUTER COVERING OF METAL CLADDING. METAL-CLAD CABLE INSTALLED IN PATIENT VICINITY SHALL BE HEALTHCARE GRADE WITH REDUNDANT EQUIPMENT GROUND CONDUCTOR.

DEVICES

HUBBELL, PASS AND SEYMOUR, BRYANT, LEVITON, OR APPROVED EQUAL. ALL WIRING DEVICES SHALL COMPLY WITH NEMA STANDARD WD-1, "HEAVY DUTY WIRING DEVICES" AND UL 20 STANDARDS. COLOR SHALL BE IVORY.
A. 16A DUPLEX RECEPTACLE: HUBBELL 5302
B. 20A DUPLEX RECEPTACLE: HUBBELL 5302
C. GFCI RECEPTACLE: HUBBELL GF-3252
D. SINGLE POLE SWITCH: HUBBELL 1221.

INSTALL WALL SWITCHES 48" TO CENTER ABOVE FLOOR. INSTALL CONVENIENCE RECEPTACLES 48" ABOVE FLOOR TO CENTER, 6" TO CENTER. INSTALL WITH GROUNDING PIN UP.

WALL PLATES

INDOOR DEVICES SHALL HAVE RAISED INDUSTRIAL COVERPLATES. OUTDOOR DEVICES SHALL HAVE GASKETED CAST METAL HINGED COVER.

SUPPORTING STRUCTURES

STEEL CHANNEL SUPPORTS: GALVANIZED OR PAINTED STEEL. DESIGN SUPPORTS TO CARRY WEIGHT OF EQUIPMENT AND CONDUIT, INCLUDE WIRING.

GROUNDING

PROVIDE AN INSULATED THROAT BUSHING ON THE CONDUIT PASSING THRU EACH METAL ENCLOSURE. PROVIDE A BONDING JUMPER CONNECTING THE BUSHING TO THE GROUND BUS AND METAL FRAME OF THE EQUIPMENT. PROVIDE COPPER EQUIPMENT GROUNDING TERMINAL BAR IN ALL NEW PANELBOARDS. WHERE GROUNDING CONDUCTORS TERMINATE, BOND TO THE GROUNDING BUSHING ON THE CONDUIT FEEDING THE PANELBOARD.

ELECTRICAL DISTRIBUTION EQUIPMENT

PANELBOARDS, ENCLOSED SWITCHES AND MOTOR CONTROLLERS SHALL BE MANUFACTURED IN ACCORDANCE WITH APPLICABLE UL STANDARD. MANUFACTURERS: SQUARE D

DEMOLITION:

INACTIVE AND ABANDONED WIRE AND CABLE, INCLUDING DISCONNECTED CIRCUITS FROM WHICH ALL TERMINAL DEVICES HAVE BEEN ELIMINATED, SHALL BE REMOVED BACK TO THE SOURCE OF SUPPLY. ABANDONED RACEWAY SHALL BE REMOVED. COORDINATE DEMOLITION WITH THE WORK OF OTHER TRADES. MATERIALS REMOVED DURING THE DEMOLITION PHASE OF THE WORK SHALL BE STORED OR PROPERLY DISPOSED OF AS DIRECTED BY THE OWNER. PERFORM CUTTING, DRILLING AND PATCHING REQUIRED TO PERFORM THE WORK. PATCHING MATERIALS SHALL MATCH THE EXISTING MATERIALS.

LIGHTING

AS INDICATED IN THE LIGHTING FIXTURE SCHEDULE, SECURELY MOUNT ALL FIXTURES. PROVIDE ALL ADDITIONAL HANGERS AND SUPPORTING BRACKETS AS NECESSARY TO SECURELY FASTEN AND SUPPORT FIXTURES. DRIVERS SHALL BE AS RECOMMENDED BY THE FIXTURE MANUFACTURER. DRIVERS FOR LED FIXTURES SHALL BE LESS THAN 10% THD, UNLESS OTHERWISE NOTED. LED DRIVER SHALL BE DIMMABLE FROM 100% TO 1% WITH 0-10 VDC CONTROL WITHOUT FLICKER.

LIGHTING CONTROLS

LIGHTING CONTROLS SYSTEM SHALL CONSIST OF LOCAL CONTROL STATIONS, OCCUPANCY SENSOR, DAYLIGHT SENSORS, AND INTERFACING DEVICES FOR A COMPLETE AND FULLY OPERATIONAL SYSTEM CONFORMING TO THE REQUIREMENTS OF THE APPLICABLE ENERGY CODE. LIGHTING CONTROL MANUFACTURER SHALL BE HILIGHT. OCCUPANCY SENSOR: hCM SERIES. PHOTOCCELL SENSOR: hCMB SERIES

FIRE ALARM

FIRE ALARM PRODUCTS SHALL MATCH EXISTING BUILDING DEVICES AND SHALL BE AN EXTENSION OF THE EXISTING BUILDING SYSTEM. EXISTING BUILDING SYSTEM IS SILENT KNIGHT.

TELECOM

COMMUNICATION DEVICES SHALL BE INSTALLED ACCORDING TO THE LATEST VERSION OF THE UI OIT STANDARDS. COMMUNICATION CABLING TO BE INSTALLED ACCORDING TO UI STRUCTURED CABLING STANDARD.

SECURITY SYMBOLS

	CARD READER		SECURITY CAMERA (STANDARD)
	DOOR INTERLOCK		SECURITY CONTROL PANEL
	DOOR POSITION INDICATION SWITCH (INTERRUPTIBLE)		SENSOR REX
	DOOR POSITION INDICATION SWITCH (UNINTERRUPTIBLE)		KEYPAD
	DURESS ALARM (WITH LIGHT)		VSS MONITOR
	DURESS ALARM (WITHOUT LIGHT)		WINDOW BREAKAGE DETECTOR
	ELECTRIC LOCK		
	ELECTRIC LOCK (DEADBOLT)		
	KEYED SWITCH		
	MOTION DETECTOR		
	PUSH BUTTON REX		

FIRE ALARM SYMBOLS

	DOOR HOLD OPEN		MONITOR MODULE
	DUCT SMOKE DETECTOR		OSID BEAM. SEE FLOOR PLANS FOR MOUNTING HEIGHT. OSID-R INDICATES REFLECTOR
	FIRE ALARM CONTROL PANEL		OUTPUT RELAY
	FIRE ALARM ANNUNCIATOR PANEL		SMOKE DETECTOR (CEILING MOUNTED)
	FIRE ALARM SLAVE PANEL		SMOKE DETECTOR (WALL MOUNTED)
	FIRE BELL		SPEAKER (WALL MOUNTED)
	FLOW SWITCH		SPEAKER (CEILING MOUNTED)
	HEAT DETECTOR (CEILING MOUNTED)		SPEAKER STROBE (WALL MOUNTED)
	HEAT DETECTOR (WALL MOUNTED)		SPEAKER STROBE (CEILING MOUNTED)
	HORN (WALL MOUNTED)		STROBE (WALL MOUNTED)
	HORN (CEILING MOUNTED)		STROBE (CEILING MOUNTED)
	MANUAL PULL STATION		STROBE (WALL MOUNTED)
	MICROPHONE		STROBE (CEILING MOUNTED)

ADDENDUM 2:

2.2 Question: Clarify spec for electrical panel in the bench. Demolition/Response: Demolish existing load center back to source. Demolish associated conduits and breakers.

2.5 Question: There was a request for the specification (make/model) for the raceway above the cabinets in room 207. Will it be the 4000 series, like they have put in on other projects at the university. Response: Match University of Idaho Standards. 4000 series is acceptable.

2.9 Question: Are the panels in the corridor included in base bid? Response: Yes, panels L2B and L2C are to be included in the base bid.

2.14 Question: Does the existing building Fire Alarm FACP have the capacity to expand to accept the Initiation and Notification devices being added during this renovation? Does the Existing building Fire Alarm FACP have sufficient Standby Battery power to accept the additional devices being added? Are the existing Fire Alarm plans available and could we get a copy. Response: The existing panel has capacity for the proposed scope. Existing plans, if available, will be provided to the selected contractor.

ADDENDUM 3:

3.1 Question: Reference ED2-11 room 207 plans show to demo receptacles on north and west walls. Sheet E2-11 shows installing surface mount raceway with devices. At the walk through it was discussed that they thought the existing devices were just needed to be replaced – please clarify. Response: Remove existing devices and replace with new devices above counter. No need for new surface mount raceway if the counter is not being demolished.

3.2 Question: Who is responsible for data cabling? U of I, System Tech or others? Response: The UI OIT Department.

3.3 Question: Is there a telecom closet on the 2nd floor for cabling to terminate in or do all cable run to the basement? Response: As far as we are aware, there is not a second-floor telecom room. All cables run down to the first-floor telecom rack from the second-floor janitors' closet.

3.4 Question: Reference TR-01 shows raceway from basement to 2nd floor. Does this raceway go straight up, or does it offset somewhere? Need floor details as to where conduit is to be placed. Response: Conduit goes straight up from the telecom rack on the first floor. See sheet E4-01 for more information.

3.5 Question: U of I standards are for stub up for data to accessible ceiling. All ceilings in these locations have a hard ceiling and the only access is a small access hatch above and a lab below. If we go up, where do we terminate the conduits? If we go down, where do we terminate? Response: There is a 3-foot attic space above the hard lid to terminate the conduits.

3.6 Question: Sheet E01-01 says metal clad conduit is acceptable. Typical U of I specs states for whips only. Response: That is correct. Per UI Standards MC cable is only allowed for lighting whips.

3.7 Question: When at the walk through, we were shown (1) access hatch. Is that the only one? It is small. Do we know the height of space above ceiling? Response: As far as we are aware, that is the only access hatch. The space above the hard lid is an attic approximately 3 feet of clear space.

3.8 Question: Are all additional wiring devices to be installed in wire mold or is EMT acceptable? Response: EMT is acceptable for additional wiring devices. Per UI standards, all conduit to be 3/4" or greater.

3.9 Question: Reference EL5-02 plans show a complete lighting system. Is this what is to be installed? Is there an existing system in the building that we tie into? Response: The detail on sheet EL5-02 is a typical detail. The new lights are to be integrated into the existing system.

SCHEMATIC SYMBOLS

	AMP METER		FUSE
	AUTOMATIC TRANSFER SWITCH		FUSIBLE SWITCH
	AUTOMATIC TRANSFER SWITCH (4-POLE BYPASS ISOLATION)		GENERATOR
	CIRCUIT BREAKER		GROUND
	CIRCUIT BREAKER (GFI)		GROUNDING WYE
	INDICATES A BREAKER WITH A 1600 AMP FRAME AND A 1200 AMP TRIP SETTING		INDUCTOR
	CONTACT (N.C.)		LINE TAP
	CONTACT (N.O.)		METER
	CONTACT (REMOTE, N.C.)		MOTOR
	CONTACT (REMOTE, N.O.)		PANELBOARD (# INDICATES NAME)
	DISCONNECT SWITCH		PANEL OR CABINET
	ELECTRONIC INTERLOCK		SEPARABLE CONNECTIONS
	ENCLOSED CIRCUIT BREAKER		SPACE IN PANELBOARD
	FEEDER IDENTIFICATION		SWITCH
			SURGE PROTECTION DEVICE
			TRANSFORMER
			VOLT METER

POWER SYMBOLS

	CONDUIT DROP		RECEPTACLE, DUPLEX
	CONDUIT RISE		RECEPTACLE, DUPLEX FLOOR MOUNTED
	DISCONNECT SWITCH		RECEPTACLE, DUPLEX GFI
	DISTRIBUTION PANEL		RECEPTACLE, DUPLEX ISOLATED GROUND
	ELECTRICAL PANEL		RECEPTACLE, DUPLEX SWITCHED
	JUNCTION BOX		RECEPTACLE, DUPLEX STANDBY POWER
	METER		RECEPTACLE, DUPLEX UPS BACKED
	MOTOR		RECEPTACLE, DUPLEX WITH USB
	MOTOR STARTER		RECEPTACLE, QUAD
	MOTOR STARTER (MANUAL)		RECEPTACLE, QUAD FLOOR MOUNTED
	PUSH TYPE SWITCH		RECEPTACLE, FLOORBOX. 'X' INDICATES THE QUANTITY OF DUPLEX OUTLETS TO BE INSTALLED. 'Y' INDICATES THE FLOORBOX TYPE. REFER TO SHEET E00X FOR DETAILS ON EACH TYPE.
	RECEPTACLE, 20 AMP DUPLEX		RECEPTACLE, SINGLE
	RECEPTACLE, CEILING MOUNTED		RECEPTACLE, SPECIAL
	RECEPTACLE, CEILING 20 AMP DUPLEX		RECEPTACLE, SPECIAL FLOOR MOUNTED
	RECEPTACLE, CEILING DUPLEX STANDBY POWER		RECEPTACLE, SPECIAL FLOOR MOUNTED
	RECEPTACLE, CEILING DUPLEX UPS BACKED		RECEPTACLE, SPECIAL FLOOR MOUNTED
	EQUIPMENT TAG. REFER TO EQUIPMENT SCHEDULE SHEET FOR DETAILS.		RECEPTACLE, SPECIAL FLOOR MOUNTED

LIGHTING SYMBOLS

	1'x4' LIGHT		CRITICAL POWER LIGHT
	2'x2' LIGHT		EMERGENCY POWER LIGHT
	2'x4' LIGHT		DAYLIGHT SENSOR
	DOWNLIGHT		VACANCY SENSOR
	EXIT LIGHT		OCCUPANCY SENSOR
	PENDANT LIGHT		PHOTOCCELL SENSOR
	POLE MOUNTED LIGHT		PRIMARY DAYLIGHT ZONE
	STRIP LIGHT		SECONDARY DAYLIGHT ZONE
	TRACK LIGHT		LIGHTING SWITCH (STANDARD)
	WALL MOUNTED EMERGENCY LIGHT		LIGHTING SWITCH (3-WAY)
	WALL SCONCE		LIGHTING SWITCH (4-WAY)
	WALL WASHER		LOW VOLTAGE LIGHTING SWITCH DETAILS - SHOWN ON LOW VOLTAGE LIGHTING DETAIL SHEET
	LIGHT FIXTURE WITH LOWER CASE LETTER INDICATING ZONING FOR LIGHTING CONTROLS		LIGHTING CONTROL PANEL

SYMBOLS & ABBREVIATIONS

GENERAL SYMBOLS

	KEY NOTE		ROOM NAME AND NUMBER
	EQUIPMENT IDENTIFIER		CONNECTION TO EXISTING (# INDICATES EXISTING SIZE)
	DETAIL NUMBER		REVISION NUMBER
	DETAIL REFERENCE SHEET NUMBER		SECTION NUMBER
	DETAIL NUMBER		SECTION REFERENCE
	DETAIL REFERENCE		SHEET NUMBER
	MATCHED SHEET NUMBER		NORTH ARROW
	MATCH LINE REFERENCE		CENTER LINE
	MATCHED SHEET NUMBER		

NOTE: SYMBOLS AND ABBREVIATIONS ON THE DRAWINGS SHALL BE INTERPRETED IN ACCORDANCE WITH THE LEGENDS WHEREVER APPLICABLE. NOT ALL SYMBOLS AND ABBREVIATIONS IN THE LEGENDS ARE NECESSARILY USED FOR THE PROJECT. ALL SIZES ARE IN INCHES, UNLESS OTHERWISE NOTED.

LINEWEIGHT LEGEND

	NEW WORK
	EXISTING TO REMAIN OR NOT IN CONTRACT
	DEMOLITION
	FUTURE WORK

ABBREVIATIONS

Ø	DIAMETER	LSI	INDICATES A BREAKER WITH FULLY ADJUSTABLE LONG TIME, SHORT TIME AND INSTANTANEOUS TRIP CHARACTERISTICS
ABV	ABOVE	LSIA	INDICATES A BREAKER WITH FULLY ADJUSTABLE LONG TIME, SHORT TIME, INSTANTANEOUS AND GROUND FAULT ALARM TRIP CHARACTERISTICS
AFF	ABOVE FINISH FLOOR	LSIG	INDICATES A BREAKER WITH FULLY ADJUSTABLE LONG TIME, SHORT TIME, INSTANTANEOUS AND GROUND FAULT TRIP CHARACTERISTICS
AFG	ABOVE FINISH GRADE	MAX	MAXIMUM
AL	ALUMINUM	MFR	MANUFACTURER
AR	AS REQUIRED	MIN	MINIMUM
ATS	AUTOMATIC TRANSFER SWITCH	MMS	MANUAL MOTOR STARTER
BLDG	BUILDING	MNT	MOUNT(ED)
C	CIRCUIT	(N)	NEW
CCT	CIRCUIT	N	NEUTRAL
CKT	CIRCUIT	NL	NIGHT LIGHT
CLS	CEILING	N.C.	NORMALLY CLOSED
CO	CONDUIT ONLY WITH 1/4" POLYPROPYLENE PULL ROPE	NC	NOT IN CONTRACT
CP	CHROME PLATED	N.O.	NORMALLY OPEN
CT	CURRENT TRANSFORMER	NORM	NORMAL
CU	COPPER	UNO	UNLESS NOTED OTHERWISE
DISC	DISCONNECT	PNL	PANEL
DIST	DISTRIBUTION	QIG	QUAD ISOLATED GROUND
DIV	DIVISION	REQD	REQUIRED
DWG	DRAWING	RM	ROOM
DX	DUPLEX	RM	ROOM
(E)	EXISTING TO REMAIN	RM	ROOM
EA	EACH	RM	ROOM
EM	EMERGENCY	RM	ROOM
FLR	FLOOR, OR FLOOR MOUNTED	RM	ROOM
FT	FEET	RM	ROOM
G	GROUND	RM	ROOM
GA	GAUGE	RM	ROOM
GFI	GROUND FAULT INTERRUPT	RM	ROOM
GND	GROUND	RM	ROOM
H	HIGH	RM	ROOM
HT	HEIGHT	RM	ROOM
IG	ISOLATED GROUND	RM	ROOM
IN	INCHES	RM	ROOM
L	LONG	RM	ROOM
LI	INDICATES A BREAKER WITH FULLY ADJUSTABLE LONG TIME AND INSTANTANEOUS TRIP CHARACTERISTICS	RM	ROOM

ANNOTATION

++X"	MOUNTING HEIGHT (AFF OR AFG)
(n)C-a-b-y-h-k	n = QUANTITY OF CONDUIT
x	= SIZE OF CONDUIT
a	= QUANTITY OF CONDUCTORS
b	= CONDUCTOR WIRE SIZE
c	= QUANTITY OF GROUND
d	= GROUND WIRE SIZE

knitstudios.com

THESE DOCUMENTS HAVE BEEN PRODUCED AS AN INSTRUMENT OF SERVICE AND ARE INTENDED SOLELY FOR THE PURPOSE OF CONTRACTING. LEGAL AND MANAGING THE PROJECT MUST AS THE ARCHITECT OF RECORD FOR THE PROJECT RETAIN OWNERSHIP OF THESE DOCUMENTS.

ANY USE OF THESE DOCUMENTS OR USE OF THE DESIGN IDEAS OR CONCEPTS DESCRIBED HEREIN IN WHOLE OR IN PART BY ANY OTHER PARTY WITHOUT THE WRITTEN CONSENT OF KNIT IS STRICTLY PROHIBITED. REPRODUCTION OF THIS DOCUMENT IS EXPRESSLY PROHIBITED EXCEPT BY WRITTEN CONSENT OF KNIT.

601 W. First Ave., Ste 1200
Salem, VA 25801, USA
508.546.8223
mwengineers.com

ISSUE DATE: 07.21.2025

REV	DATE	COMMENT
A	7/21/2025	Owner Revisions

PROFESSIONAL ENGINEER
STATE OF IDAHO
JOSEPH CLUNNESS

LEGENDS & ABBREVIATIONS - ELECTRICAL

FOOD RESEARCH CENTER TI - PHASE 1 (BUILDING #: 005)

860 IDAHO AVE, MOSCOW, ID 83844

UNIVERSITY OF IDAHO

TITLE

PROJECT

CLIENT

JOB NO: 240004

CAPITAL PROJECT NO: CP220034

E0-01



THESE DOCUMENTS HAVE BEEN PRODUCED AS AN INSTRUMENT OF SERVICE AND ARE INTENDED SOLELY FOR THE PURPOSE OF CONSTRUCTING, USING AND MAINTAINING THE PROJECT. KNIIT AS THE ARCHITECT OF RECORD FOR THE PROJECT RETAINS OWNERSHIP OF THESE DOCUMENTS.


ANY USE OF THESE DOCUMENTS OR USE OF THIS DESIGN, IDEAS OR CONCEPTS DESCRIBED HEREIN IN WHOLE OR PART BY ANY MEANS WHATSOEVER IS STRICTLY PROHIBITED EXCEPT BY WRITTEN CONSENT OF KNIIT.

REPRODUCTION OF THIS DOCUMENTS IS STRICTLY PROHIBITED EXCEPT BY WRITTEN CONSENT OF KNIIT.



ISSUE DATE: 07.21.2025

REV	DATE	COMMENT
A	7/21/2025	Owner Revisions

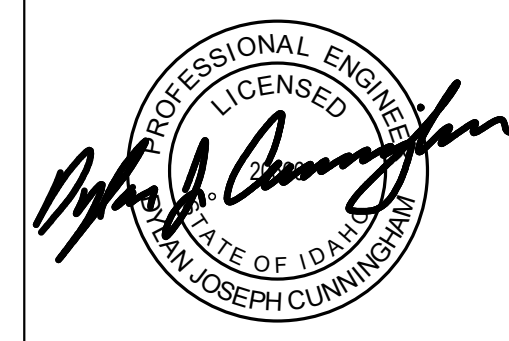

DEMO FLOOR PLAN - ELECTRICAL

FOOD RESEARCH CENTER TI - PHASE 1 (BUILDING #: 005)

8860 IDAHO AVE, MOSCOW, ID 83844

UNIVERSITY OF IDAHO


TITLE

PROJECT

CLIENT

JOB NO: **240004**
CAPITAL PROJECT NO: **CP220034**

ED2-11

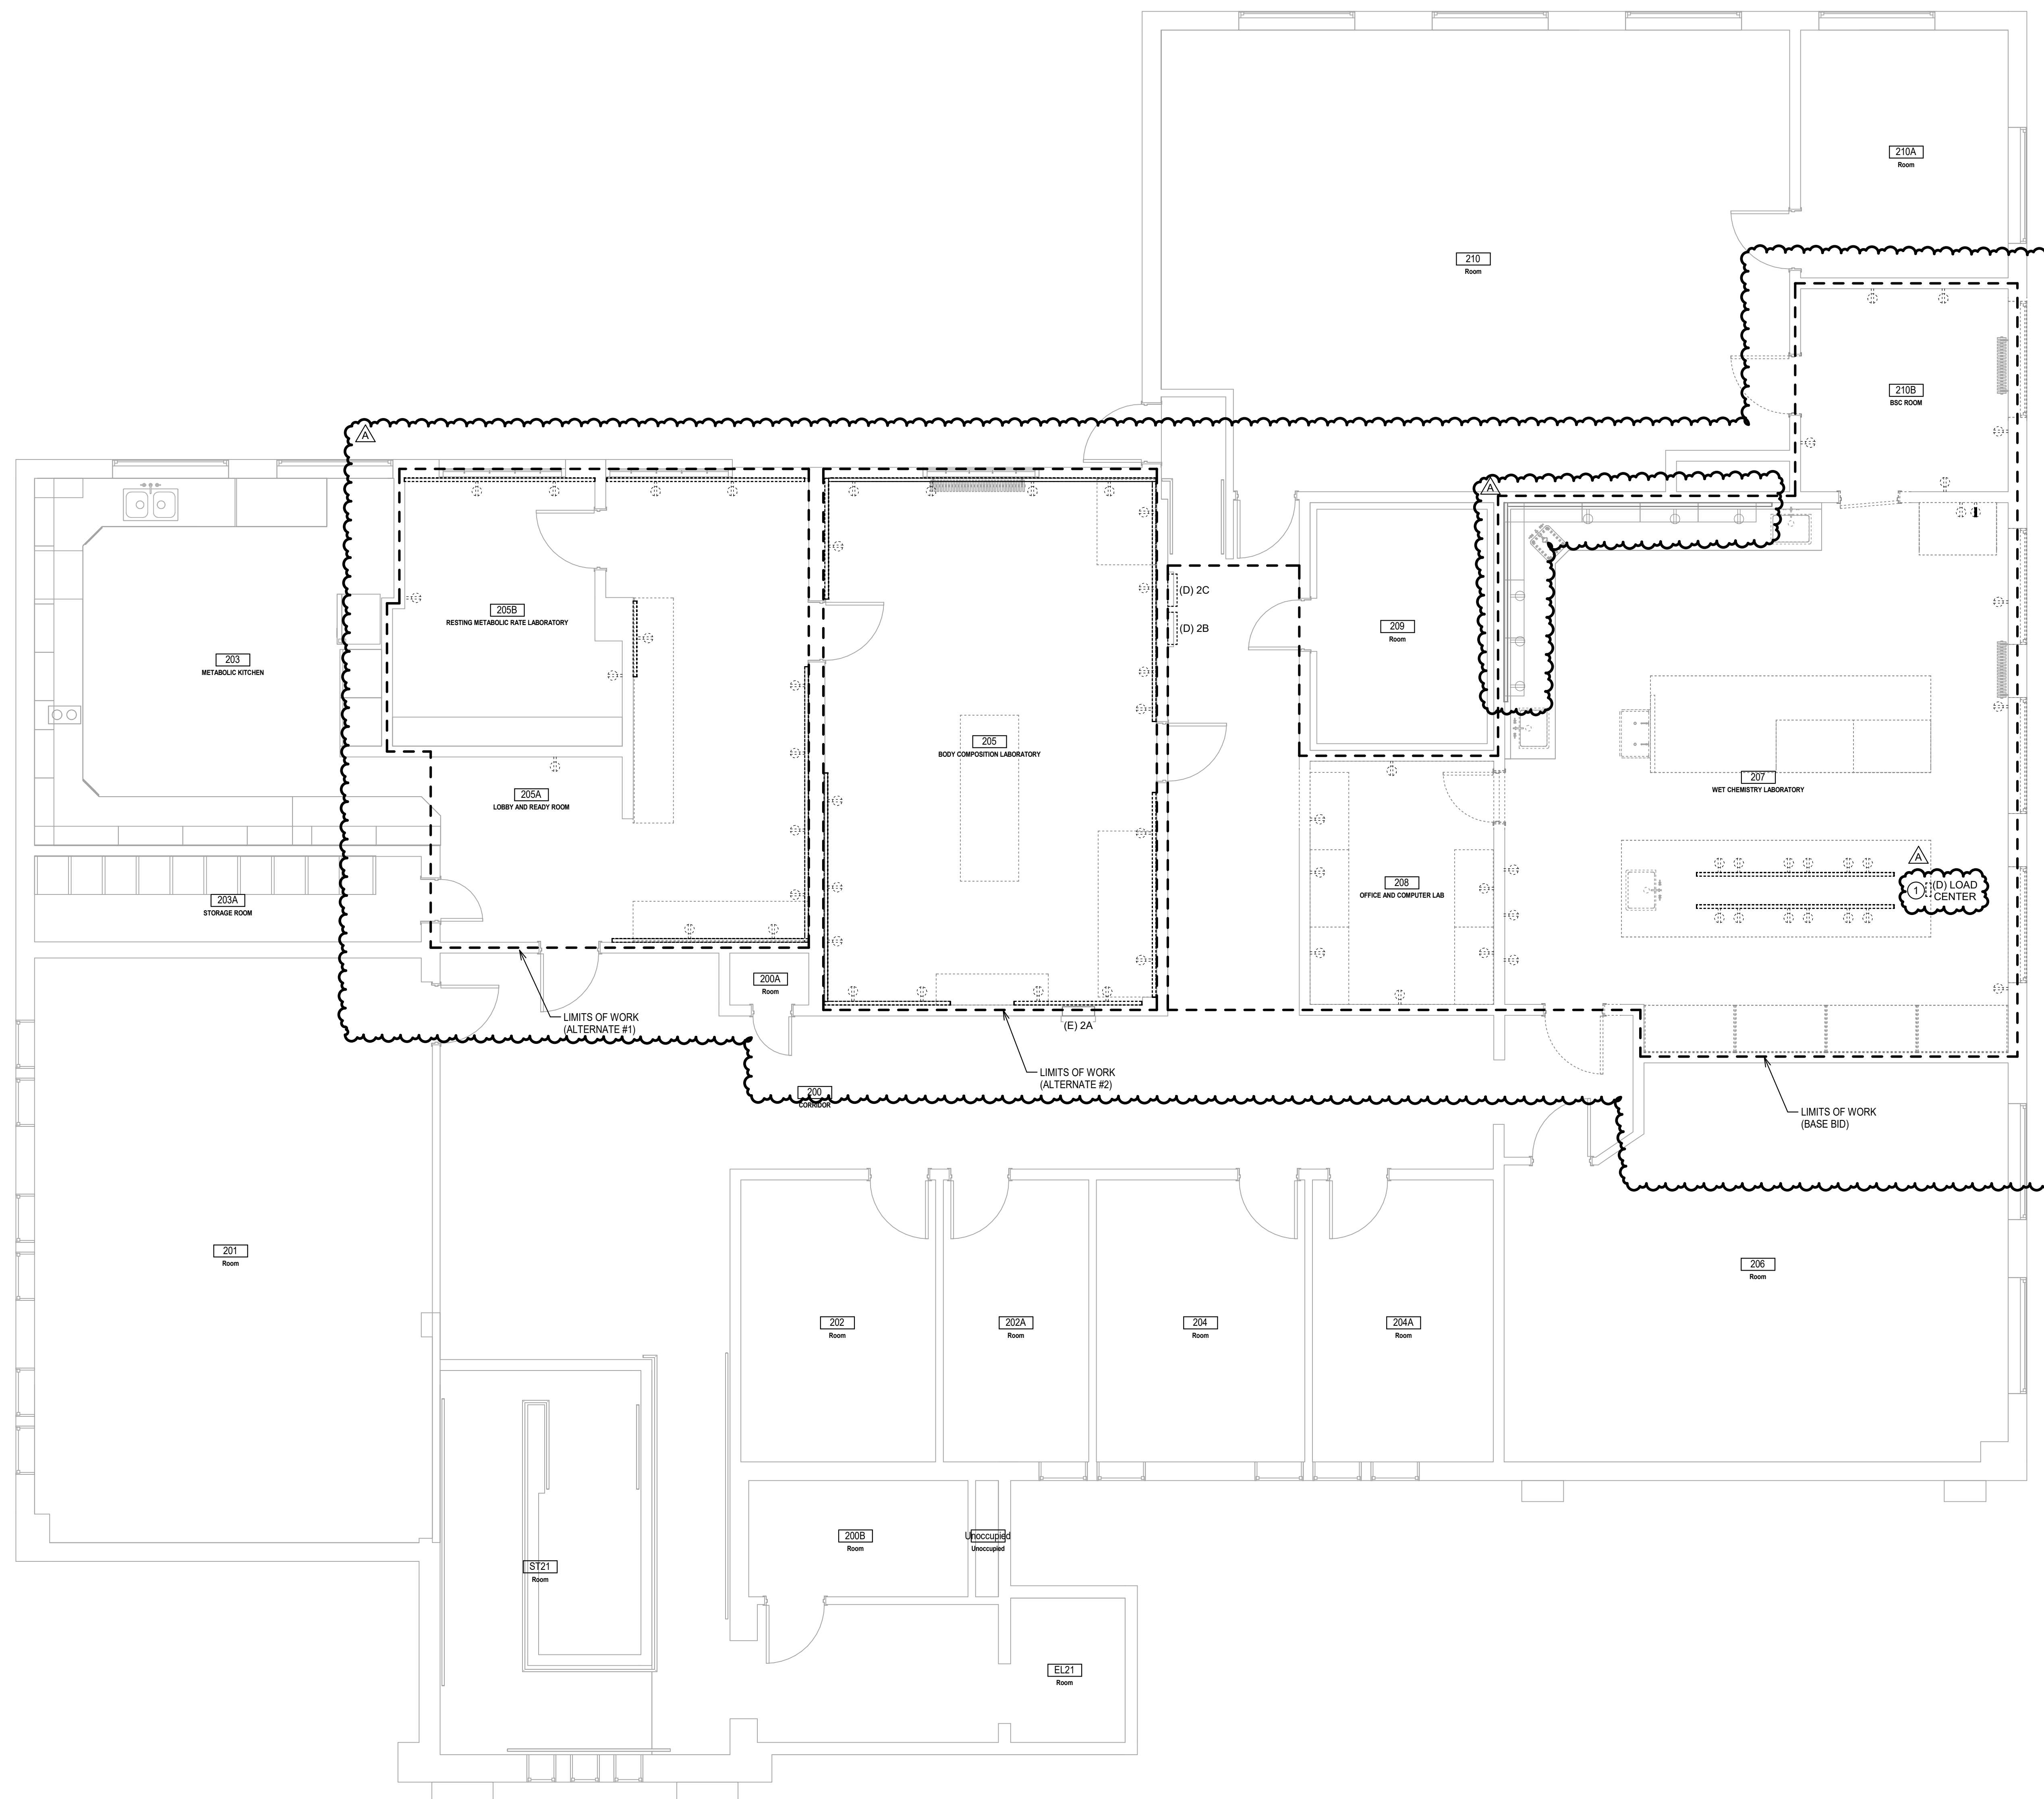

1. FIELD VERIFY EXISTING CONDITIONS PRIOR TO COMMENCING WORK.

1. DEMOLISH EXISTING LOAD CENTER BACK TO SOURCE. DEMOLISH ASSOCIATED CIRCUITS AND BREAKERS.


LEVEL 2 - DEMOLITION PLAN - ELECTRICAL

$$\frac{1}{4}'' = 1'-0''$$



DEMO ROOF PLAN - ELECTRICAL

1/4" = 1'-0"

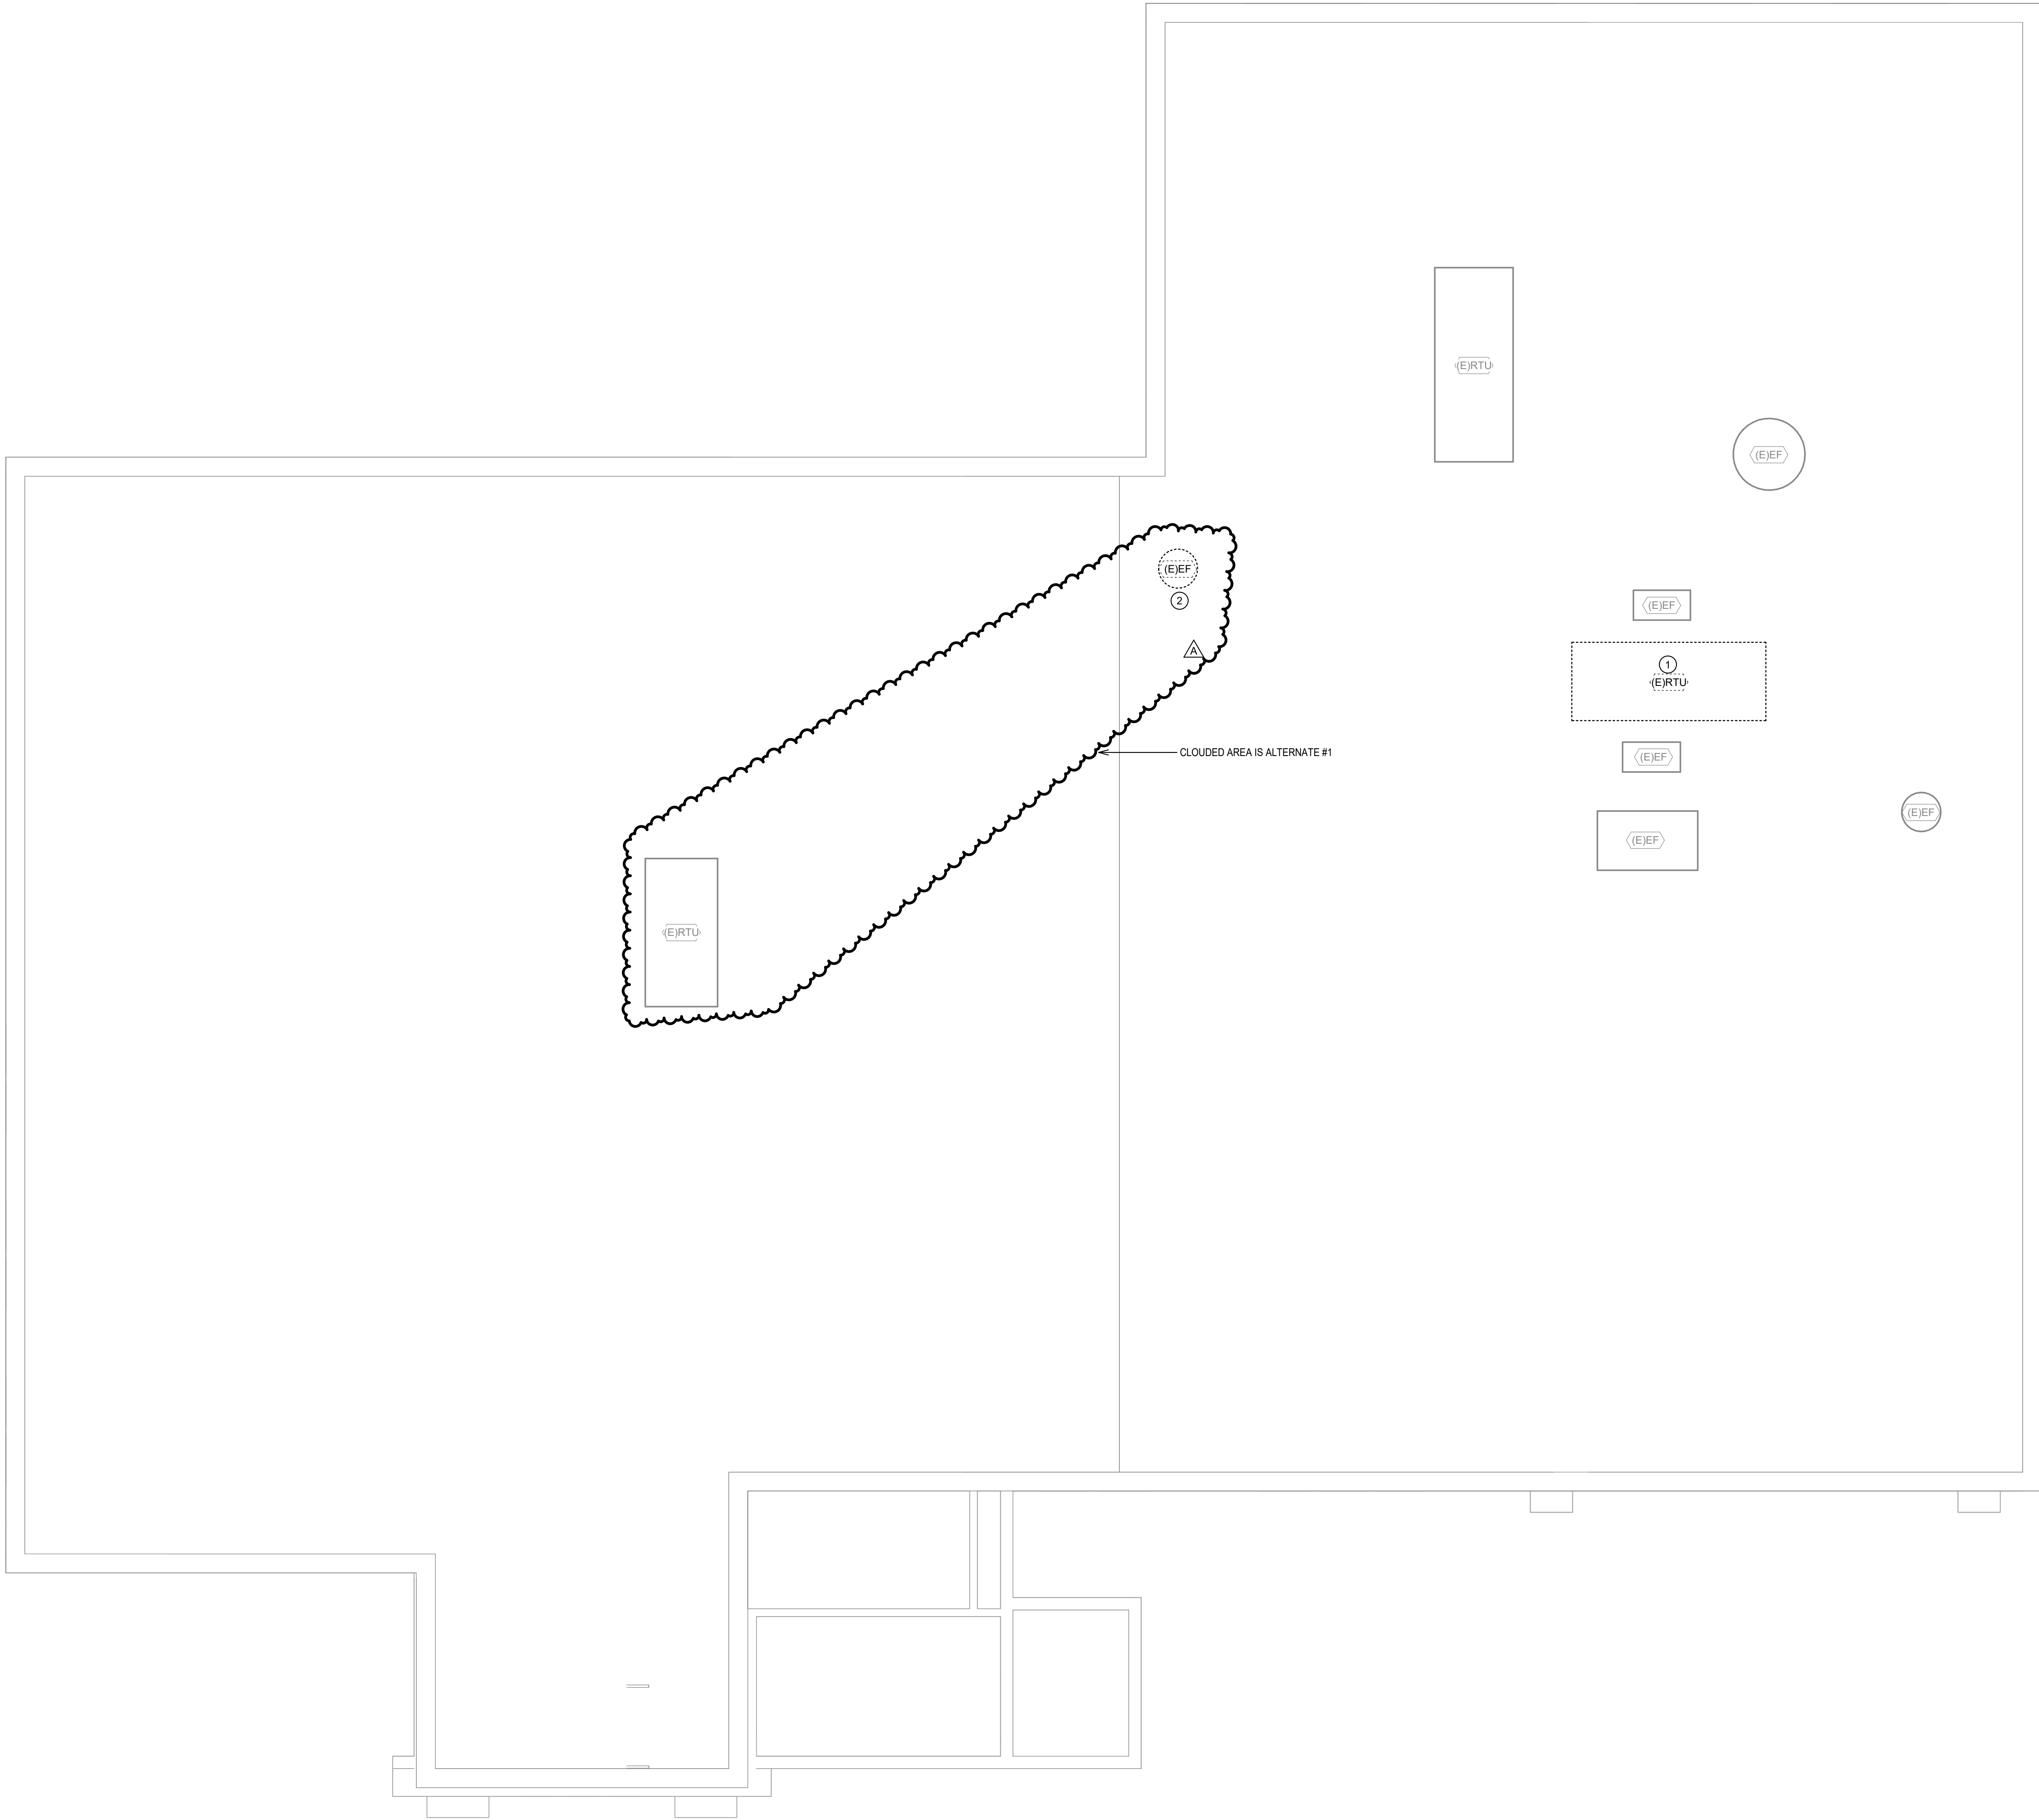


GENERAL NOTES:

1. MAKE SAFE ELECTRICAL CONNECTIONS TO EXISTING MECHANICAL EQUIPMENT BEING DEMOLISHED. REMOVE EXISTING BRANCH CIRCUIT CONDUCTORS TO NEAREST JUNCTION BOX OR RETAINED STRUCTURE AND PROTECT FOR REUSE. INTERCEPT AND MODIFY EXISTING RACEWAY SYSTEM AS REQUIRED TO ACCOMMODATE DEMOLITION OF EXISTING MECHANICAL EQUIPMENT AND CONNECTION OF NEW MECHANICAL EQUIPMENT. EXTEND BRANCH CIRCUIT CONDUCTORS AND MAKE FINAL CONNECTIONS. COORDINATE WITH DIV. 23 PRIOR TO COMMENCING WORK. SEE MECHANICAL DRAWINGS FOR ADDITIONAL DETAILS.
2. FIELD VERIFY EXISTING CONDITIONS PRIOR TO COMMENCING WORK.

KEYNOTES:

1. DEMOLISH EXISTING EQUIPMENT AND REPLACE WITH NEW AS INDICATED.
2. DEMOLISH EXISTING EQUIPMENT.

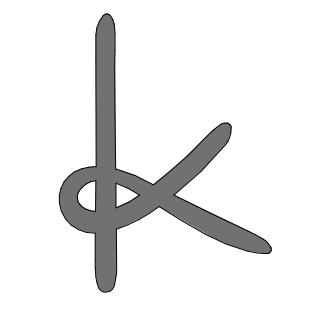

KNIT

knitstudios.com

THESE DOCUMENTS HAVE BEEN PRODUCED AS AN INSTRUMENT OF SERVICE AND ARE INTENDED SOLELY FOR THE PURPOSES OF CONTRACTING. LOANS AND REPRODUCTION OF THE PROJECT ARE THE ARCHITECT OF RECORD FOR THE PROJECT RETAINS OWNERSHIP OF THESE DOCUMENTS. ANY USE OF THESE DOCUMENTS OR USE OF THE DESIGN IDEAS OR CONCEPTS DESCRIBED HEREIN IN WHOLE OR PART BY ANY MEANS WHATSOEVER IS STRICTLY PROHIBITED EXCEPT BY WRITTEN CONSENT OF KNIT. REPRODUCTION OF THIS DOCUMENT IS STRICTLY PROHIBITED EXCEPT BY WRITTEN CONSENT OF KNIT.




MW Engineers

601 W First Ave, Ste 1300
Spokane, WA 99201, USA
509.838.9223
mwengineers.com

ISSUE DATE: **07.21.2025**

REV	DATE	COMMENT
A	7/21/2025	Owner Revisions

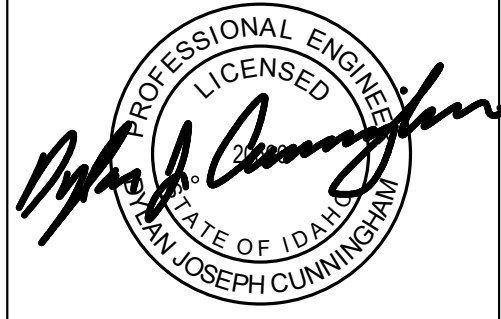

DEMO ROOF PLAN - ELECTRICAL

FOOD RESEARCH CENTER TI - PHASE 1 (BUILDING #: 005)

860 IDAHO AVE, MOSCOW, ID 83844

UNIVERSITY OF IDAHO

TITLE	PROJECT	CLIENT

JOB NO: **240004**

CAPITAL PROJECT NO: **CP220034**

ED2-12




THESE DOCUMENTS HAVE BEEN PRODUCED AS AN INSTRUMENT OF PRICE AND ARE INTENDED SOLELY FOR THE PURPOSE OF INSTRUCTING, USING AND MAINTAINING THE PROJECT. KNIT AS THE PROJECT RETAINS RECORD FOR THE PROJECT RETAINS OWNERSHIP OF THESE DOCUMENTS.

USE OF THESE DOCUMENTS OR USE OF THIS DESIGN, IDEAS OR CONCEPTS DESCRIBED HEREIN IN WHOLE OR PART BY ANY MEANS WHATSOEVER IS STRICTLY PROHIBITED EXCEPT BY WRITTEN CONSENT OF KNIT.

PRODUCTION OF THIS DOCUMENTS IS STRICTLY PROHIBITED EXCEPT BY WRITTEN CONSENT OF KNIT.




REV	DATE	COMMENT
	7/21/2025	Owner Revisions

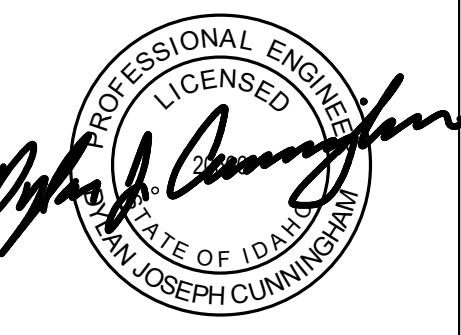

UNIVERSITY OF IDAHO

E2-11

1. PROPOSED ROUTING OF FEEDER CONDUIT FOR RTU-1 TO PANEL M.
2. ISLAND RECEPTACLES FEED FROM LEVEL 1 CEILING BELOW.

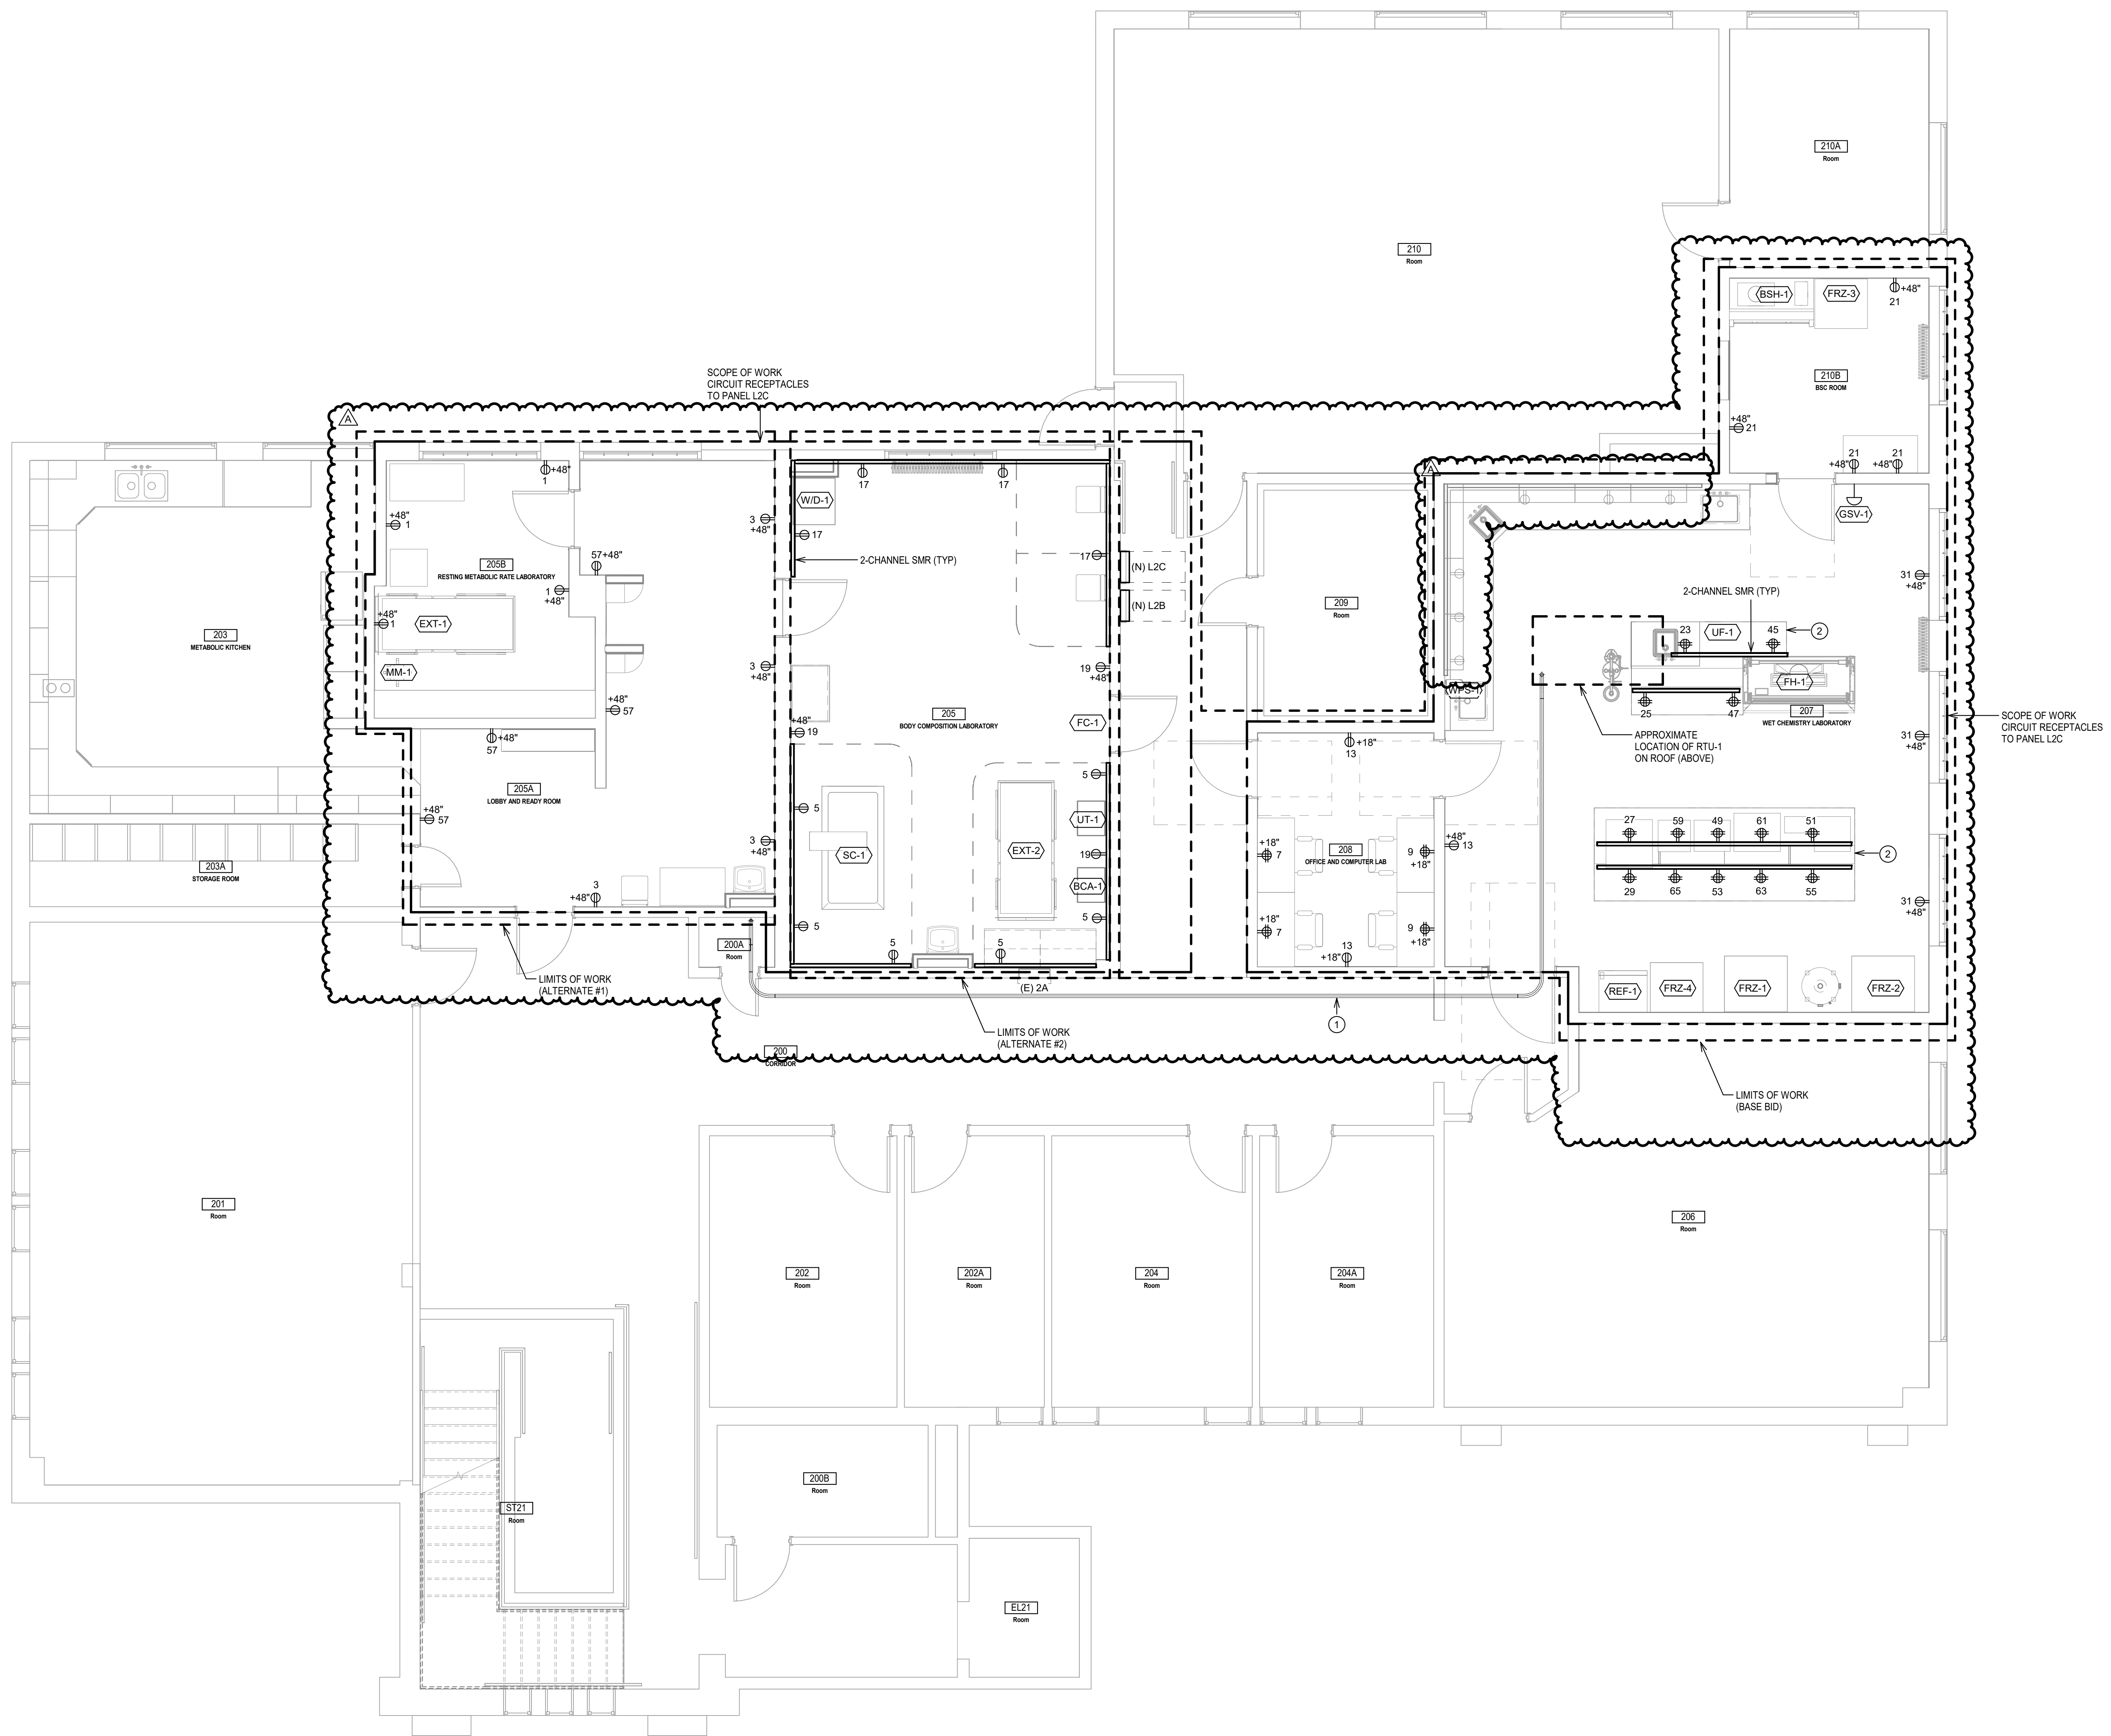
$$\frac{1}{4}'' = 1'-0''$$

1. FIELD VERIFY EXISTING CONDITIONS PRIOR TO COMMENCING WORK.



THESE DOCUMENTS HAVE BEEN PRODUCED AS AN INSTRUMENT OF SERVICE AND ARE INTENDED SOLELY FOR THE PURPOSE OF INSTRUCTING, USING AND MAINTAINING THE PROJECT. KNIT AS THE OBJECT OF RECORD FOR THE PROJECT RETAINS OWNERSHIP OF THESE DOCUMENTS.

USE OF THESE DOCUMENTS OR USE OF THIS DESIGN, IDEAS OR CONCEPTS DESCRIBED HEREIN IN WHOLE OR PART BY ANY MEANS WHATSOEVER IS STRICTLY PROHIBITED EXCEPT BY WRITTEN CONSENT OF KNIT.

REPRODUCTION OF THESE DOCUMENTS IS STRICTLY PROHIBITED EXCEPT BY WRITTEN CONSENT OF KNIT.



REV	DATE	COMMENT
	7/21/2025	Owner Revisions



FOOD RESEARCH CENTER II - PHASE 1 (BUILDING #: 005)
860 IDAHO AVE MOSCOW ID 83844

UNIVERSITY OF IDAHO


TITLE

PROJECT

CLIENT

JOB NO: 240004
CAPITAL PROJECT NO: CP220034


E2-12

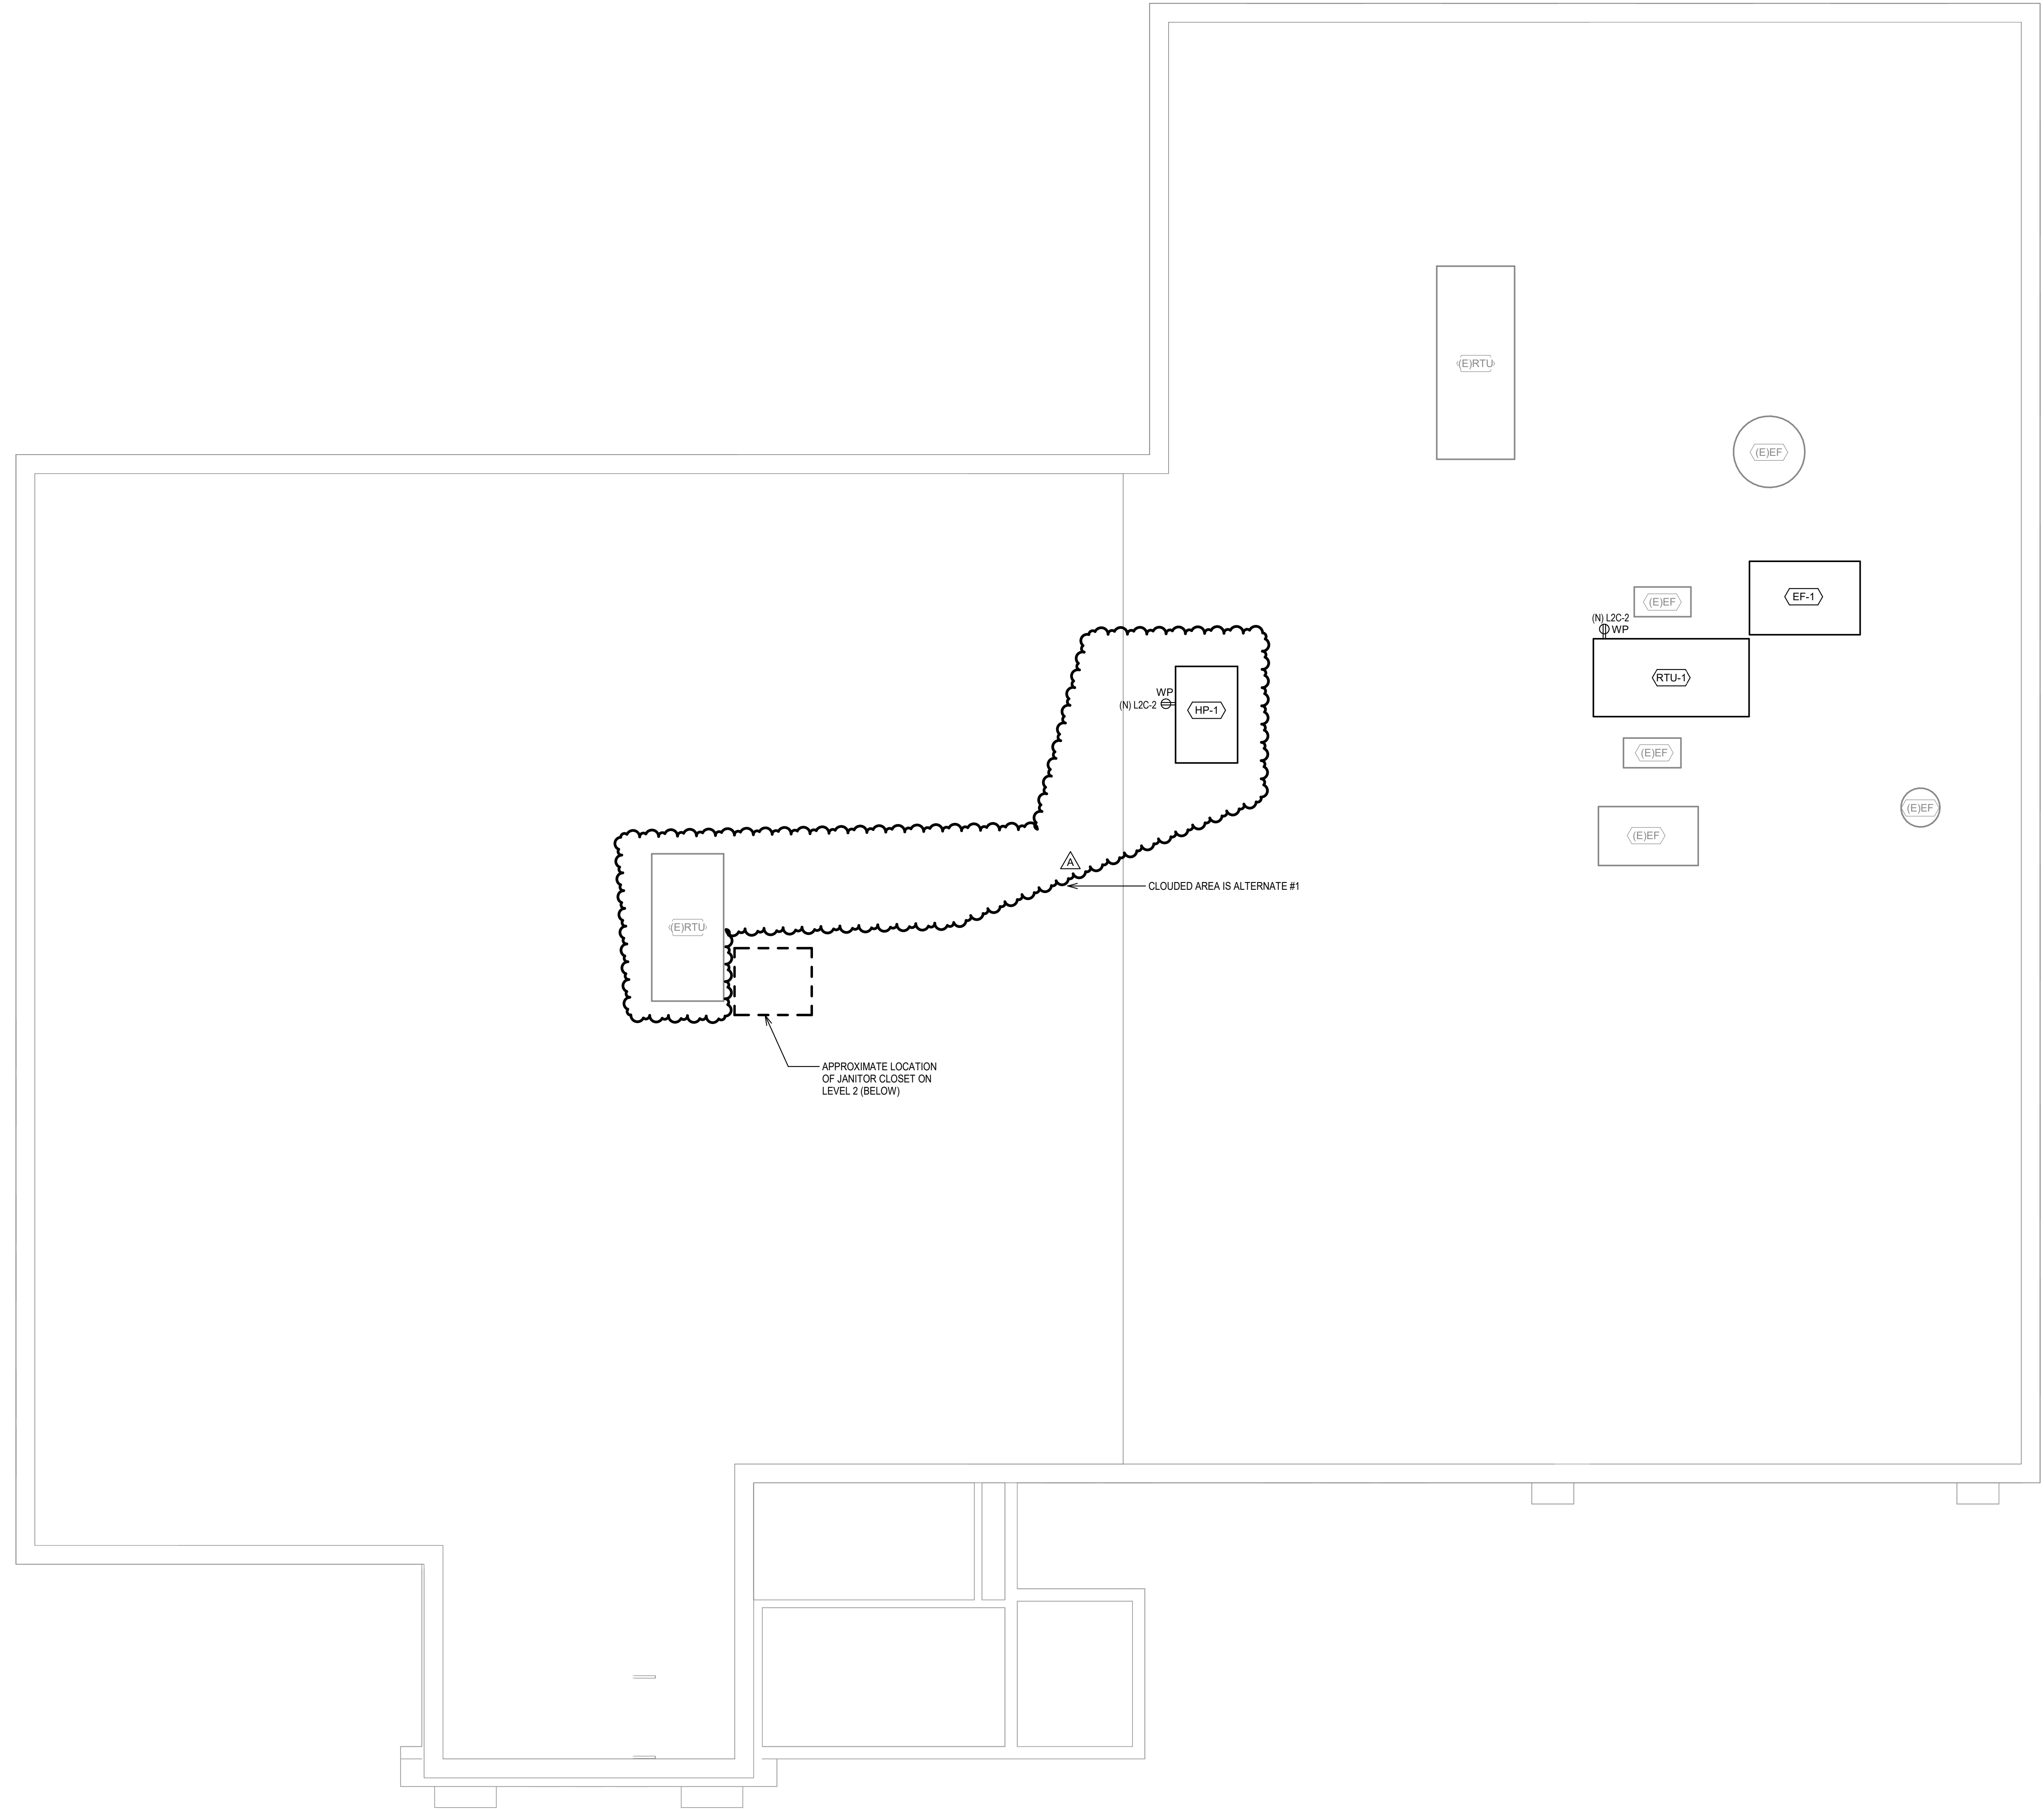


ROOF PLAN - ELECTRICAL

GENERAL NOTES:

1. FIELD VERIFY EXISTING CONDITIONS PRIOR TO COMMENCING WORK

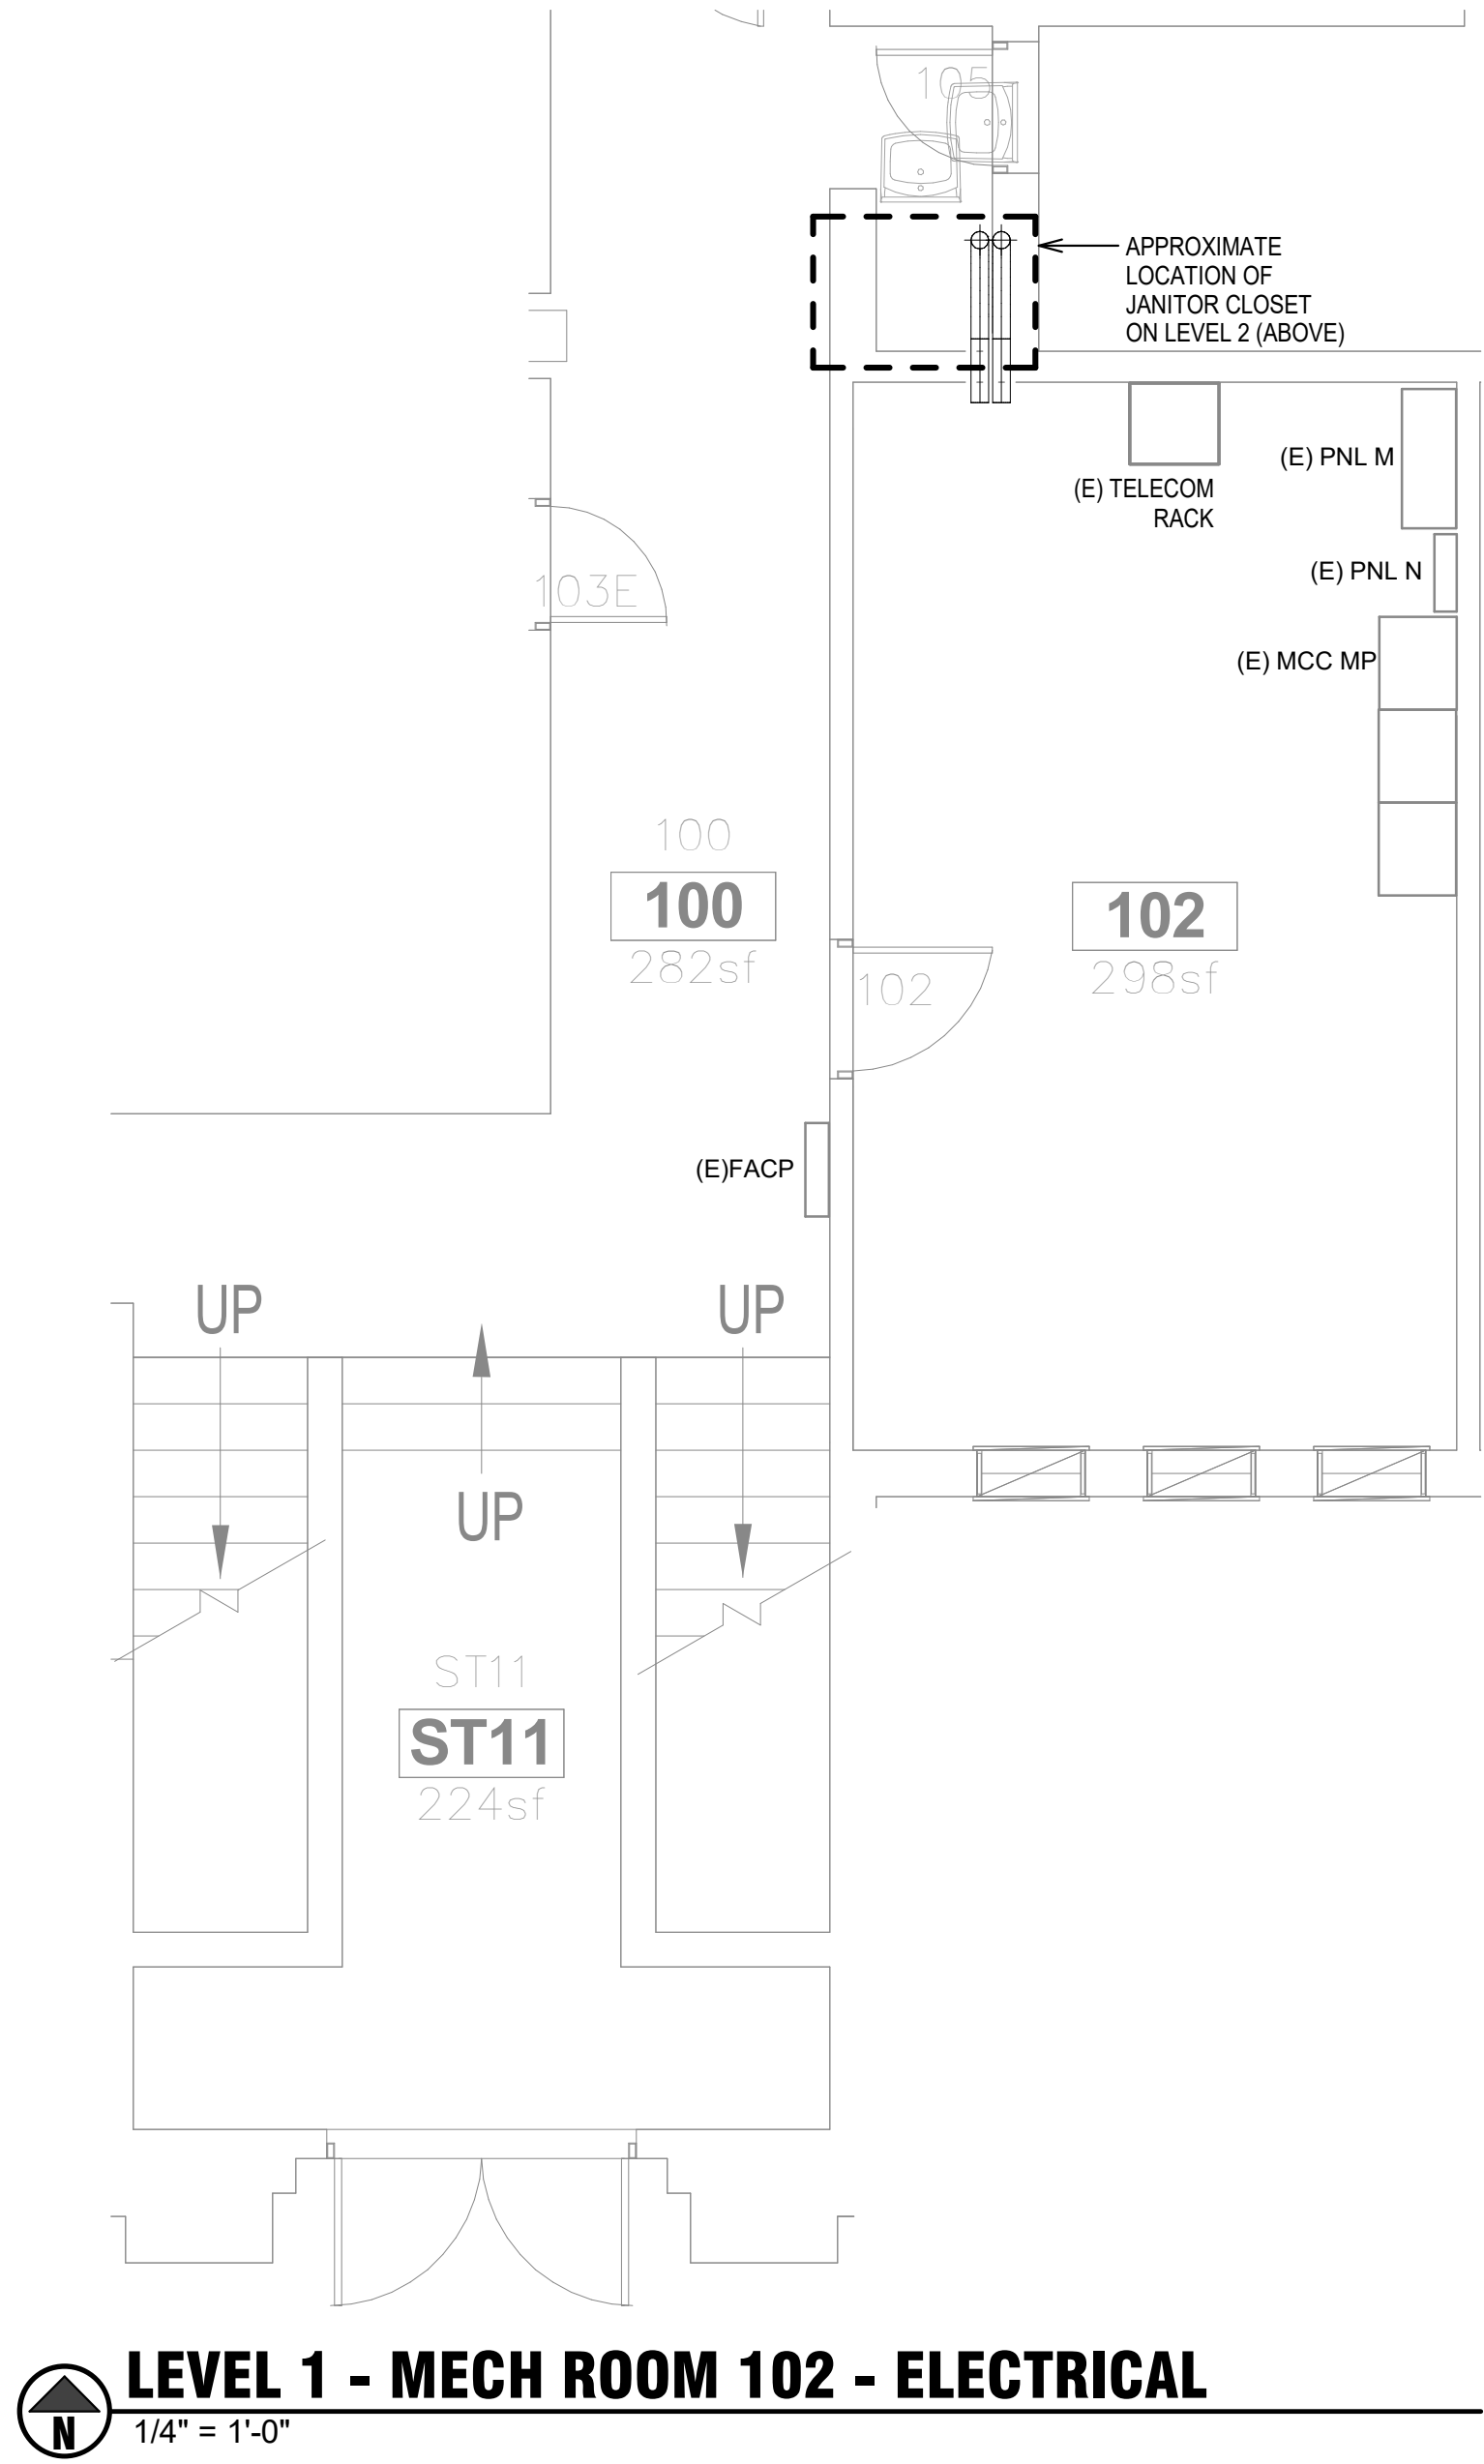

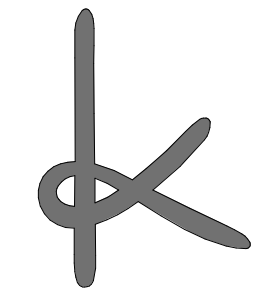


KNIT

knitstudios.com

THESE DOCUMENTS HAVE BEEN PRODUCED AS AN INSTRUMENT OF SERVICE AND ARE INTENDED SOLELY FOR THE PURPOSE OF CONSTRUCTING, LEASING AND MAINTAINING THE PROJECT. KNIT AS THE ARCHITECT OF RECORD FOR THE PROJECT RETAINS OWNERSHIP OF THESE DOCUMENTS. ANY USE OF THESE DOCUMENTS OR USE OF THE DESIGN IDEAS OR CONCEPTS DESCRIBED HEREIN IN WHOLE OR PART BY ANY MEANS WHATSOEVER IS STRICTLY PROHIBITED EXCEPT BY WRITTEN CONSENT OF KNIT. REPRODUCTION OF THIS DOCUMENT IS STRICTLY PROHIBITED EXCEPT BY WRITTEN CONSENT OF KNIT.




**MW
Engineers**

601 W First Ave, Ste 1300
Spokane, WA 99201, USA
509.838.9203
mwengineers.com

ISSUE DATE: **07.21.2025**

REV	DATE	COMMENT
-----	------	---------

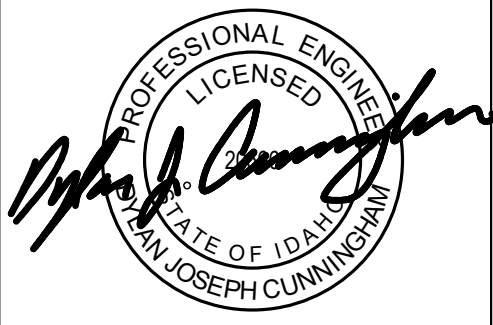

ENLARGED VIEWS - ELECTRICAL		
FOOD RESEARCH CENTER TI - PHASE 1 (BUILDING #: 005)		
860 IDAHO AVE, MOSCOW, ID 83844		
UNIVERSITY OF IDAHO		
TITLE	PROJECT	CLIENT
JOB NO: 240004 CAPITAL PROJECT NO: CP220034		
E4-01		

GENERAL NOTES:

1. COORDINATE CONNECTION DETAILS WITH EQUIPMENT VENDOR PRIOR TO ROUGH-IN.
2. REFER TO PROJECT SPECIFICATIONS FOR ADDITIONAL DETAILS AND REQUIREMENTS.
3. PROVIDE NEMA 3R RATED EQUIPMENT WHERE INSTALLED OUTDOORS.
4. COORDINATE ALL FUSE SIZES WITH EQUIPMENT VENDOR, EQUIPMENT NAMEPLATES AND SHOP DRAWINGS PRIOR TO ORDERING FUSES OR DISCONNECTS.
5. PROVIDE NEMA SWITCHER WHERE INDICATED ON THE SCHEDULE. PROVIDE AT MINIMUM THE SIZE INDICATED.
6. WIRE SIZES ARE FOR COPPER CONDUCTORS UNLESS SPECIFICALLY INDICATED OTHERWISE.
7. WHERE TOGGLE SWITCHES, MANUAL MOTOR STARTERS(MMS) AND MOTOR RATED SWITCHES(MRS) ARE INDICATED FOR EQUIPMENT INSTALLED IN FINISHED AREAS, THEY SHALL BE MOUNTED IN AN ADJACENT, CONCEALED AND ACCESSIBLE LOCATION.

EQUIPMENT SPECIFIC NOTES:

1. OUTDOOR CONSENSING UNIT CIRCUIT POWERS OUTDOOR UNIT AND INDOOR UNIT. SEE MECHANICAL DRAWINGS FOR DETAILS. CIRCUIT SHALL BE STRANDED WIRE.
2. EQUIPMENT BRANCH CIRCUIT IS OVSIZED TO ACCOUNT FOR VOLTAGE DROP.
3. EQUIPMENT INDICATED WITH '0' AMPS LOAD IS REDUNDANT AND WILL NOT OPERATE SIMULTANEOUSLY WITH ITS COUNTERPART. SEE MECHANICAL SCHEDULES FOR DETAILS.
4. EQUIPMENT IS FURNISHED WITH INTEGRAL THERMAL OVERLOAD PROTECTION FOR THE MOTOR.
5. WFD IS EQUIPPED WITH BYPASS. CIRCUIT BREAKER SIZED ACCORDINGLY.
6. CIRCUIT BREAKER IN PANEL SHALL HAVE NECESSARY HARDWARE TO FACILITATE LOCK-OUT, TAG-OUT OF BREAKER....

Equipment Name	Description	Room & Village	Phase	HP	Amps	KVA	Starter	Disconnect	Fuse Size	# of Sets	Conduit Size	Wire Size/Qty (AWG)	Panel	Circuit Number	Notes
BSH-1	BIOSAFETY HOOD	120 V	1	--	8 A	0.960 KVA	--	HARDWIRED	--	1	3/4"	2#12+1#12G	(N) L2C	11	
EF-1	EXHAUST FAN	208 V	1	33	4 A	0.832 KVA	--	TOGGLE SWITCH	--	1	3/4"	2#12+1#12G	(N) L2C	44,46	
FC-1	FAN COIL	205 208 V	1	--	0 A	0.000 KVA	--	TOGGLE SWITCH	--	1	3/4"	2#12+1#12G	(N) L2C	14, 16	1
FH-1	FUME HOOD	207 120 V	1	--	10 A	1.200 KVA	--	HARDWIRED	--	1	3/4"	2#12+1#12G	(N) L2C	33	
GSHV-1	GAS SHUT OFF	207 120 V	1	--	1 A	0.120 KVA	--	HARDWIRED	--	1	3/4"	2#12+1#12G	(N) L2C	38	
HT-1	HEAT PUMP	208 V	1	--	18.3 A	3.806 KVA	--	2P-30A	20A	1	3/4"	2#10+1#10G	(N) L2C	4, 6	1
RTU-1	ROOF TOP UNIT	208 V	3	2, 3	69.3 A	24.966 KVA	--	3P-100A	70A	1	1 1/4"	3#14+1#6G	(E) PANEL M	8, 10, 12	7

EQUIPMENT SPECIFIC NOTES:
1. INDICATED HEIGHTS ARE FOR REFERENCE ONLY. REFER TO AV AND ARCHITECTURAL DRAWINGS FOR FINAL EQUIPMENT HEIGHTS AND LOCATIONS.
2. DIVISION 26 SHALL PROVIDE AND INSTALL ELECTRICAL PROVISIONS AS SCHEDULED.


Equipment Name	Description	Room	Voltage	Phase	HP	Amps	kVA	Start	Disconnect	Fuse Size	# of Sets	Conduit Size	Wire Size/Qty (AWG)	Panel	Circuit Number	Notes
BCA-1	BODY COMPOSITION ANALYZER	205	120 V	1	--	5 A	0.600 kVA	--	NEMA 5-20R	--	1	3/4"	2#12-1#12G	(N) L2C	18	
EXT-1	EXAM TABLE	205B	120 V	1	--	5 A	0.600 kVA	--	NEMA 5-20R	--	1	3/4"	2#12-1#12G	(N) L2C	20	
EXT-2	EXAM TABLE	205	120 V	1	--	5 A	0.600 kVA	--	NEMA 5-20R	--	1	3/4"	2#12-1#12G	(N) L2C	28	
FRZ-1	FREEZER (-80)	207	208 V	1	--	10 A	2.080 kVA	--	NEMA 6-20R	--	1	3/4"	2#12-1#12G	(N) L2C	41,43	
FRZ-2	FREEZER (-80)	208	208 V	1	--	10 A	2.080 kVA	--	NEMA 6-20R	--	1	3/4"	2#12-1#12G	(N) L2C	40,42	
FRZ-3	FREEZER (-20)	120 V	120 V	1	--	5 A	0.600 kVA	--	NEMA 5-20R	--	1	3/4"	2#12-1#12G	(N) L2C	39	
FRZ-4	FREEZER (-20)	207	120 V	1	--	5 A	0.600 kVA	--	NEMA 5-20R	--	1	3/4"	2#12-1#12G	(N) L2C	37	
MM	METABOLIC MONITOR	205B	120 V	1	--	5 A	0.600 kVA	--	NEMA 5-20R	--	1	3/4"	2#12-1#12G	(N) L2C	32	
REF-1	REFRIGERATOR	207	120 V	1	--	2.2 A	0.284 kVA	--	NEMA 5-15R	--	1	3/4"	2#12-1#12G	(N) L2C	35	
SC-1	SCANNER	205	120 V	1	--	5 A	0.600 kVA	--	NEMA 5-20R	--	1	3/4"	2#12-1#10G	(N) L2C	24	
UF-1	UNDERCOUNTER FLASKSCRUBBER	207	208 V	3	--	20 A	7.205 kVA	--	NEMA 11-30R	--	1	3/4"	3#10-1#10G	(N) L2C	32,34,36	
UT-1	ULTRASOUND	205	120 V	1	--	5 A	0.600 kVA	--	NEMA 5-20R	--	1	3/4"	2#12-1#12G	(N) L2C	26	
W/D-1	WASHER/DRYER	205	208 V	1	--	10 A	2.080 kVA	--	NEMA 6-20R	--	1	3/4"	2#12-1#12G	(N) L2C	8,10	
WPS-1	WATER PURIFICATION SYSTEM	207	120 V	1	--	5 A	0.600 kVA	--	NEMA 5-20R	--	1	3/4"	2#12-1#12G	(N) L2C	30	

B	Type	Description	Lamp	VA	Voltage	Manufacturer	Model #	Keynote
B		24 RECESSED TROFFER	LED	39 VA	120 V	CORONET	SRP24-35-LW-G-ED1-U	
B		24 RECESSED TROFFER	LED	23 VA	120 V	COLUMBIA	SRP24-35-LW-G-ED1	
BE		24 RECESSED TROFFER - EMERGENCY	LED	39 VA	120 V	CORONET	SRP24-35-LW-G-ED1-U-E11.4	
E1		LED EXIT FIXTURE	LED	4 VA	120 V	BARRON	700ULB-WH	
Indirect Light Source			LED	0 VA				
P4		LINEAR DIRECT/INDIRECT PENDANT	LED	40 VA	120 V	CORONET	RAY4-UPDN-4-35-LOW-LOW-UN-DB-W-AC-SD-NA-NA-STD	
P4A		LINEAR DIRECT/INDIRECT PENDANT	LED	40 VA	120 V	CORONET	RAY4-UPDN-4-35-MED-MED-UN-DB-W-AC-SD-NA-NA-STD	
P4AE		LINEAR DIRECT/INDIRECT PENDANT	LED	40 VA	120 V	CORONET	RAY4-UPDN-4-35-MED-MED-UN-DB-W-AC-SD-EM-EM-STD	
P4E		LINEAR DIRECT/INDIRECT PENDANT	LED	80 VA	120 V	CORONET	RAY4-UPDN-4-35-LOW-LOW-UN-DB-W-AC-SD-NA-NA-STD	
P8E		LINEAR DIRECT/INDIRECT PENDANT - EMERGENCY	LED	80 VA	120 V	CORONET	RAY4-UPDN-8-35-LOW-LOW-UN-DB-W-AC-SD-NA-NA-EM-EM-STD	
Suspended								



ISSUE DATE: 07.21.2025

REV	DATE	COMMENT
A	7/21/2025	Owner Revisions

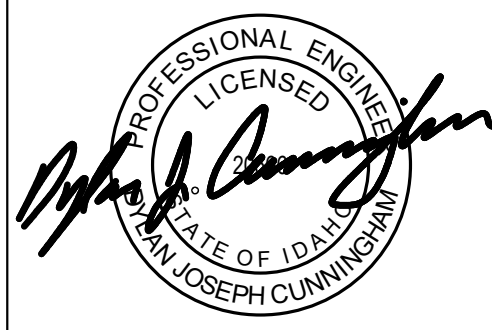

SCHEDULES - ELECTRICAL

FOOD RESEARCH CENTER TI - PHASE 1 (BUILDING #: 005)

860 IDAHO AVE, MOSCOW, ID 83844

UNIVERSITY OF IDAHO

TITLE	PROJECT	CLIENT
-------	---------	--------

JOB NO: **240004**
CAPITAL PROJECT NO: **CP220034**


E6-01

COPPER FEEDER SCHEDULE															
AMPACITY (AMPS)	FEEDER WITH NEUTRAL					FEEDER WITH 200% NEUTRAL AND ISOLATED GROUND					FEEDER WITHOUT NEUTRAL				
	FEEDER NUMBER	NUMBER OF SETS	CONDUIT (INCHES)	CONDUCTOR	GROUND	FEEDER NUMBER	NUMBER OF SETS	CONDUIT (INCHES)	CONDUCTOR	GROUND	FEEDER NUMBER	NUMBER OF SETS	CONDUIT (INCHES)	CONDUCTOR	GROUND
20	20N	1	3/4	#12	#12	20K	1	3/4	3#12+#8	2#12	20	1	3/4	3#12	#12
30	30N	1	3/4	#10	#10	30K	1	1	3#8+#4	2#10	30	1	3/4	3#10	#10
40	40N	1	1	#8	#10	40K	1	1	3#8+#3	2#10	40	1	1	3#8	#10
50	50N	1	1	#6	#8	50K	1	1 1/4	3#6+#1	2#8	50	1	1	3#6	#8
60	60N	1	1 1/4	#4	#8	60K	1	1 1/4	3#4+#1	2#8	60	1	1 1/4	3#4	#8
70	70N	1	1 1/4	#4	#8	70K	1	1 1/2	3#3+#10	2#8	70	1	1 1/4	3#4	#8
80	80N	1	1 1/2	#3	#8	80K	1	1 1/2	3#3+#20	2#8	80	1	1 1/4	3#3	#8
90	90N	1	1 1/2	#2	#8	90K	1	1 1/2	3#2+#30	2#8	90	1	1 1/4	3#2	#8
100	100N	1	2	#1	#6	100K	1	2	3#1+#30	2#6	100	1	1 1/2	3#1	#6
125	125N	1	2	#1	#6	125K	1	2 1/2	5#20	2#4	125	1	1 1/2	3#1	#6
150	150N	1	2	#10	#6	150K	1	2 1/2	5#30	2#4	150	1	2	3#10	#6
175	175N	1	2	#20	#4	175K	1	2 1/2	5#40	2#2	175	1	2	3#20	#4
200	200N	1	2 1/2	#30	#4	200K	1	3	5#250	2#2	200	1	2	3#30	#4
225	225N	1	2 1/2	#40	#2	225K	1	3	5#300	2#2	225	1	2 1/2	3#40	#2
250	250N	1	3	#250	#2	250K	1	4	5#400	2#10	250	1	3	3#250	#2
300	300N	1	4	#350	#2	300K	1	4	5#500	2#10	300	1	3	3#350	#2
350	350N	1	4	#500	#10	350K	2	2 1/2	5#40	2#20	350	1	4	3#500	#10
400	400N	1	4	#600	#10	400K	2	3	5#250	2#20	400	1	4	3#600	#10
450	450N	2	2 1/2	#40	#20	450K	2	3	5#500	2#20	450	2	2 1/2	3#40	#20
500	500N	2	3	#250	#20	500K	2	4	5#400	2#20	500	2	3	3#250	#20
600	600N	2	4	#350	#20	600K	2	4	5#500	2#30	600	2	3	3#350	#20
700	700N	2	4	#500	#30	700K	4	2 1/2	5#40	2#30	700	2	4	3#500	#30
800	800N	2	4	#600	#30	800K	4	3	5#250	2#30	800	2	4	3#600	#30
1000	1000N	3	4	#4400	#30	1000K	4	4	5#400	2#30	1000	3	3	3#400	#30
1200	1200N	4	4	#6350	#30	1200K	4	4	5#500	2#30	1200	4	3	3#350	#30
1600	1600N	4	4	#6000	#40	1600K	8	3	5#250	2#40	1600	4	4	3#600	#40
2000	2000N	5	4	#6000	#250	2000K	8	4	5#400	2#250	2000	5	4	3#600	#250
2500	2500N	6	4	#6000	#350	2500K	10	4	5#400	2#350	2500	6	4	3#600	#350
3000	3000N	8	4	#6500	#400	3000K	10	4	5#500	2#400	3000	8	4	3#500	#400
4000	4000N	10	4	#6000	#500	4000K	16	4	5#400	2#500	4000	10	4	3#600	#500
NOTES: 1. CONDUIT SIZES ARE BASED ON THWN INSULATION FOR ALL CONDUCTORS AND RGS CONDUIT.															

Short Circuit Current Calculations


3 PHASE Fault		Total Fault Currents
Name	Bus kV	Sym Amps
L2A	0.208	14356
L2B	0.208	14356
MAIN	0.208	24021
PNL M	0.208	19386.6

- GENERAL NOTES:
- EXISTING CONDITIONS ARE BASED UPON BEST AVAILABLE RECORD DRAWINGS.
 - FIELD VERIFY EXISTING CONDITIONS PRIOR TO COMMENCING WORK.
 - ALL EQUIPMENT SHOWN IN THIS DRAWING IS EXISTING TO REMAIN UNLESS NOTED OTHERWISE.

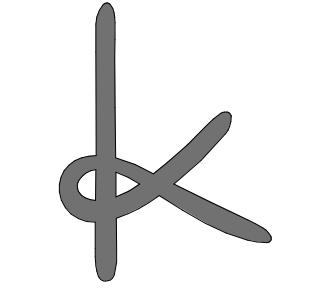


knitstudios.com


THESE DOCUMENTS HAVE BEEN PRODUCED AS AN INSTRUMENT OF SERVICE AND ARE INTENDED SOLELY FOR THE PURPOSES OF CONSTRUCTING, USING AND MAINTAINING THE PROJECT. KNIT AS THE ARCHITECT OF RECORD FOR THE PROJECT RETAINS OWNERSHIP OF THESE DOCUMENTS. ANY USE OF THESE DOCUMENTS OR USE OF THE DESIGN IDEAS OR CONCEPTS DESCRIBED HEREIN IN WHOLE OR IN PART BY ANY PERSON WHATSOEVER IS STRICTLY PROHIBITED EXCEPT BY WRITTEN CONSENT OF KNIT. REPRODUCTION OF THIS DOCUMENT IS STRICTLY PROHIBITED EXCEPT BY WRITTEN CONSENT OF KNIT.



601 W First Ave, Ste 1200
Schaumburg, IL 60196
815.398.8200
mwengineers.com

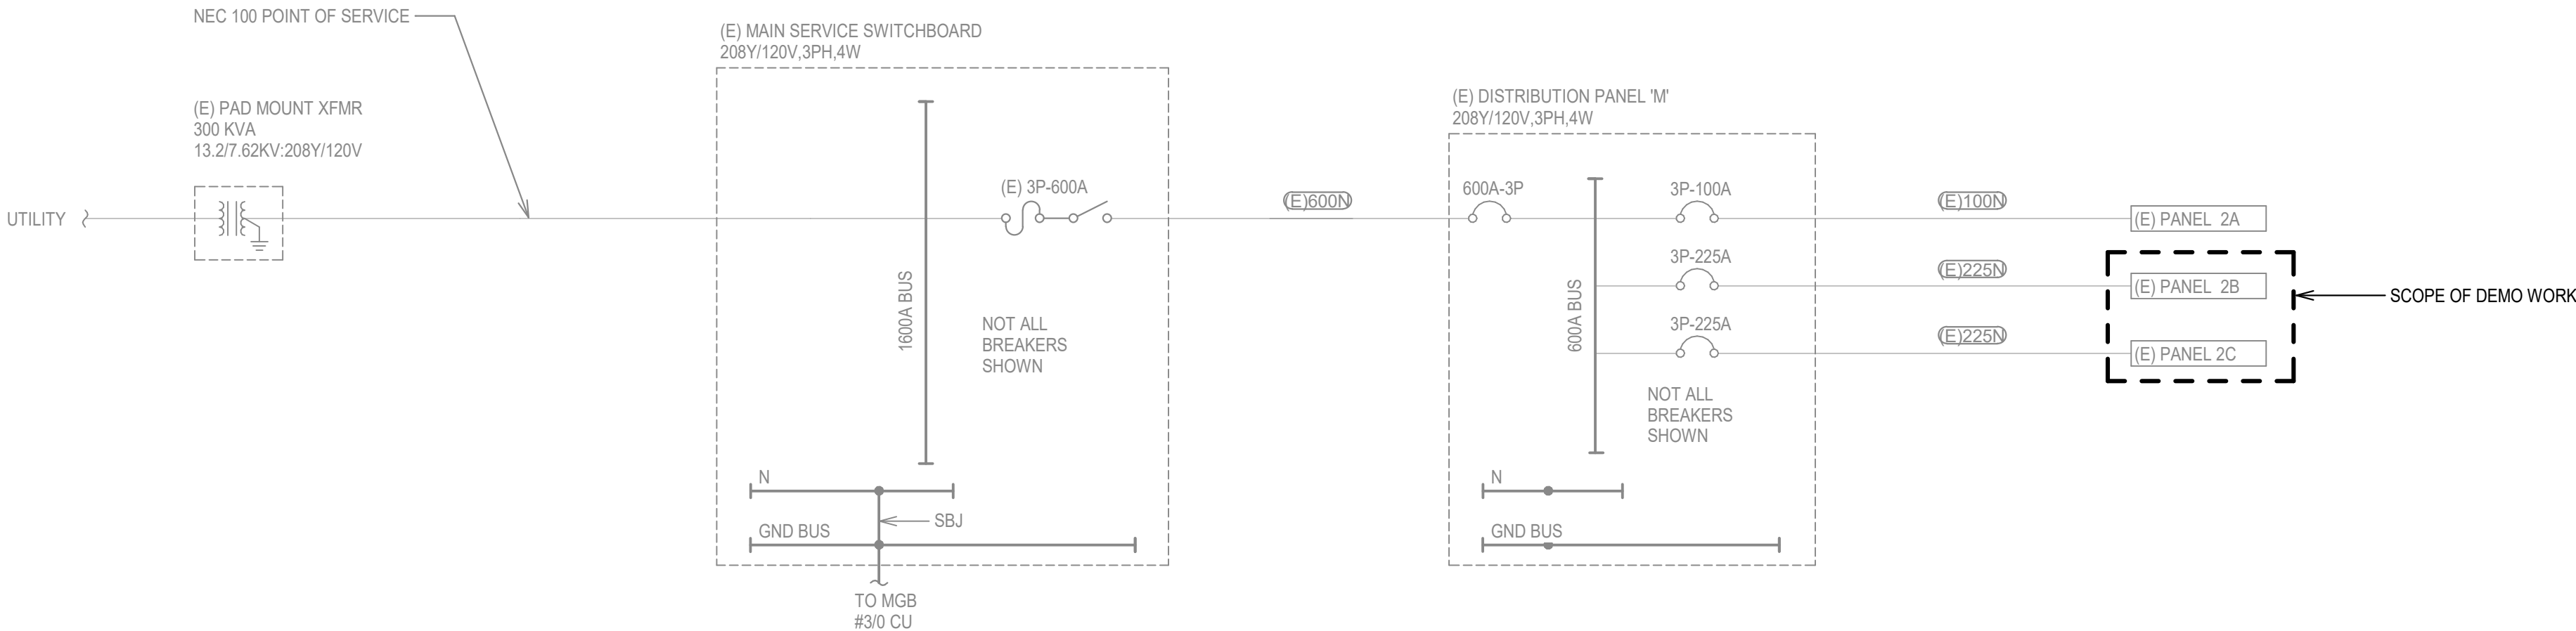


1 PARTIAL ONE-LINE DIAGRAM - ELECTRICAL - DEMOLITION
N.T.S.

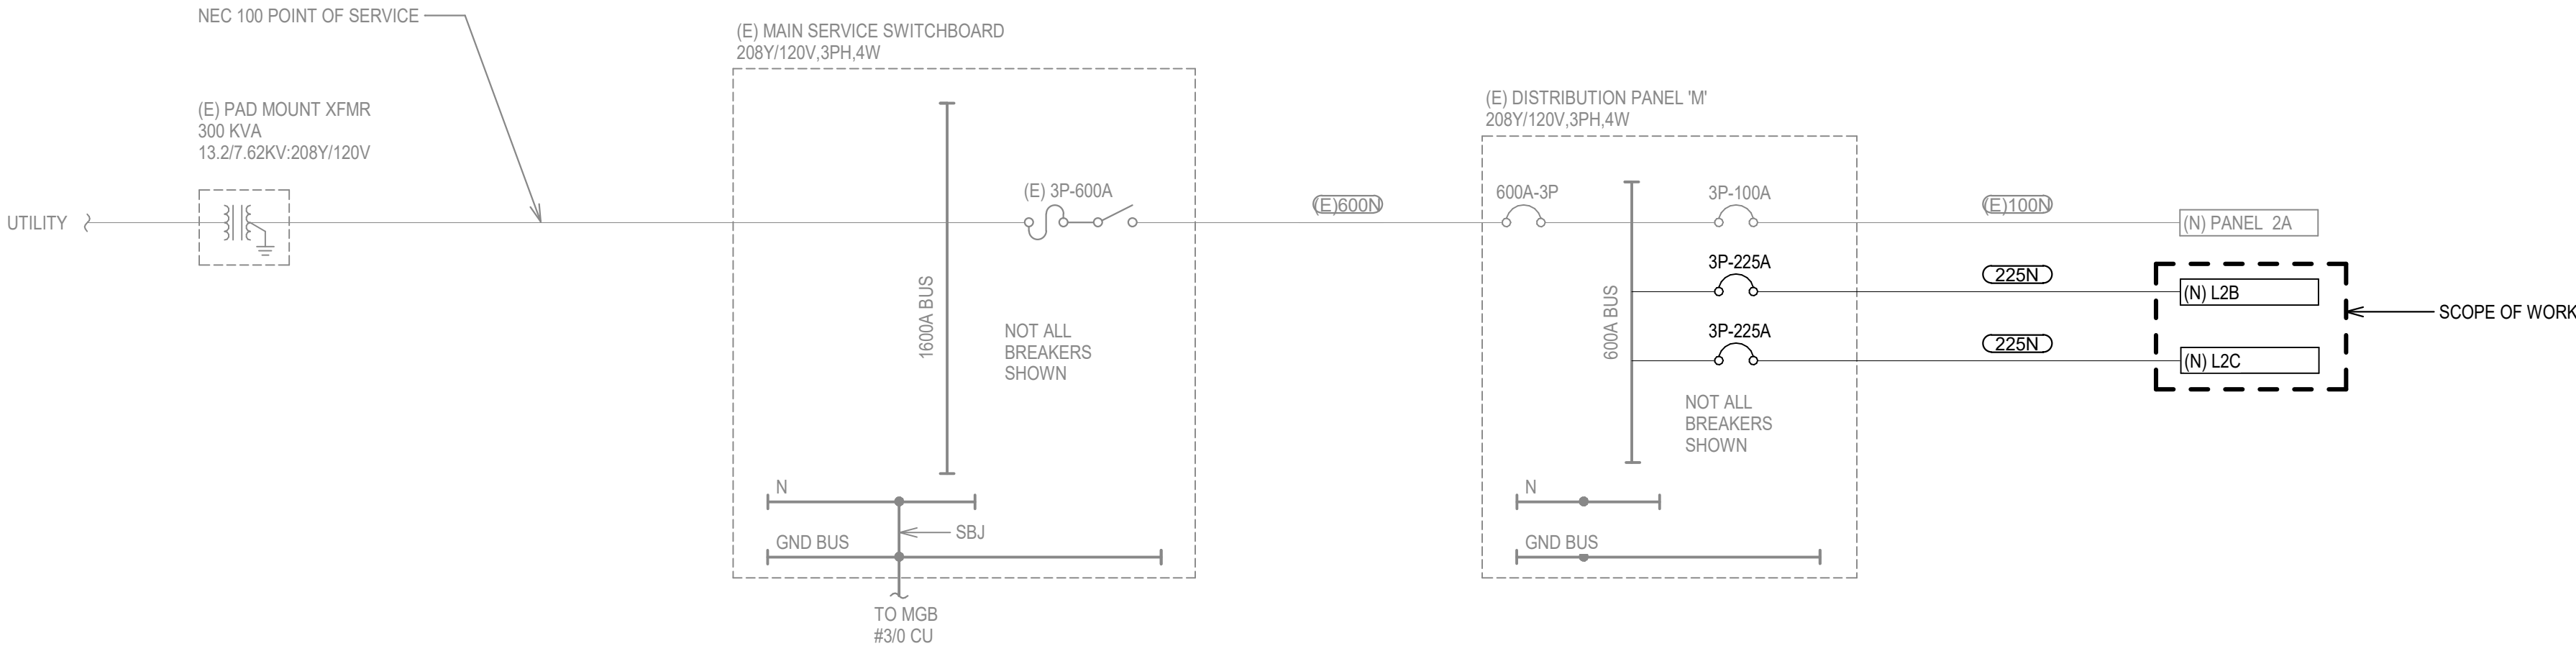

2 PARTIAL ONE-LINE DIAGRAM - ELECTRICAL - REVISED
N.T.S.

ISSUE DATE: 07.21.2025

REV	DATE	COMMENT

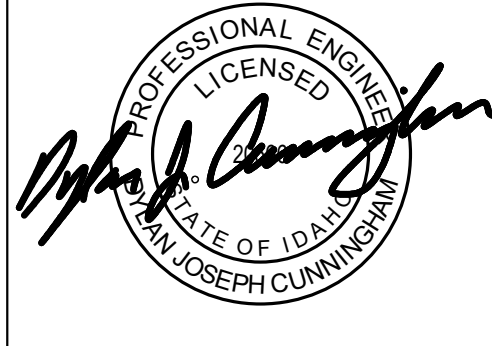

ONE-LINE DIAGRAM - ELECTRICAL

FOOD RESEARCH CENTER TI - PHASE 1 (BUILDING #: 005)

860 IDAHO AVE, MOSCOW, ID 83844


UNIVERSITY OF IDAHO

TITLE	PROJECT	CLIENT


JOB NO: 240004

CAPITAL PROJECT NO: CP220034

E8-01

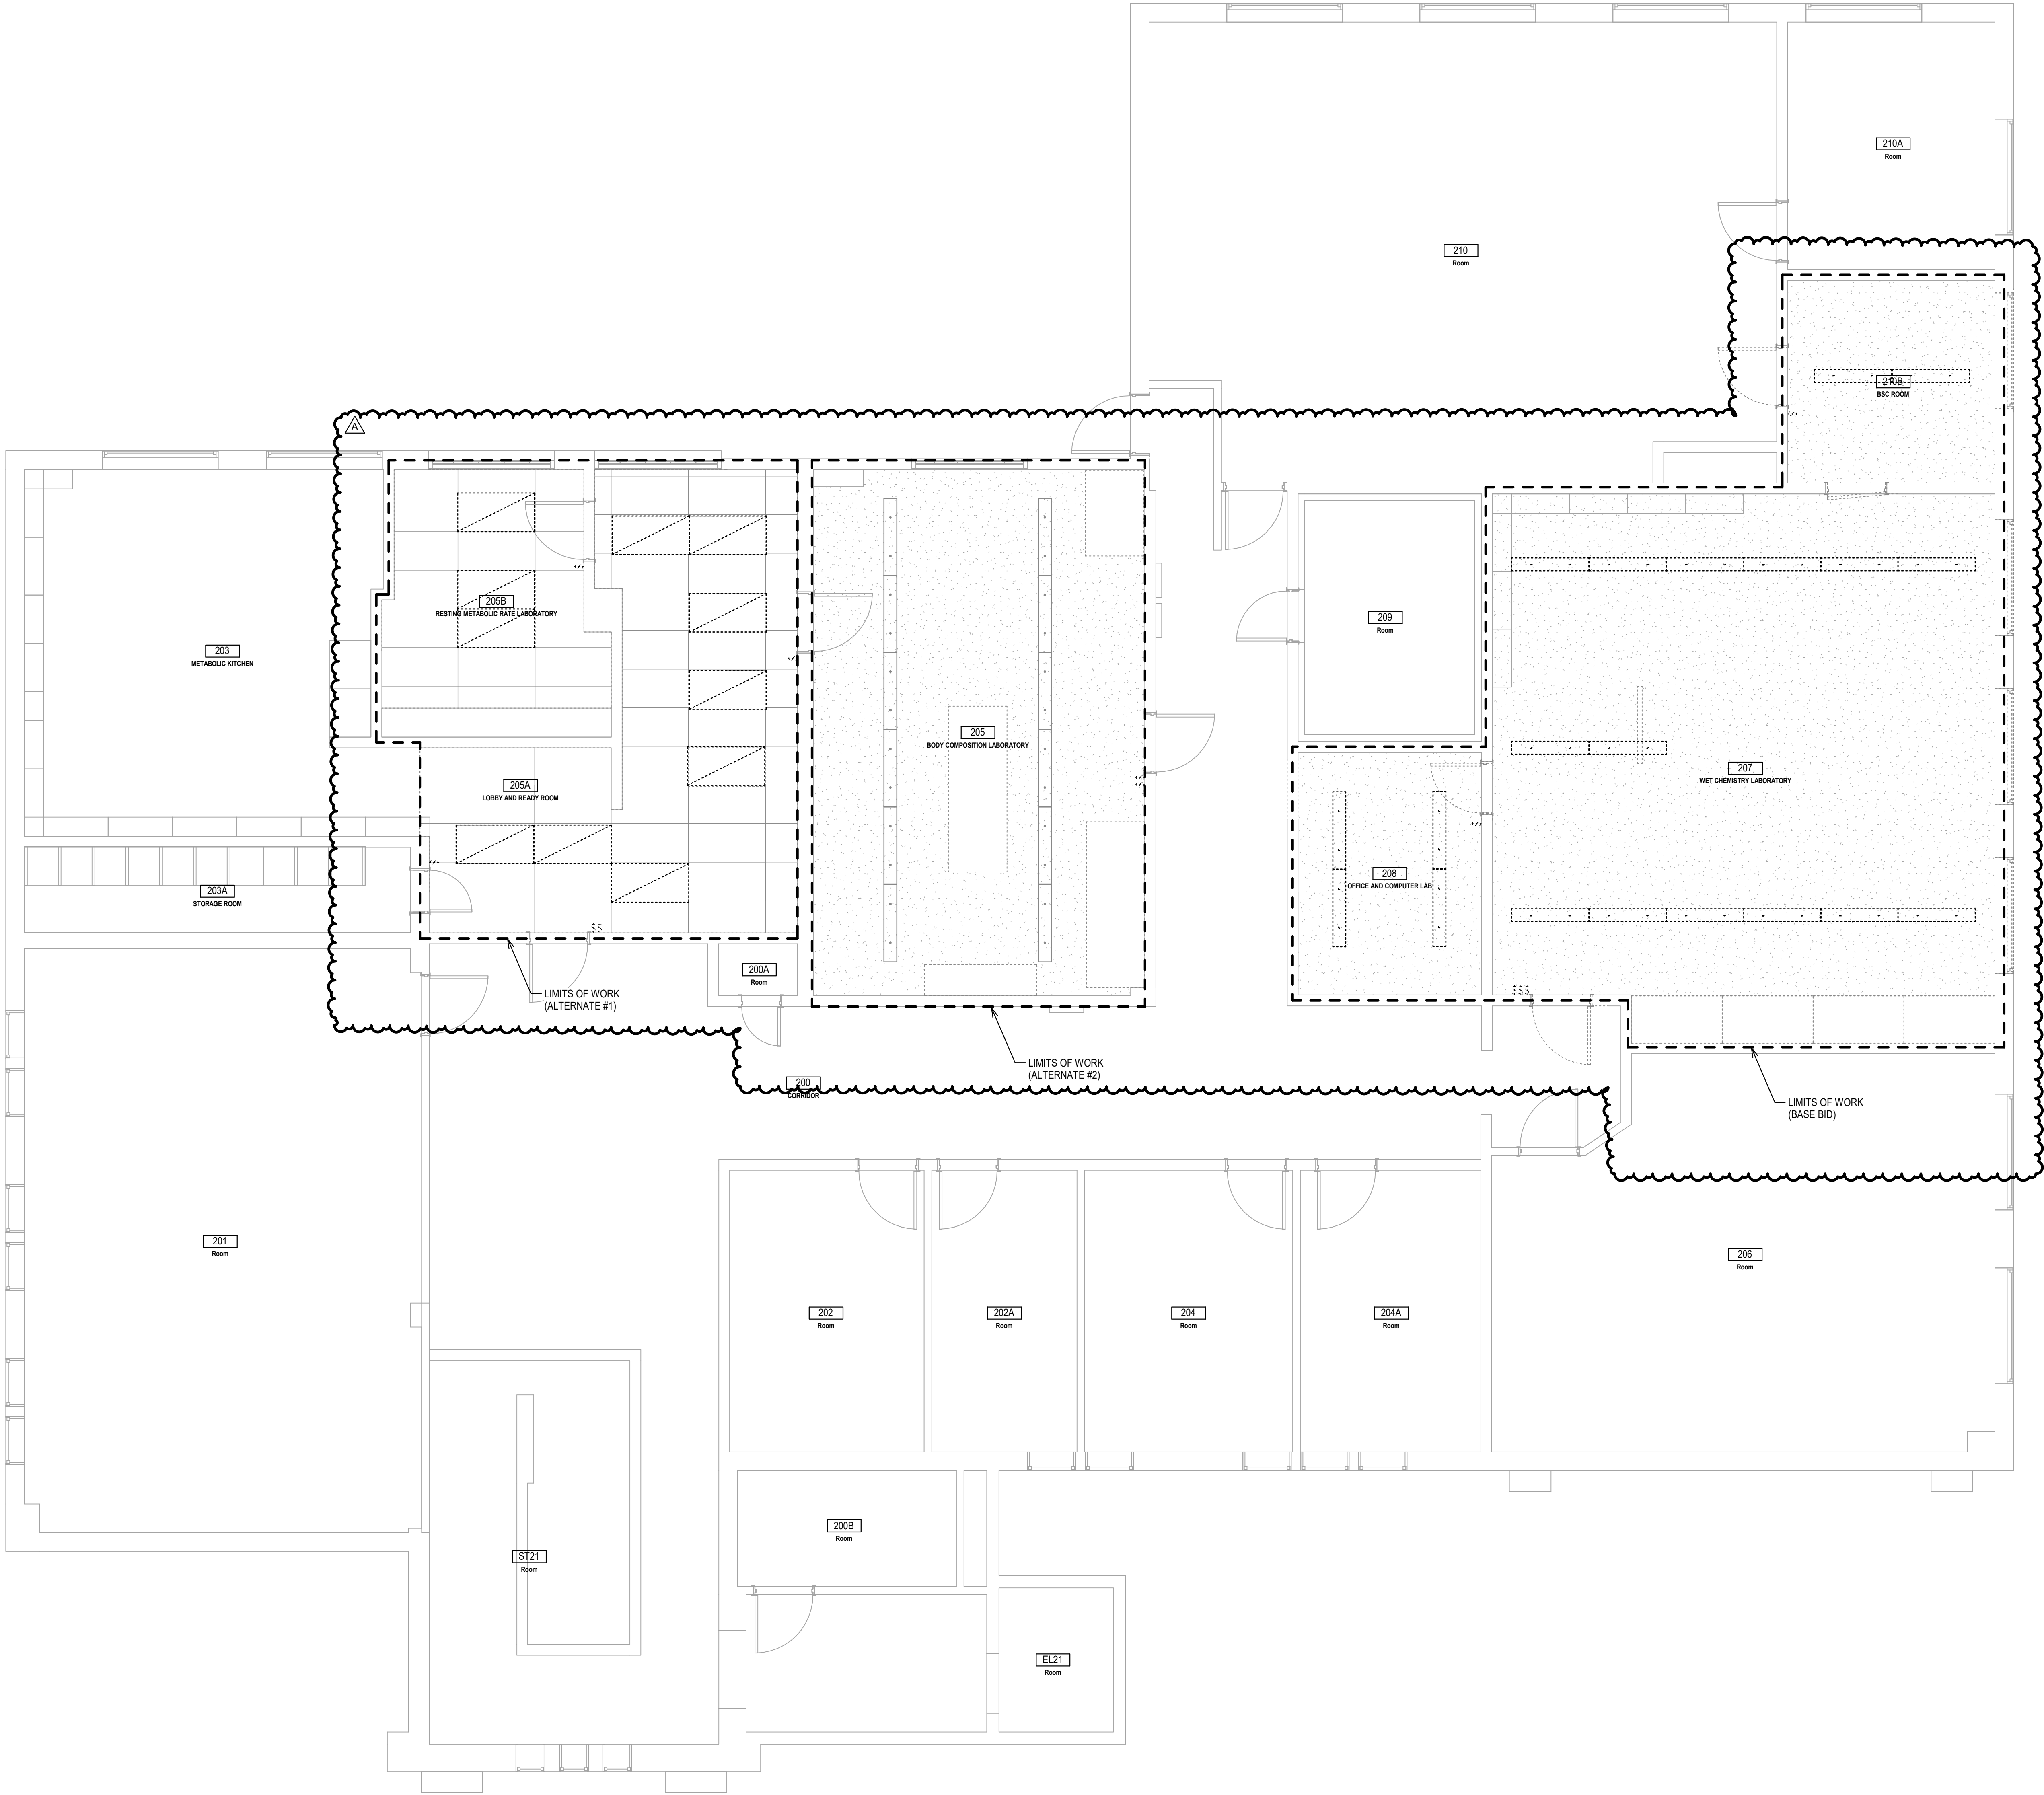


GENERAL NOTES:
1. FIELD VERIFY EXISTING CONDITIONS PRIOR TO COMMENCING WORK

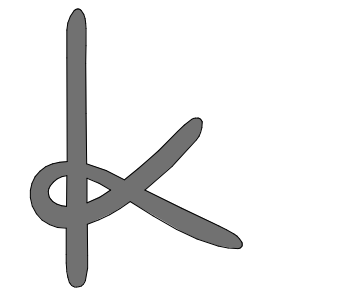

knitstudios.com

THESE DOCUMENTS HAVE BEEN PRODUCED AS AN INSTRUMENT OF SERVICE AND ARE INTENDED SOLELY FOR THE PURPOSES OF CONSTRUCTING, LEASING AND MAINTAINING THE PROJECT. KNIT AS THE ARCHITECT OF RECORD FOR THE PROJECT RETAINS OWNERSHIP OF THESE DOCUMENTS. ANY USE OF THESE DOCUMENTS OR USE OF THE DESIGN IDEAS OR CONCEPTS DESCRIBED HEREIN IN WHOLE OR IN PART BY ANY MEANS WHATSOEVER IS STRICTLY PROHIBITED EXCEPT BY WRITTEN CONSENT OF KNIT. REPRODUCTION OF THIS DOCUMENT IS STRICTLY PROHIBITED EXCEPT BY WRITTEN CONSENT OF KNIT.




escent

LIGHTING DESIGN

601 W First Ave, St 1300
Spokane, WA 99201 USA
808.838.4029
www.escentdesign.com/escent

ISSUE DATE: 07.21.2025

REV	DATE	COMMENT
A	7/21/2025	Owner Revisions

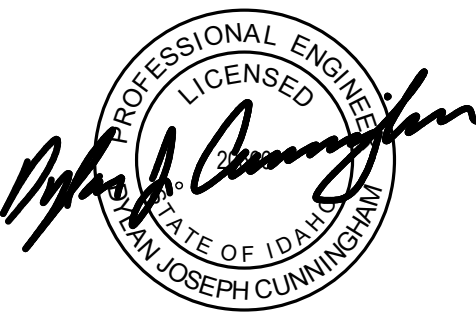

DEMO FLOOR PLAN - LIGHTING

FOOD RESEARCH CENTER TI - PHASE 1 (BUILDING #: 005)

860 IDAHO AVE, MOSCOW, ID 83844

UNIVERSITY OF IDAHO

TITLE	PROJECT	CLIENT
JOB NO: 240004	CAPITAL PROJECT NO: CP220034	

ELD2-11

1. FIELD VERIFY EXISTING CONDITIONS PRIOR TO COMMENCING WORK.



THESE DOCUMENTS HAVE BEEN PRODUCED AS AN INSTRUMENT OF SERVICE AND ARE INTENDED SOLELY FOR THE PURPOSE OF CONSTRUCTING, USING AND MAINTAINING THE PROJECT. KNIIT AS THE ARCHITECT OF RECORD FOR THE PROJECT RETAINS OWNERSHIP OF THESE DOCUMENTS.


ANY USE OF THESE DOCUMENTS OR USE OF THIS DESIGN, IDEAS OR CONCEPTS DESCRIBED HEREIN IN WHOLE OR PART BY ANY MEANS WHATSOEVER IS STRICTLY PROHIBITED EXCEPT BY WRITTEN CONSENT OF KNIIT.

REPRODUCTION OF THIS DOCUMENTS IS STRICTLY PROHIBITED EXCEPT BY WRITTEN CONSENT OF KNIIT.



ISSUE DATE: 07.21.2025

REV	DATE	COMMENT
A	7/21/2025	Owner Revisions

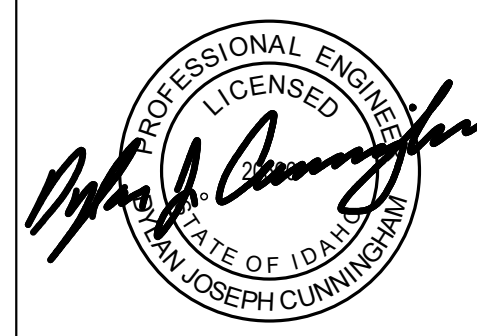



UNIVERSITY OF IDAHO

CLIENT


JOB NO: 240004
CAPITAL PROJECT NO: CP220034

EL2-11

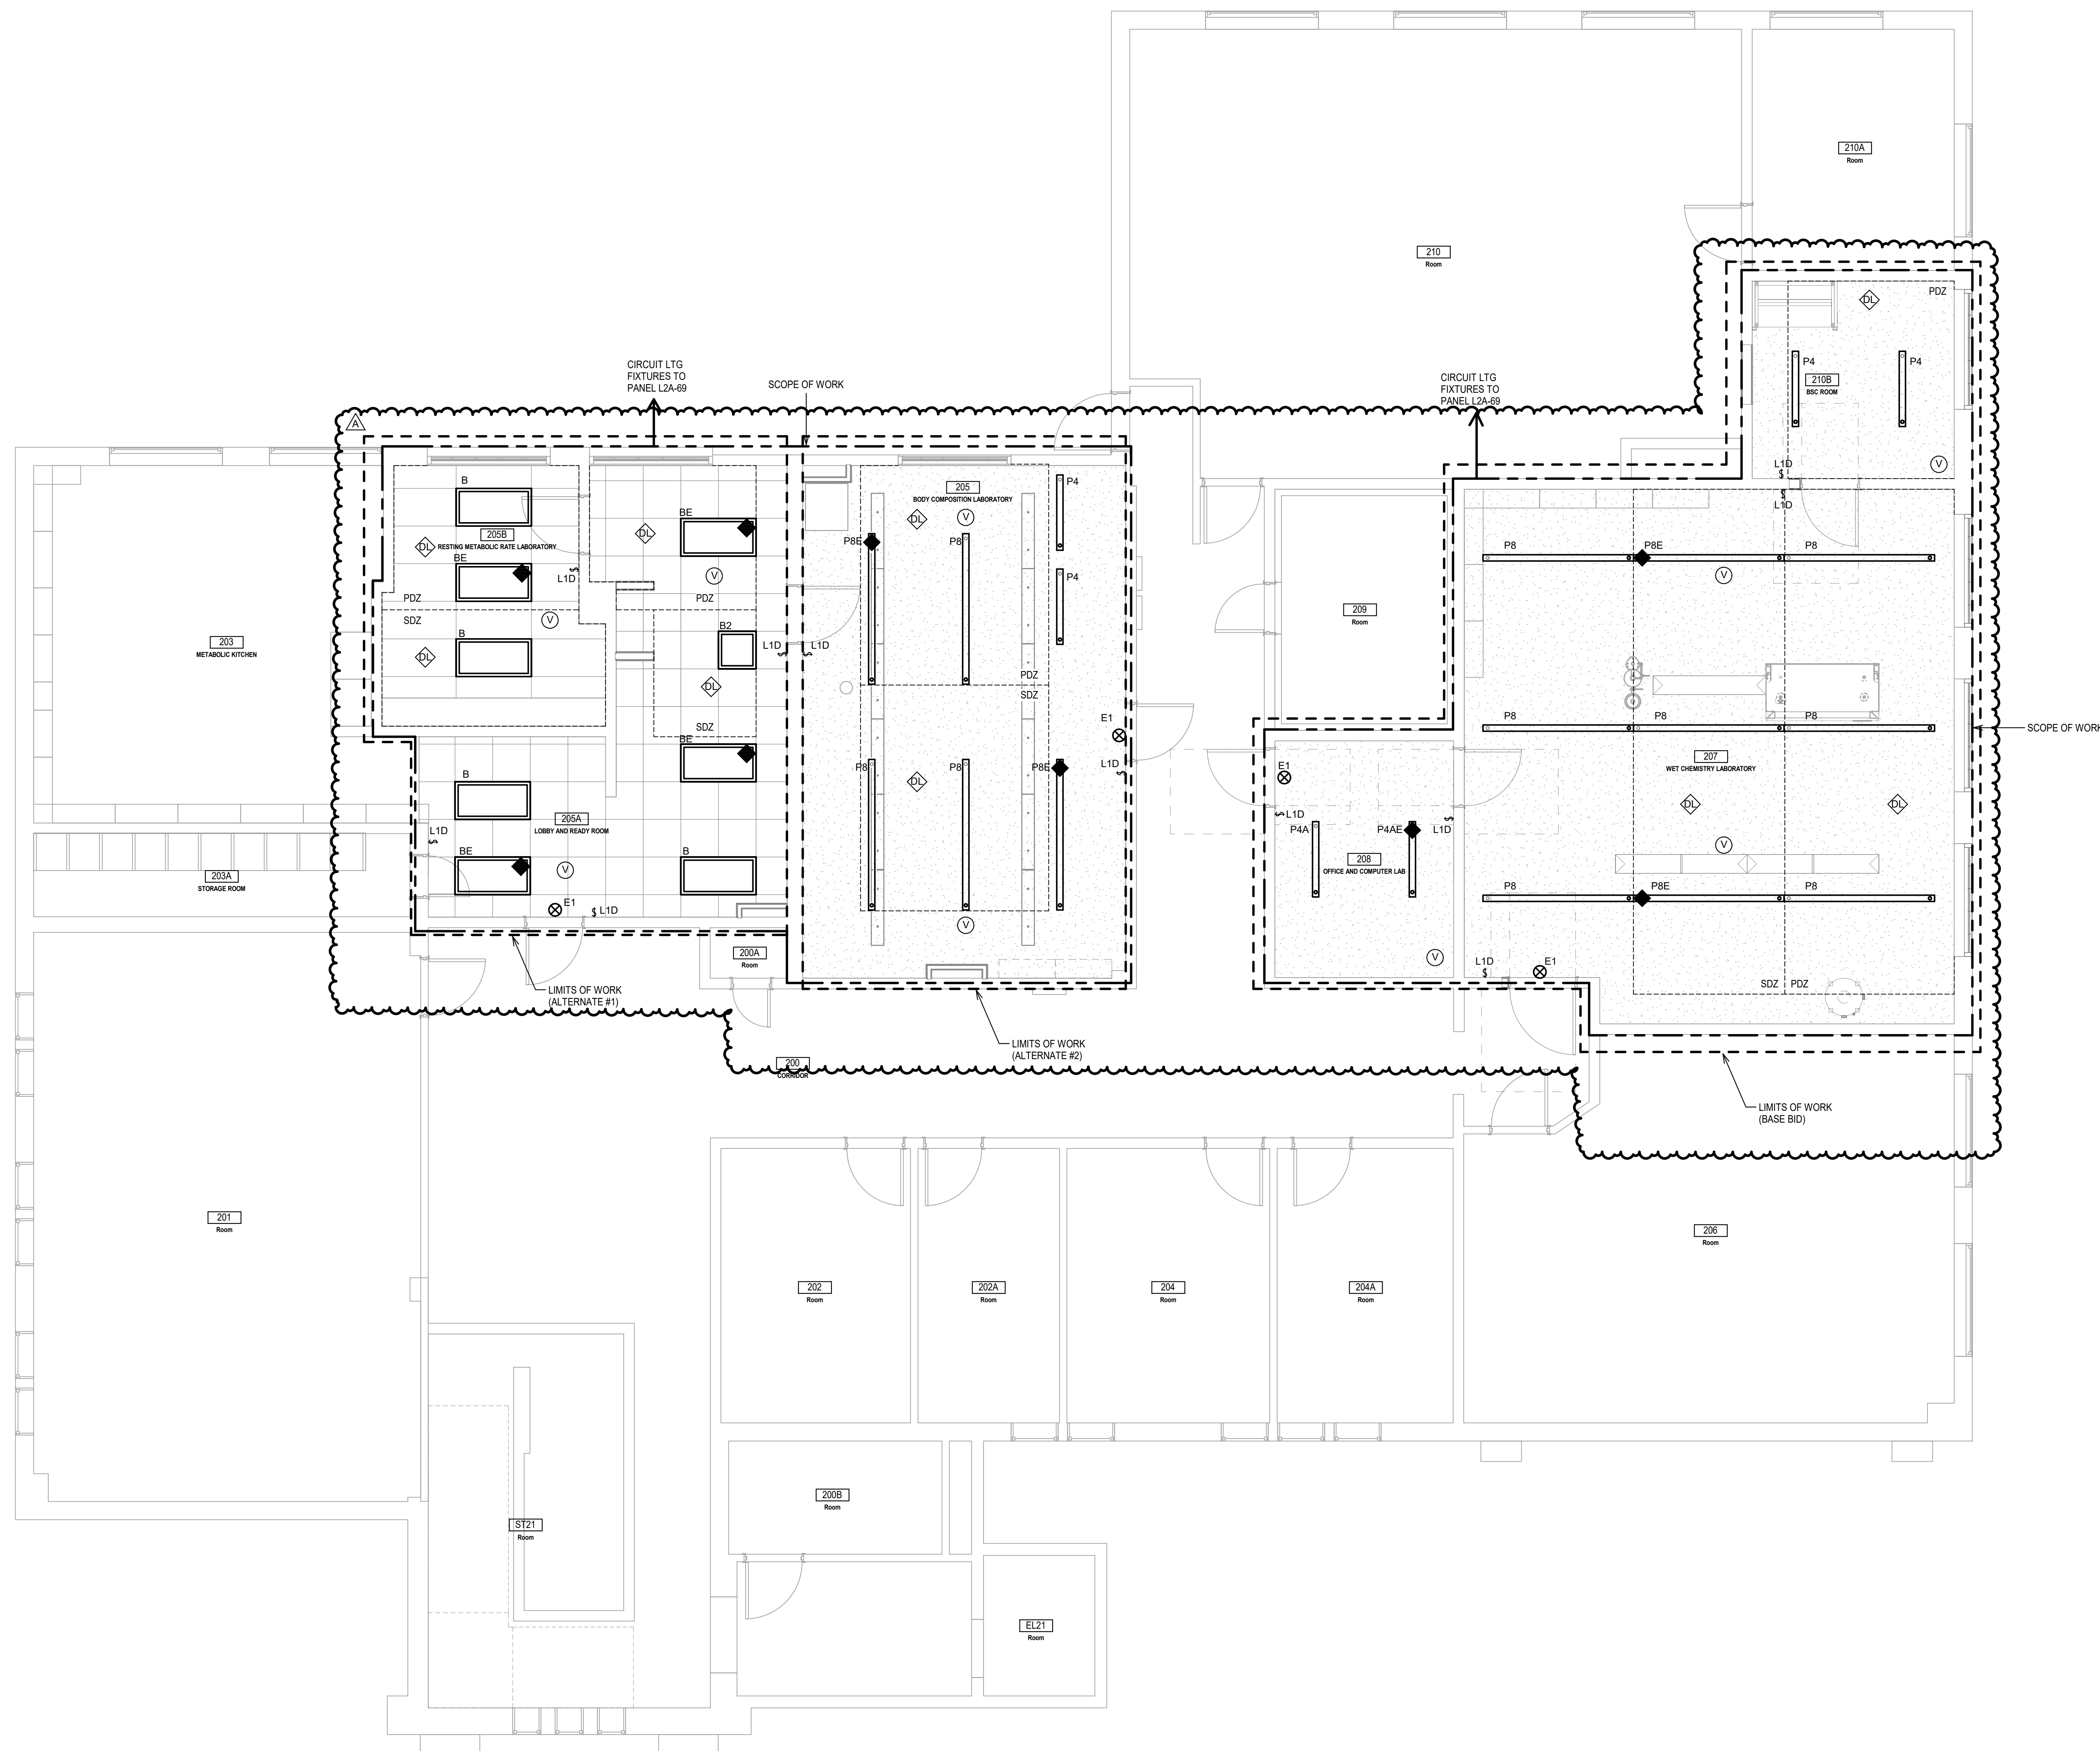

$$1/4'' = 1'-0''$$

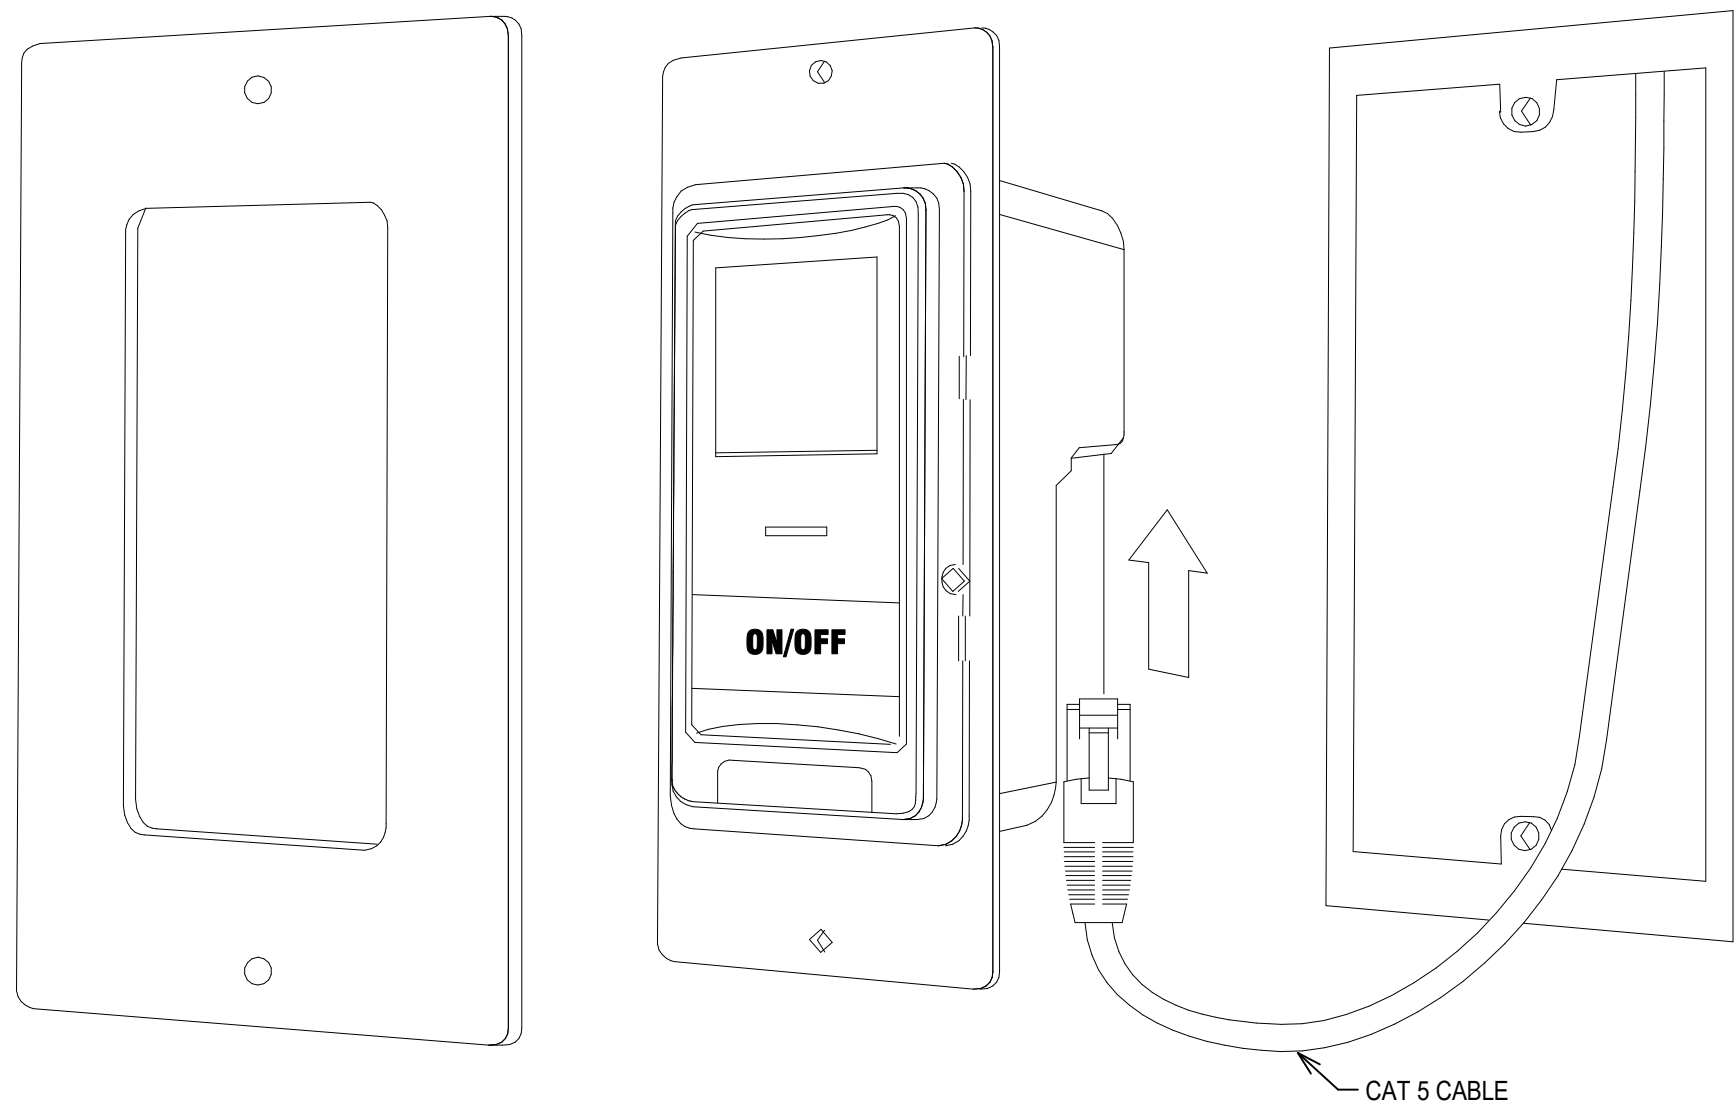


\$LVS **1 ZONE SWITCH WITH VACANCY (\$LVS) / OCCUPANCY (\$LOS) SENSOR**

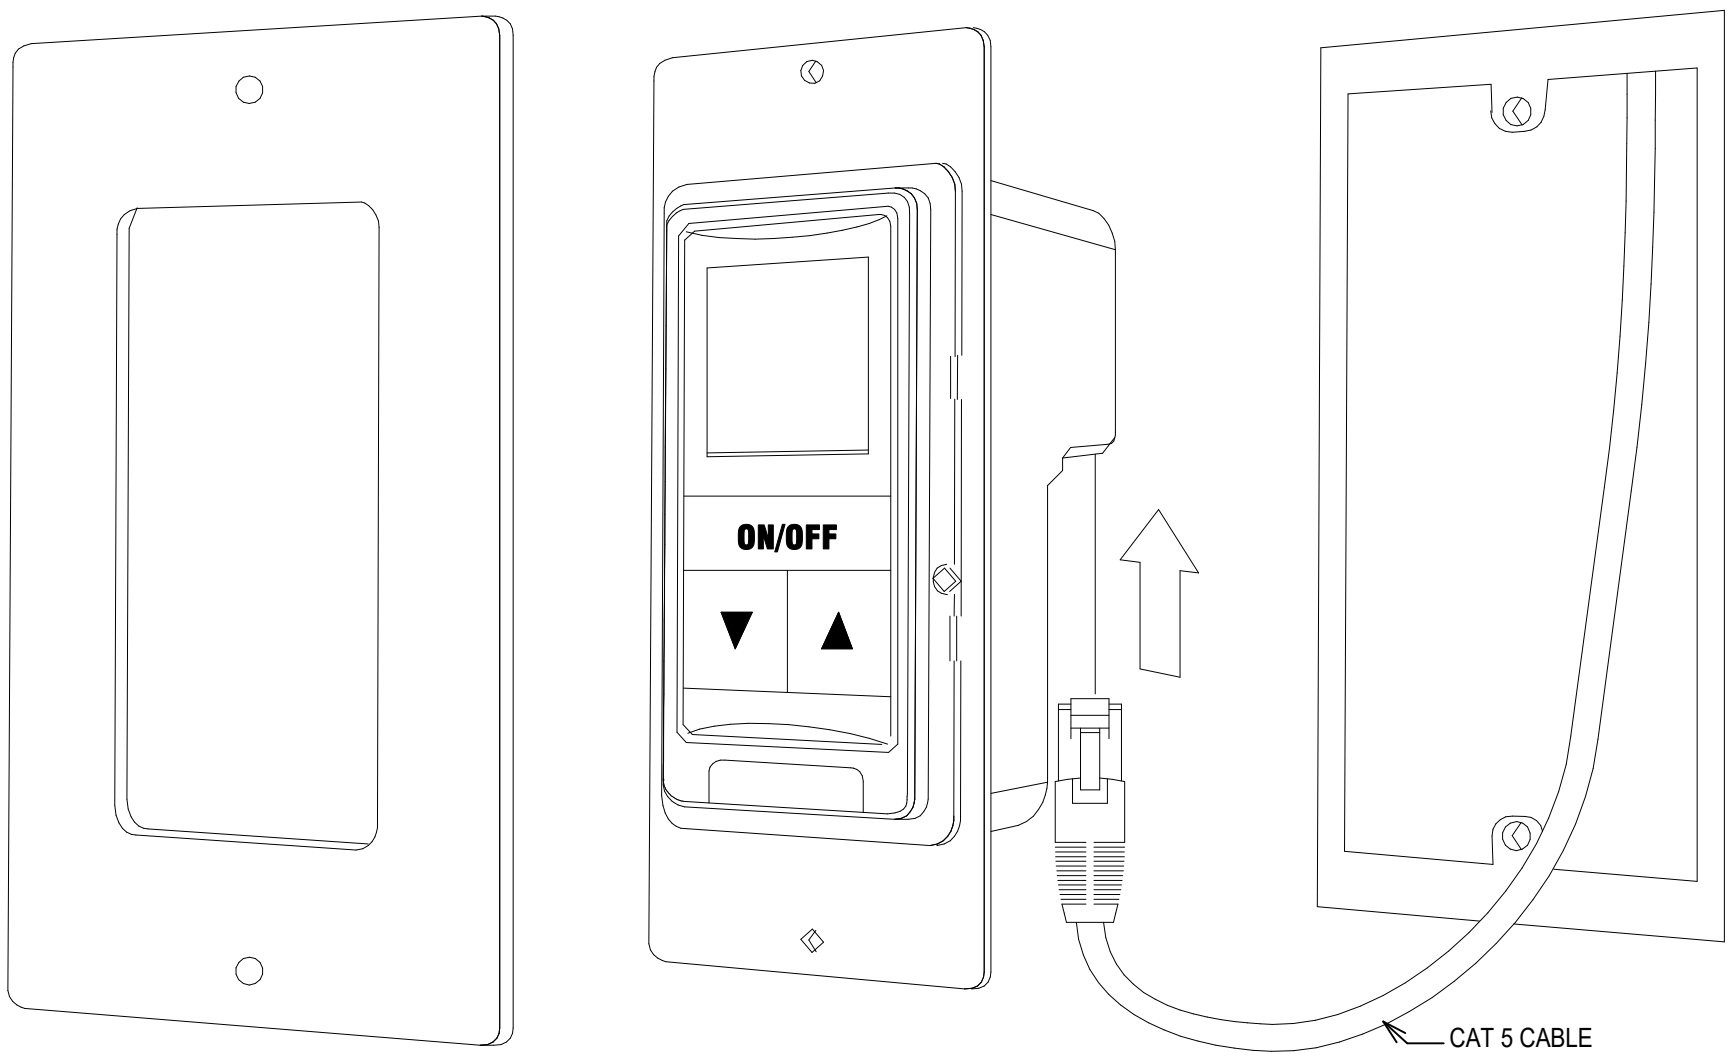


\$LVD **1 ZONE SWITCH WITH VACANCY (\$LVD) / OCCUPANCY (\$LOD) AND DIMMING CONTROL**

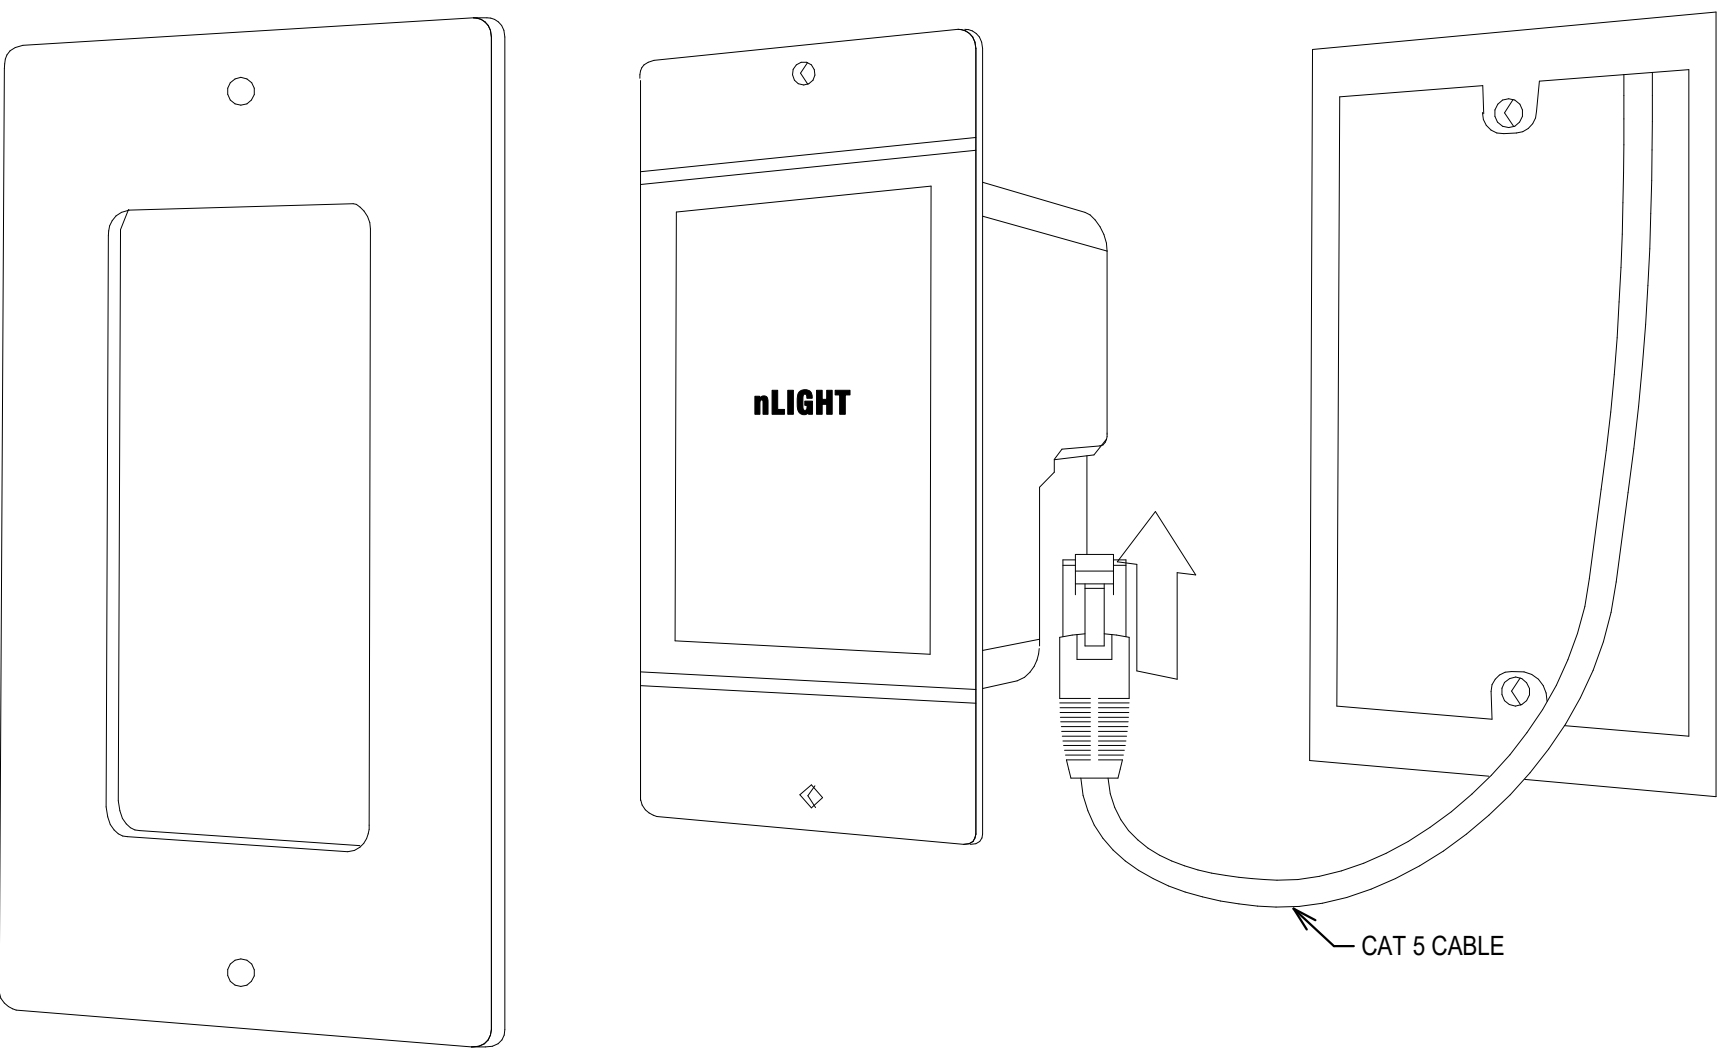


\$LTS **SWITCH - TOUCH SCREEN**

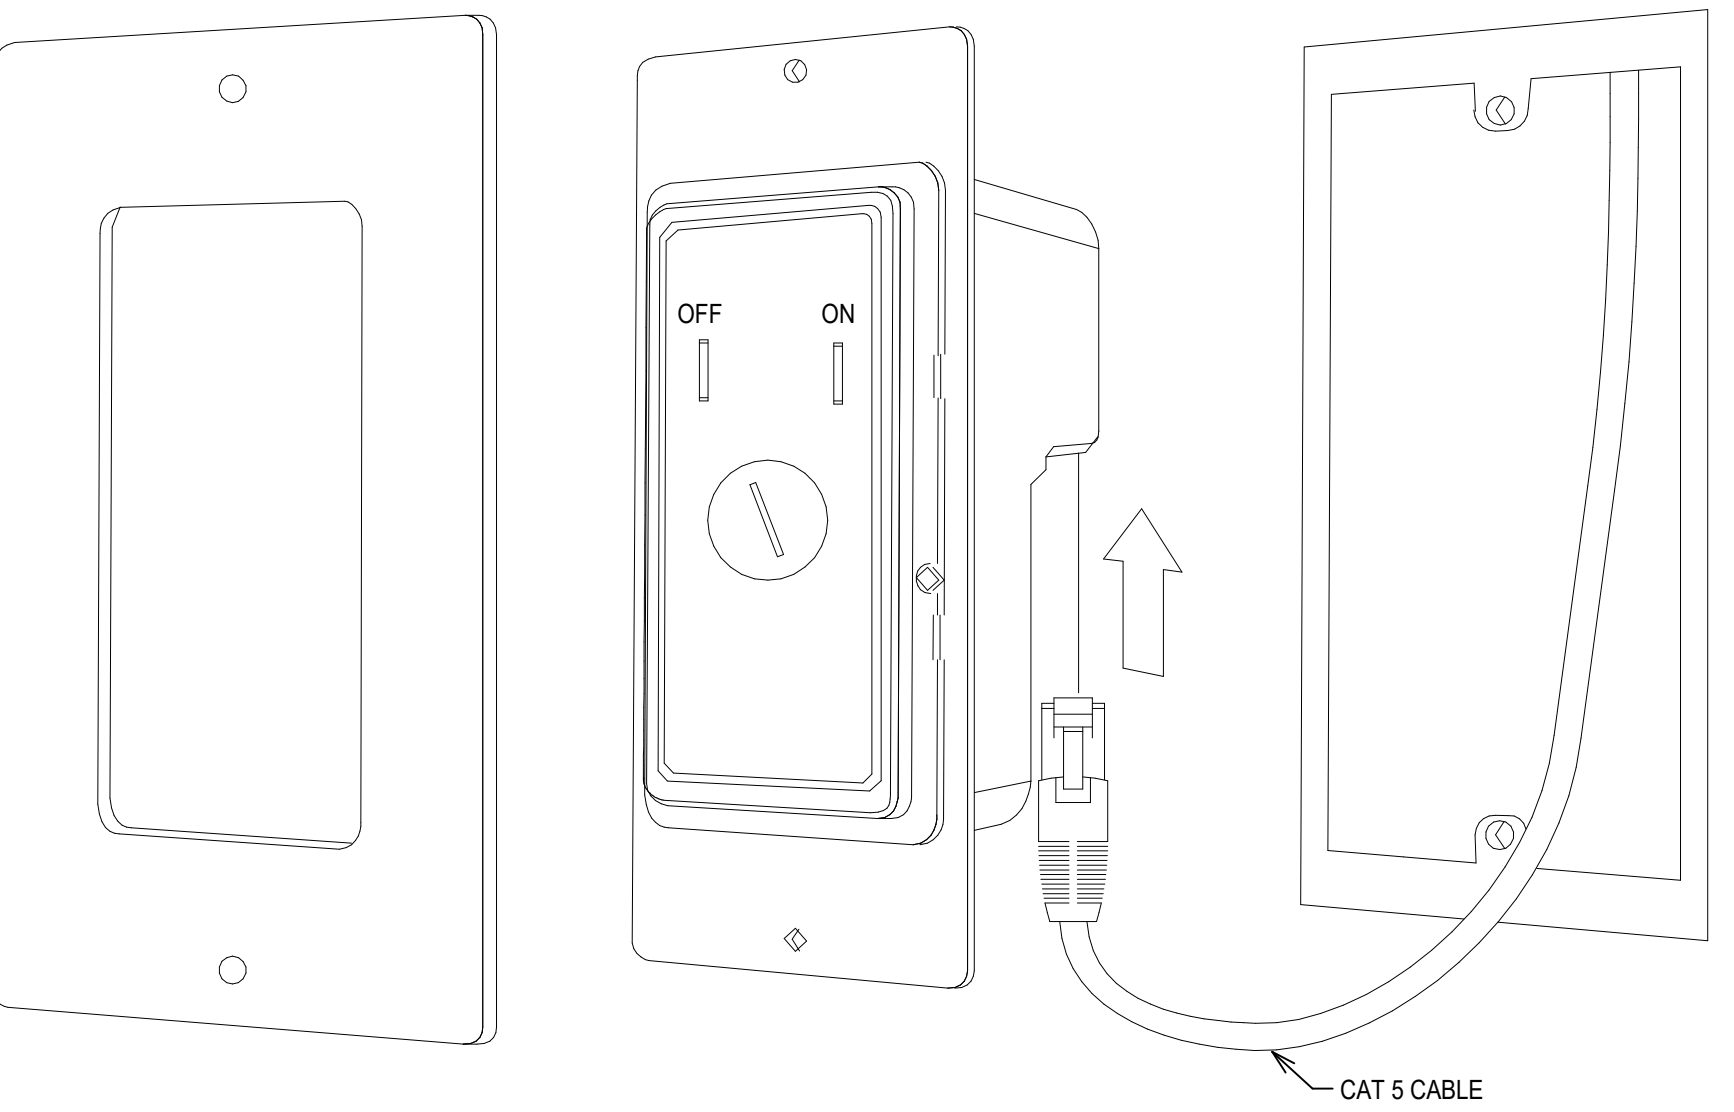


\$LK **KEYED ON/OFF**

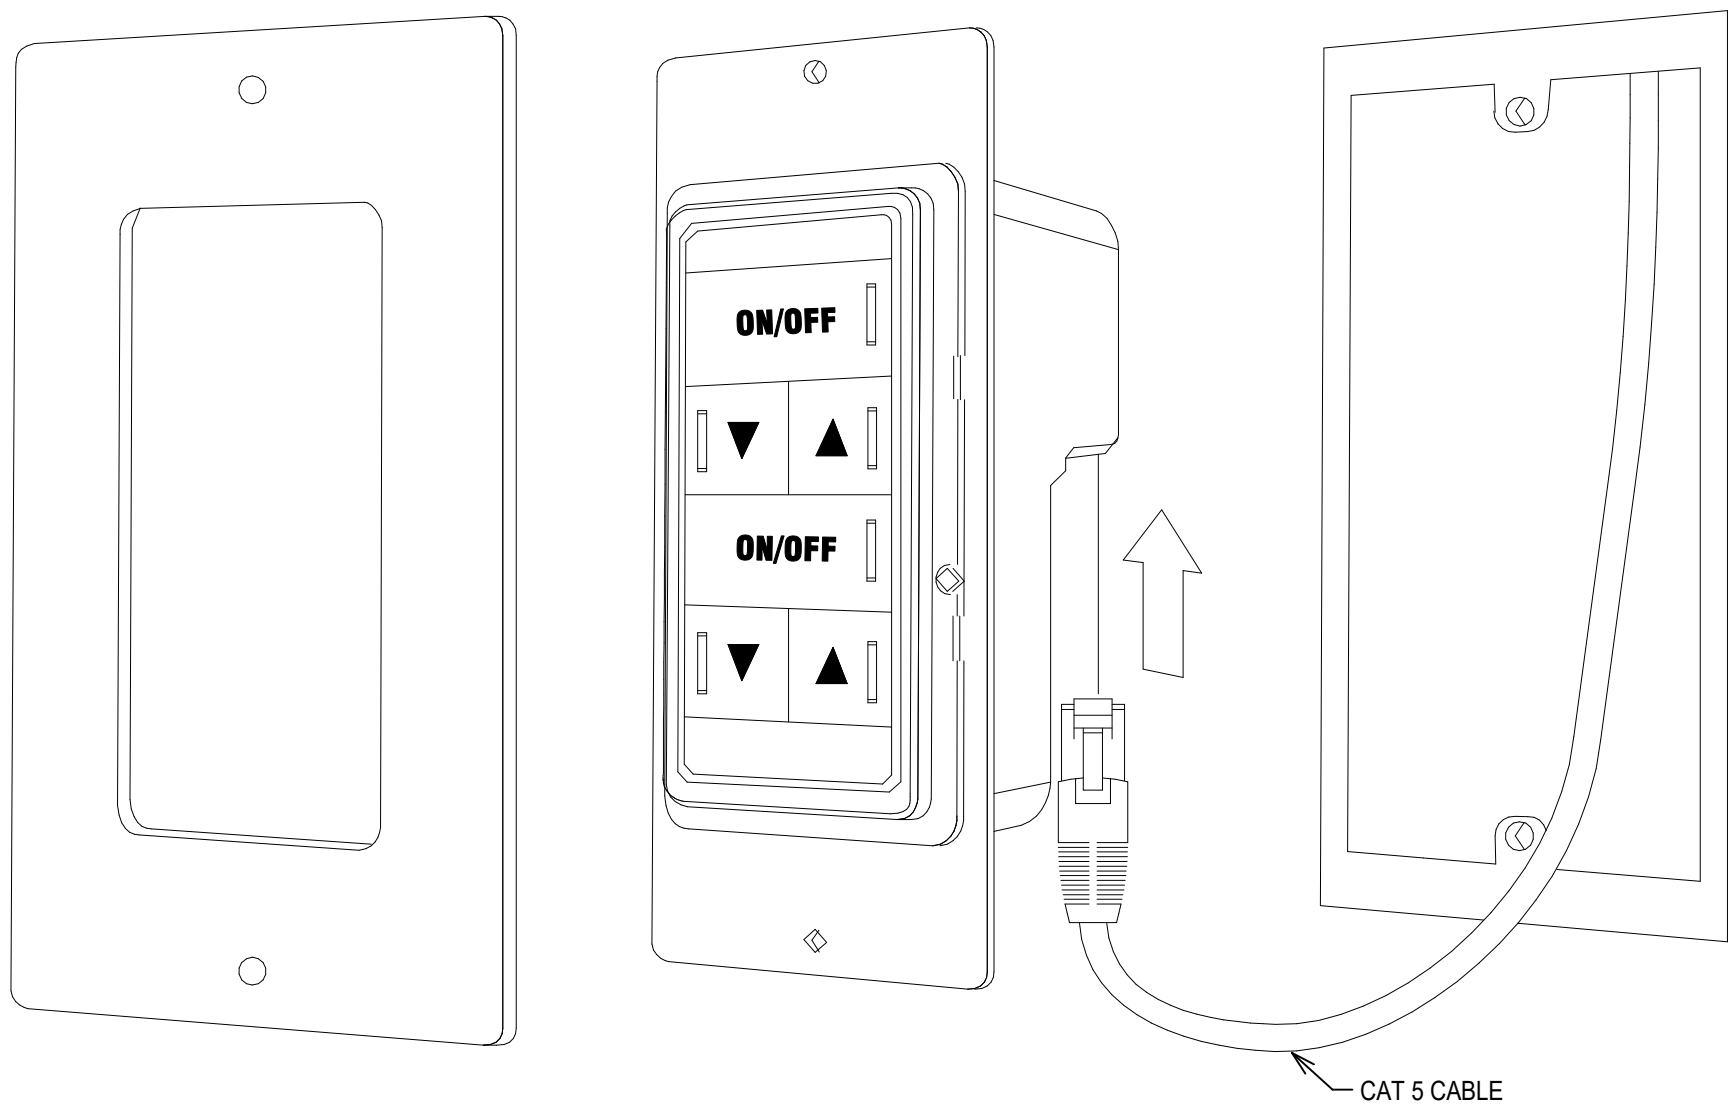


\$L2D **2 ZONE ON/OFF TOGGLE WITH DIMMING**

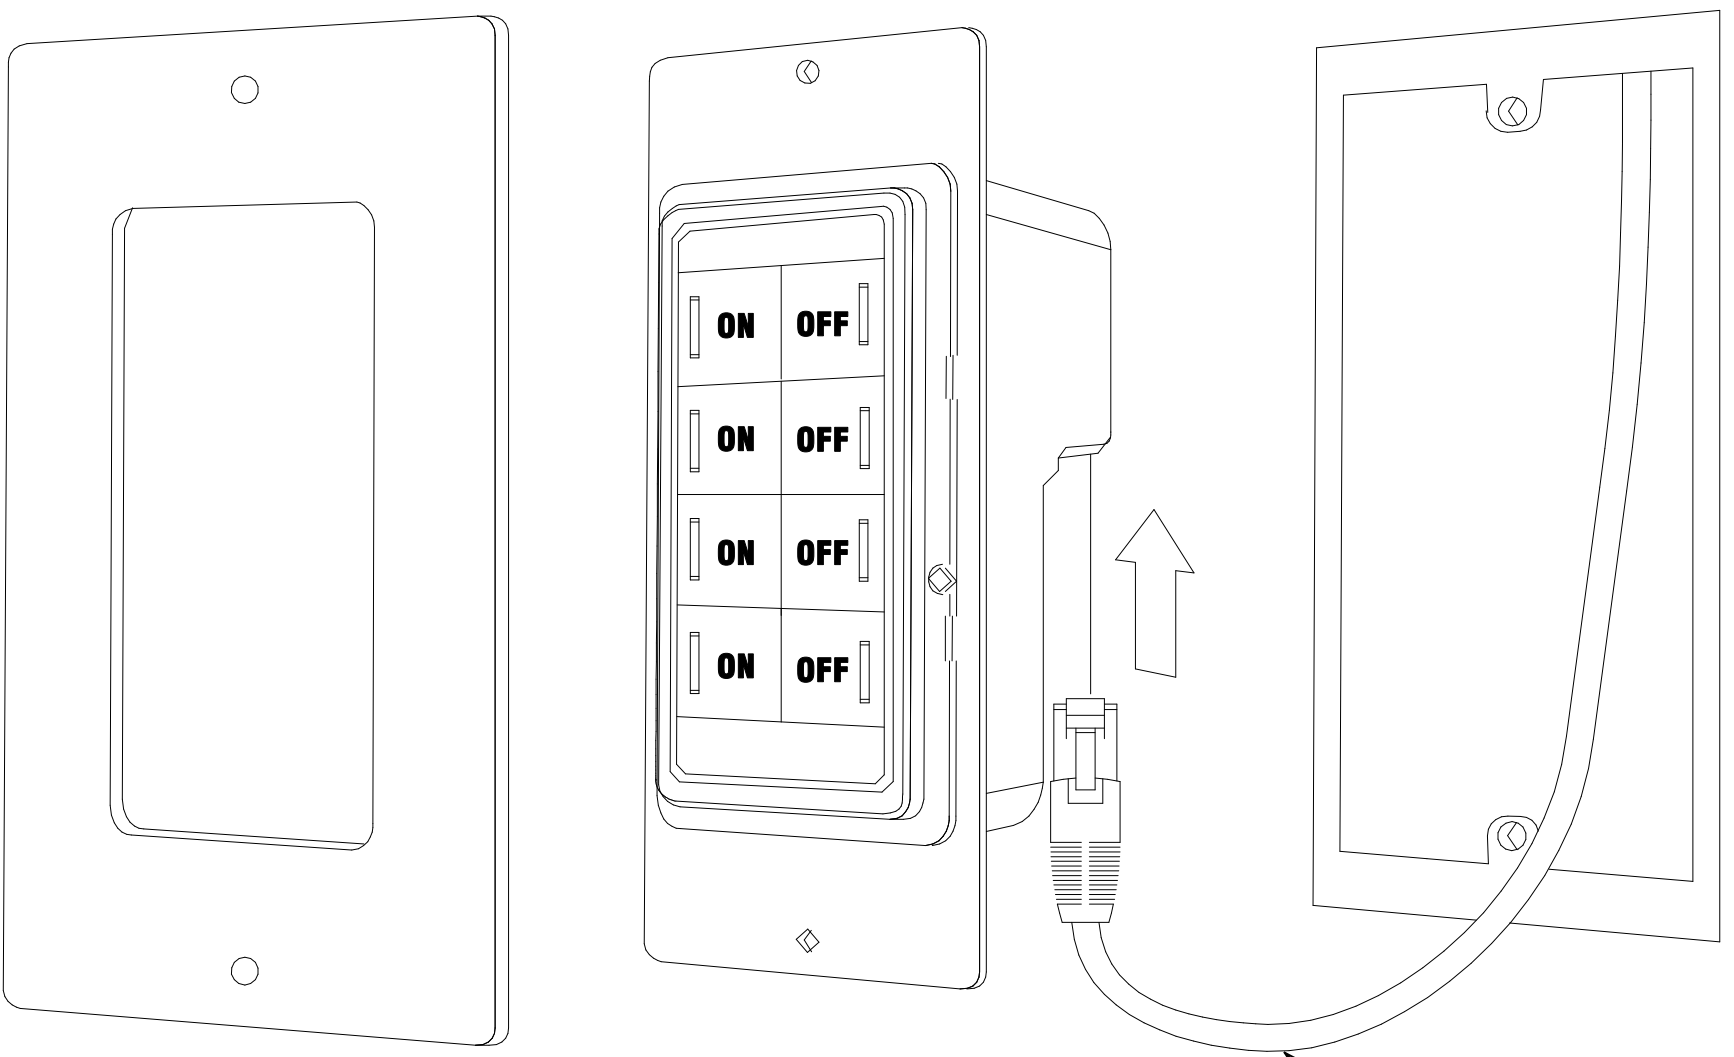

\$L4 **4 ZONE ON/OFF TOGGLE**

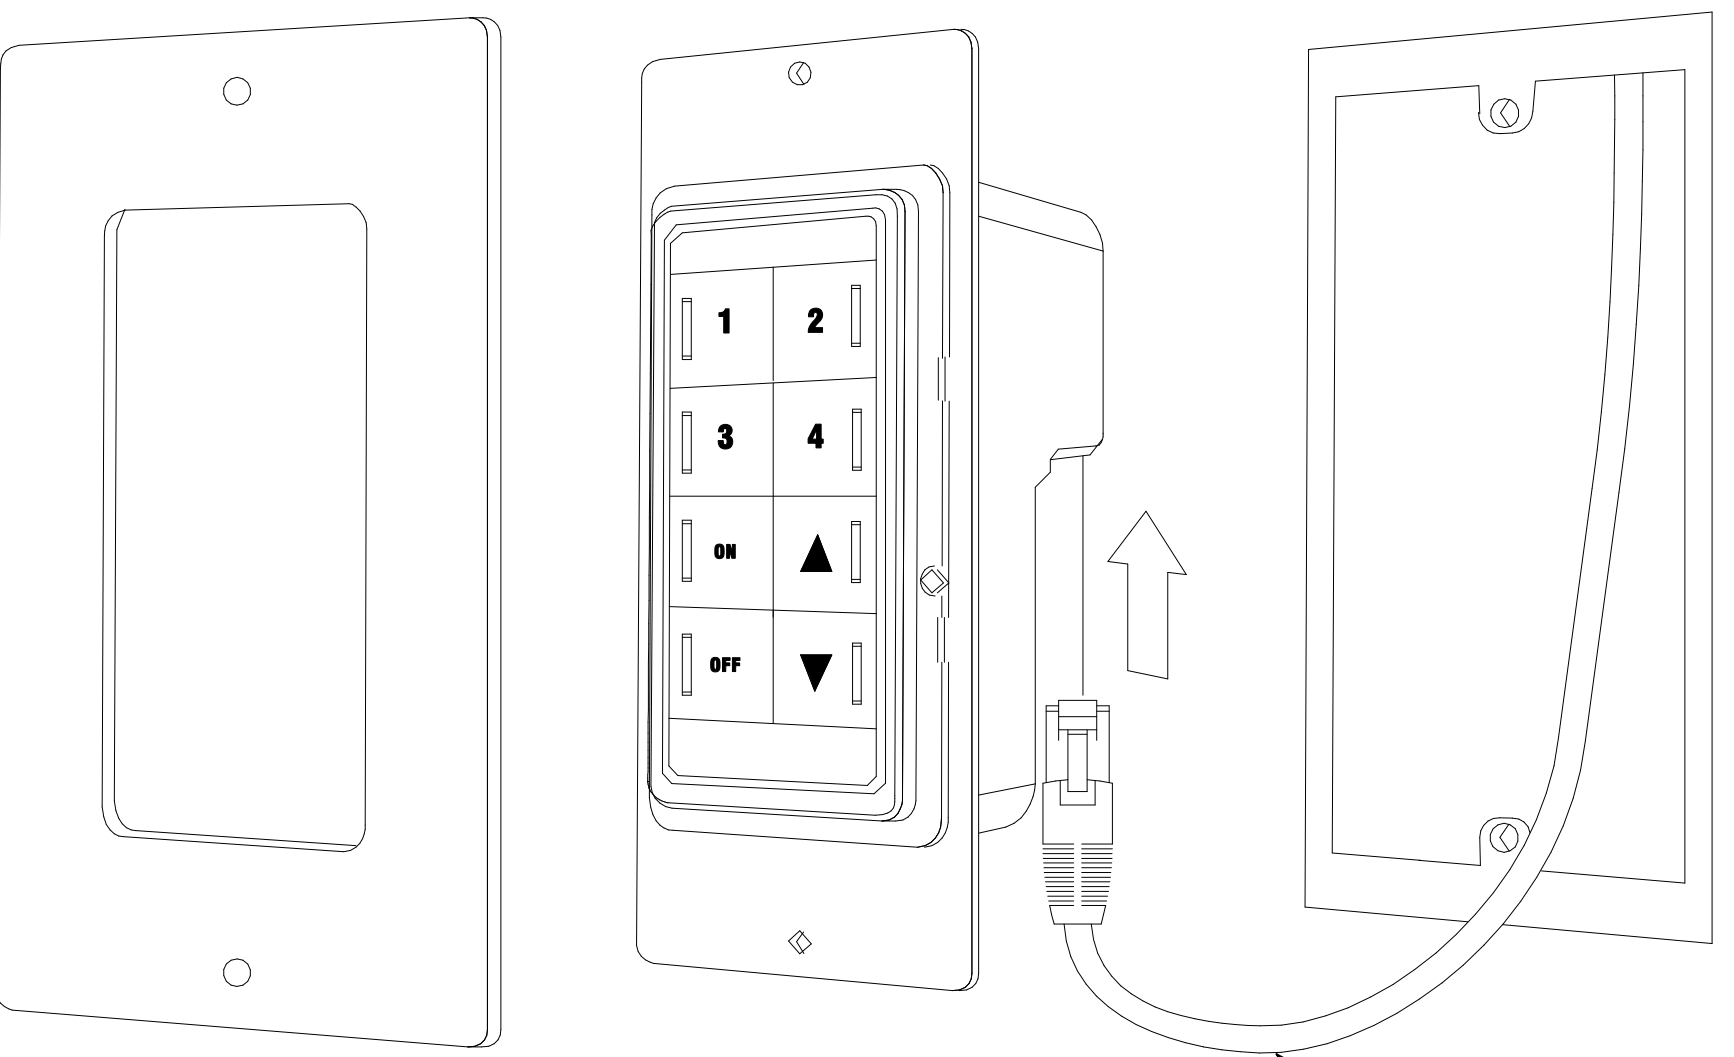

\$L4D **4 ZONE ON/OFF TOGGLE WITH DIMMING**

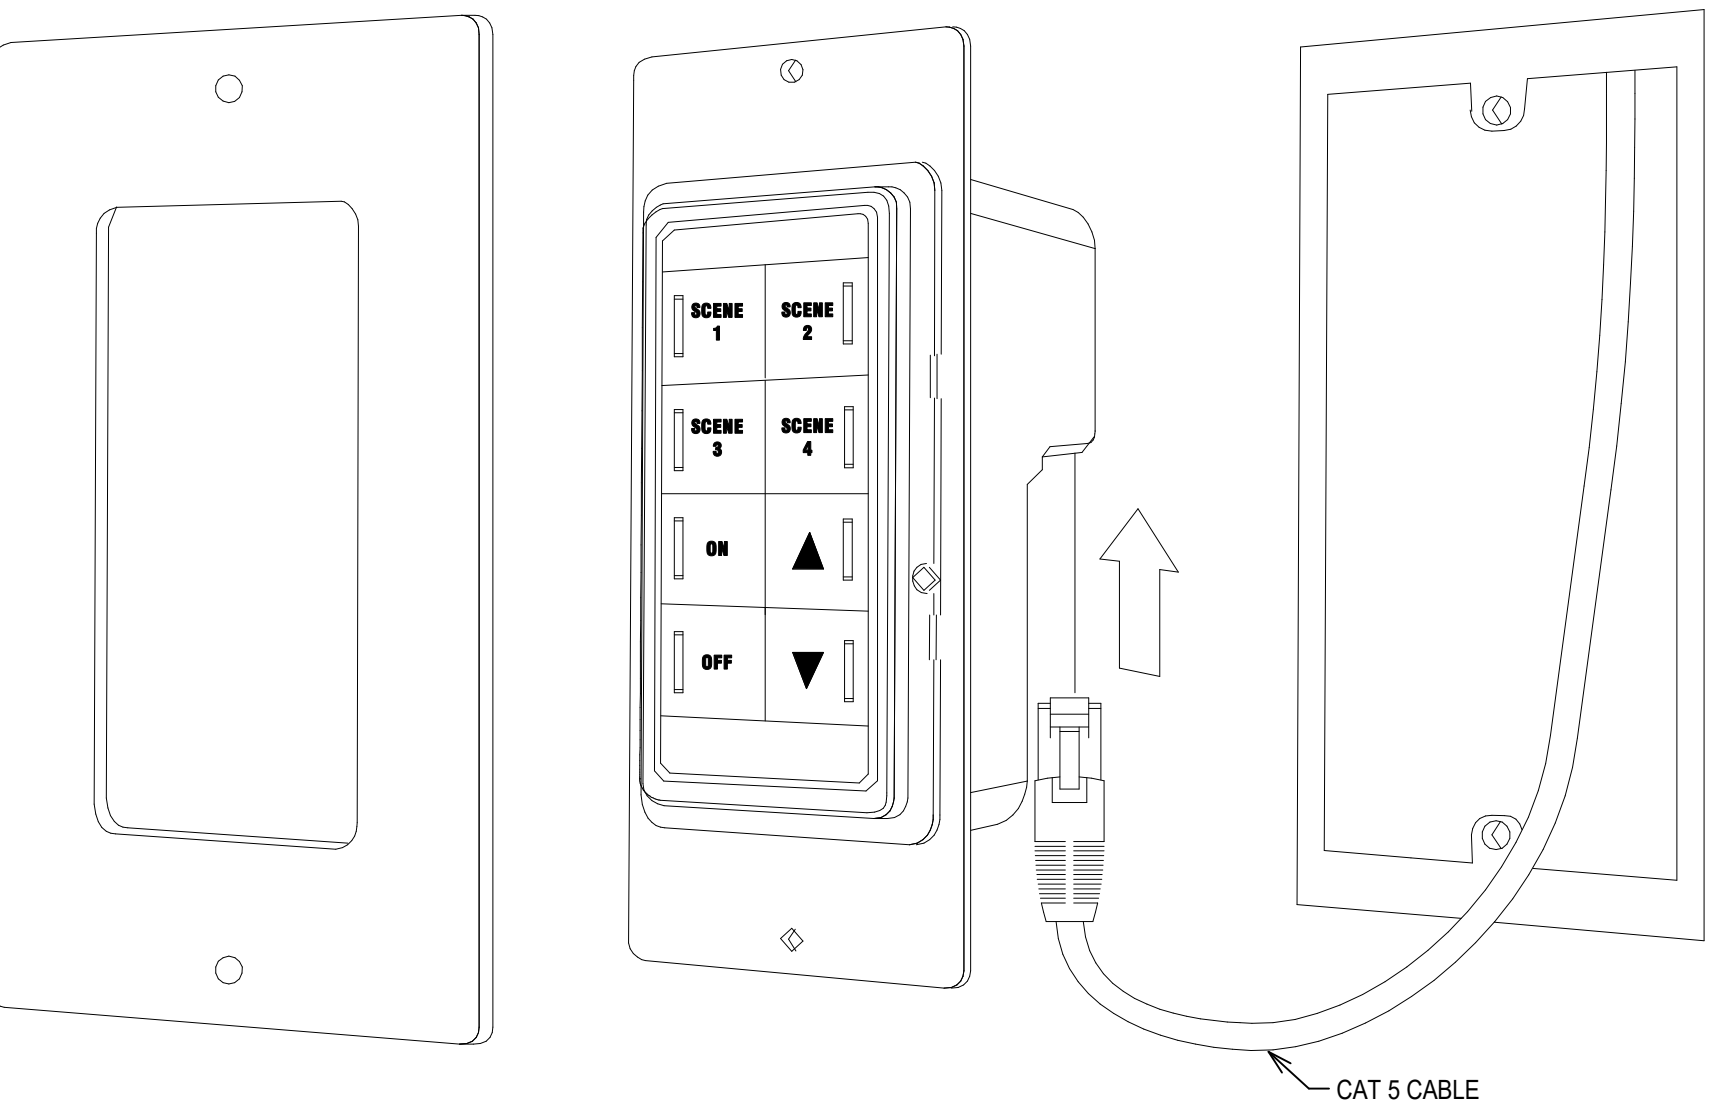


\$L4S **4 SCENE CONTROLLER WITH DIMMING**


LIGHTING CONTROL NOTES:

1. CORRIDORS, LOBBIES AND OTHER COMMON AREAS NOT SHOWN WITH OCCUPANCY SENSORS SHALL BE CONTROLLED VIA TIMESWEEP.
2. EXTERIOR LIGHTING (NOT FACADE OR LANDSCAPE) SHALL REDUCE POWER DENSITY BY MINIMUM 30% BETWEEN 12AM AND 6AM PER ENERGY CODE.
3. EXTERIOR FACADE AND LANDSCAPE LIGHTING SHALL BE CONTROLLED TO AUTOMATICALLY SHUT OFF DAWN TO DUSK VIA TIME CLOCK. PER ENERGY CODE.


NOTE: NOT ALL DETAILS MAY BE INCLUDED IN PROJECT

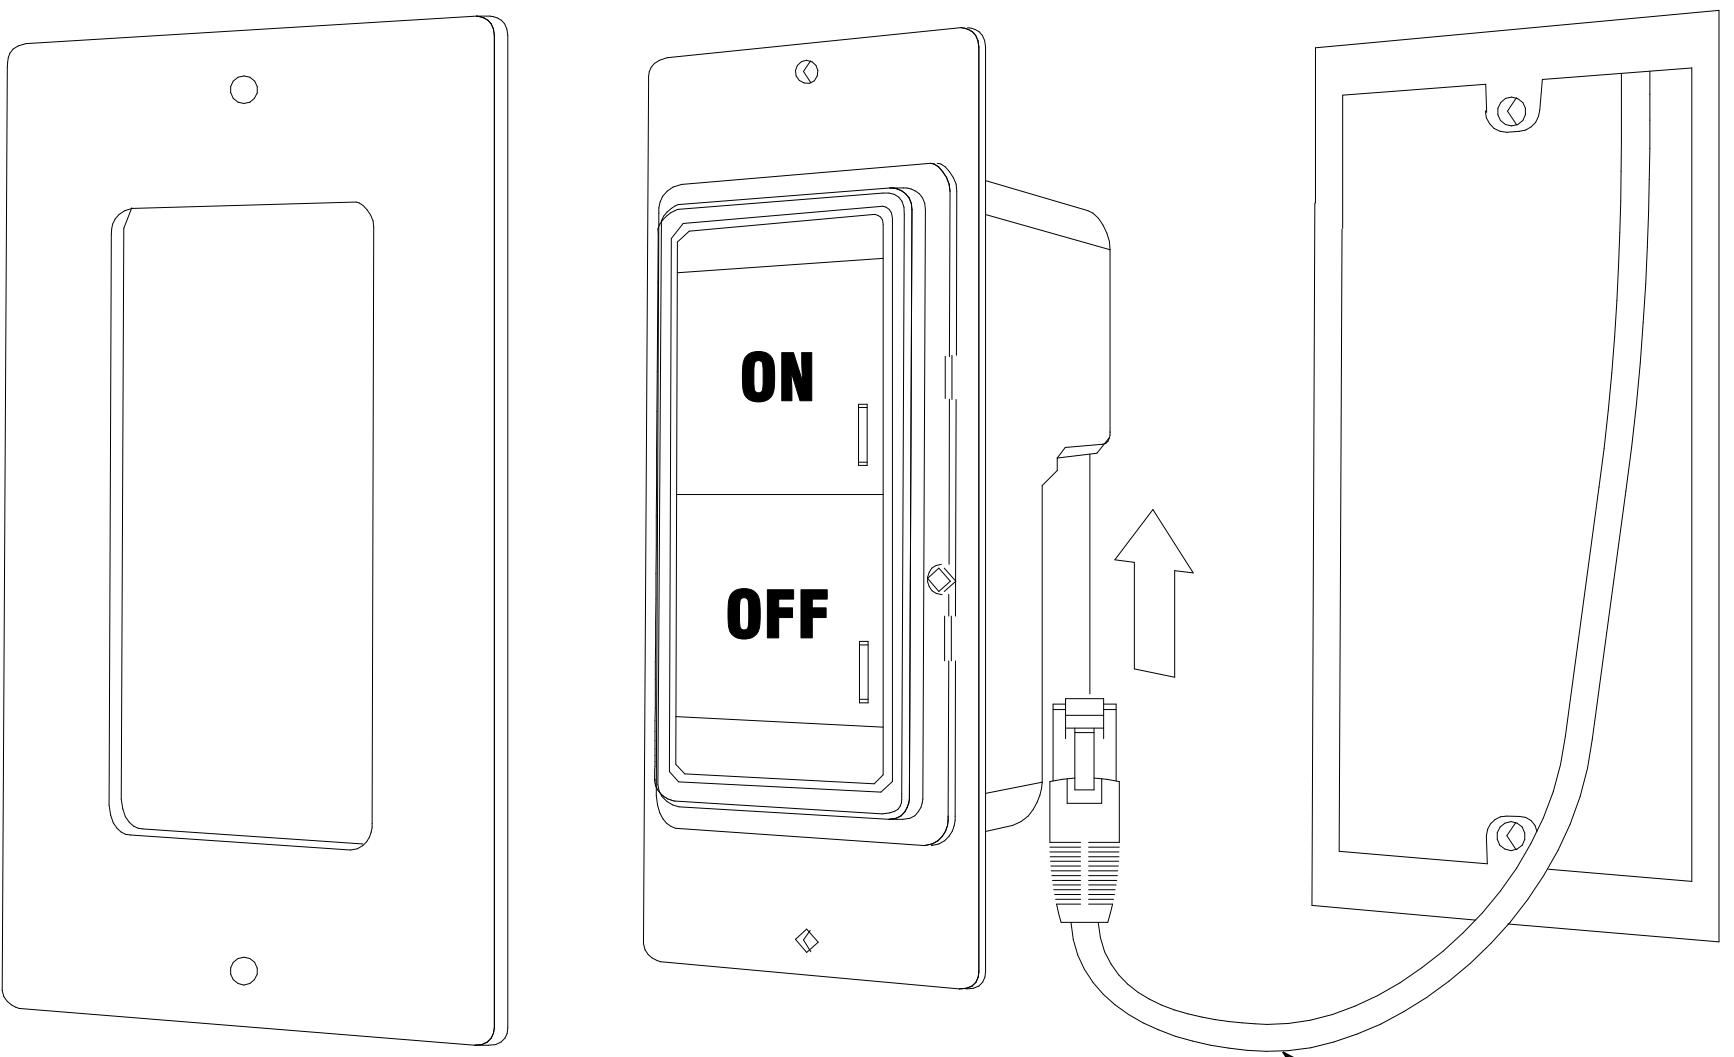

\$L1 **1 ZONE ON/OFF TOGGLE**

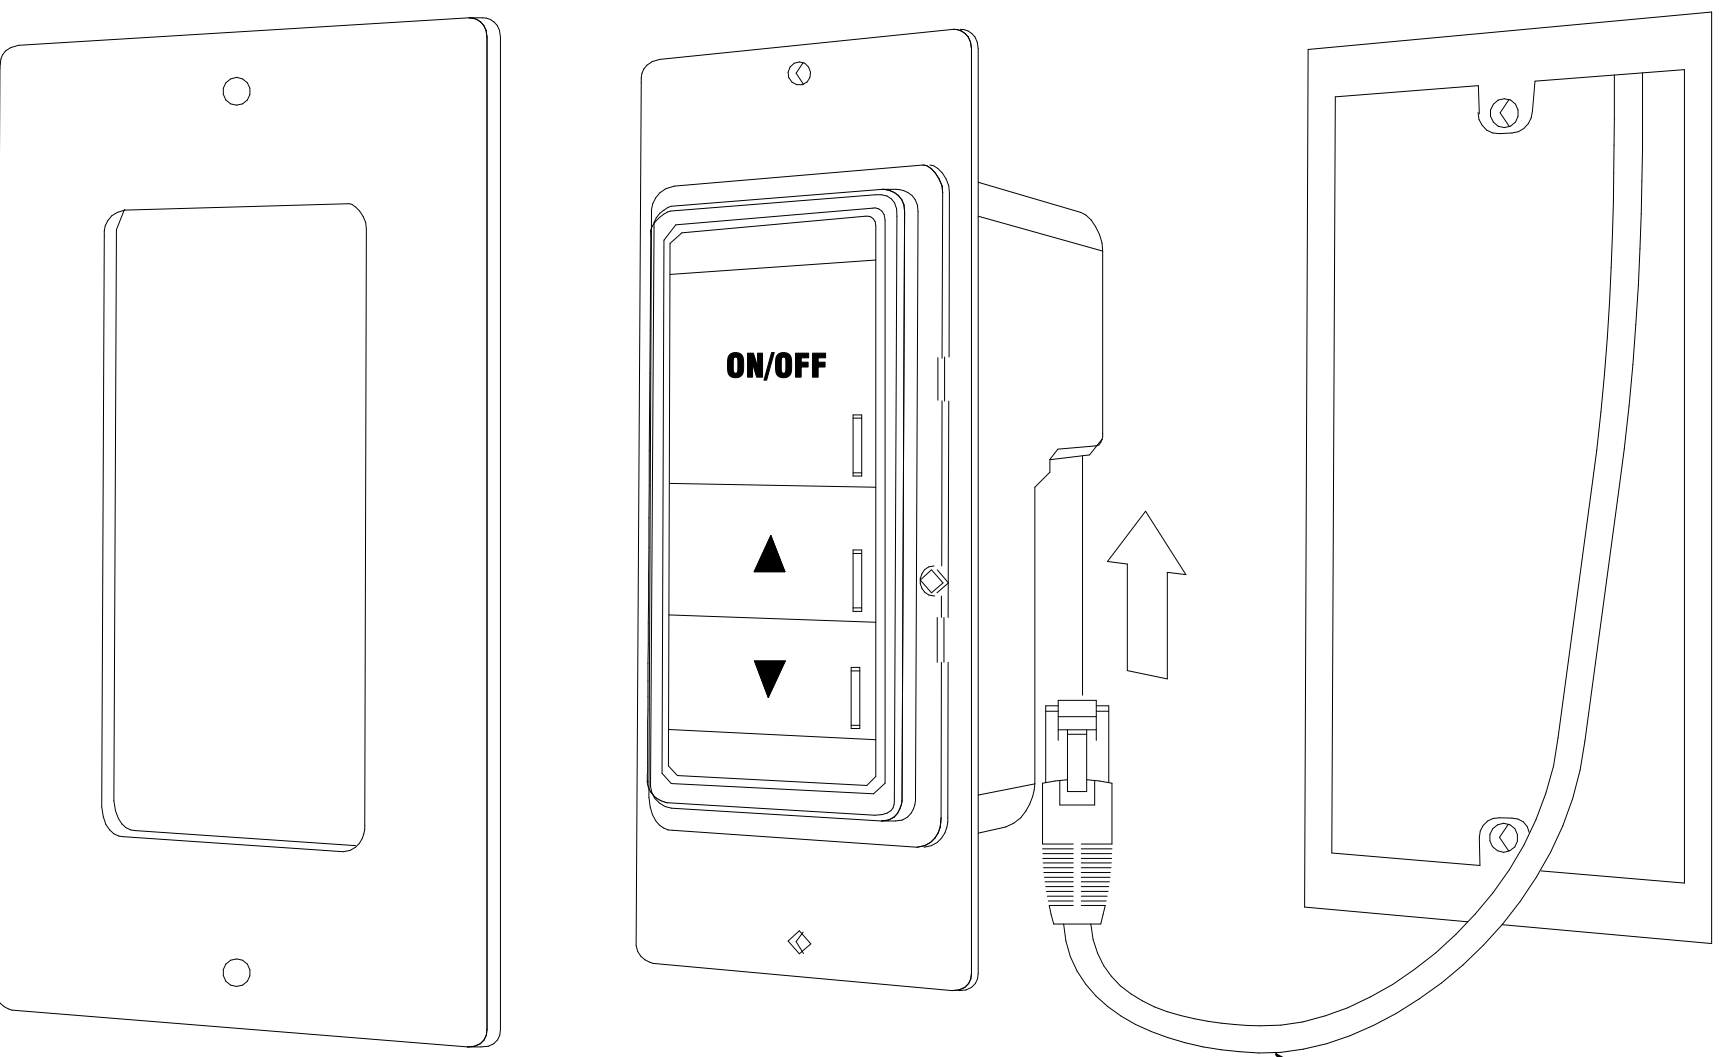


\$L1D **1 ZONE ON/OFF TOGGLE WITH DIMMING**

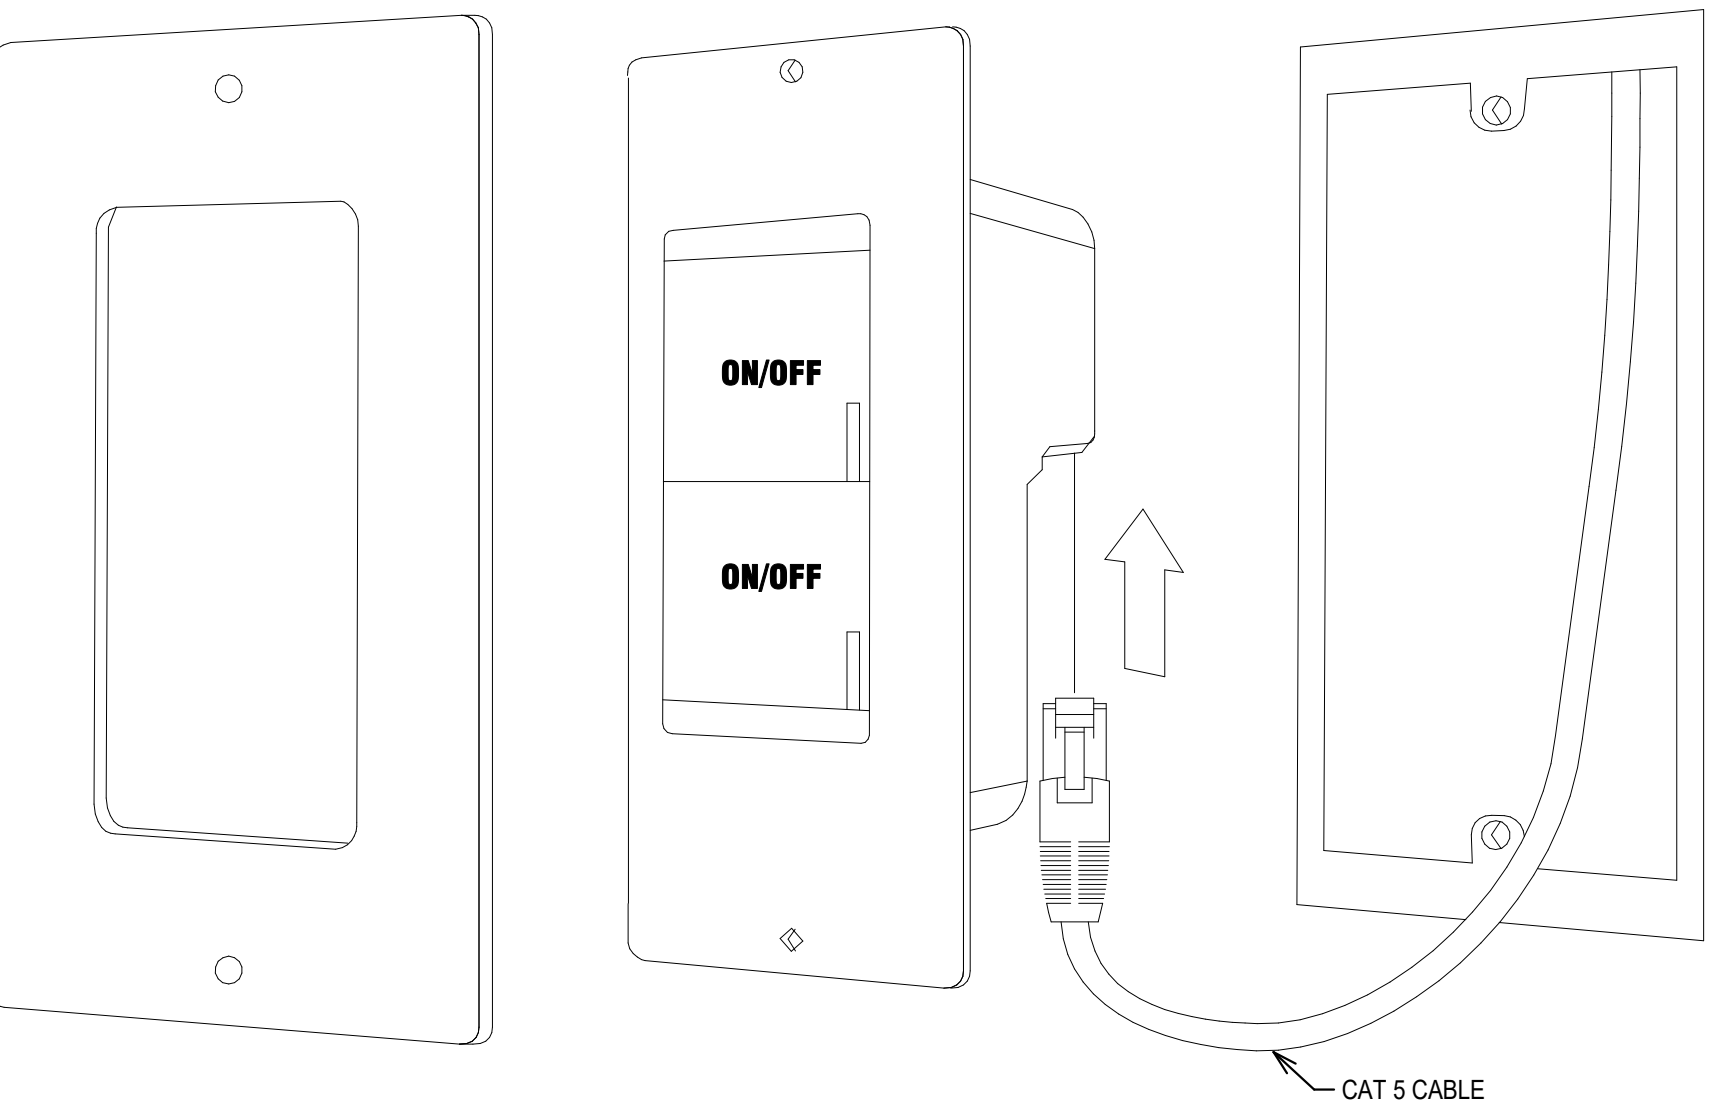

\$L2 **2 ZONE ON/OFF TOGGLE**

ISSUE DATE: **07.21.2025**

REV DATE COMMENT

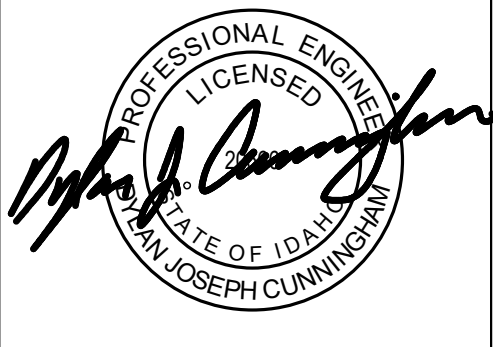

DETAILS - LIGHTING

TITLE **PROJECT** **CLIENT**

FOOD RESEARCH CENTER TI - PHASE 1 (BUILDING #: 005)

860 IDAHO AVE, MOSCOW, ID 83844

UNIVERSITY OF IDAHO

JOB NO: **240004**
CAPITAL PROJECT NO: **CP220034**

EL5-01



THESE DOCUMENTS HAVE BEEN PRODUCED AS AN INSTRUMENT OF SERVICE AND ARE INTENDED SOLELY FOR THE PURPOSES OF INSTRUCTING, USING AND MAINTAINING THE PROJECT. **KNIT** AS THE CUSTODIAN OF RECORD FOR THE PROJECT RETAINS OWNERSHIP OF THESE DOCUMENTS.

USE OF THESE DOCUMENTS OR USE OF THIS DESIGN, IDEAS OR CONCEPTS DESCRIBED HEREIN IN WHOLE OR PART BY ANY MEANS WHATSOEVER IS STRICTLY PROHIBITED EXCEPT BY WRITTEN CONSENT OF **KNIT**.

REPRODUCTION OF THIS DOCUMENTS IS STRICTLY PROHIBITED EXCEPT BY WRITTEN CONSENT OF **KNIT**.



01 W First Ave, St 1300
Spokane, WA 99201, USA
09.838.9020
www.mwengineers.com/escent


REV	DATE	COMMENT
-----	------	---------







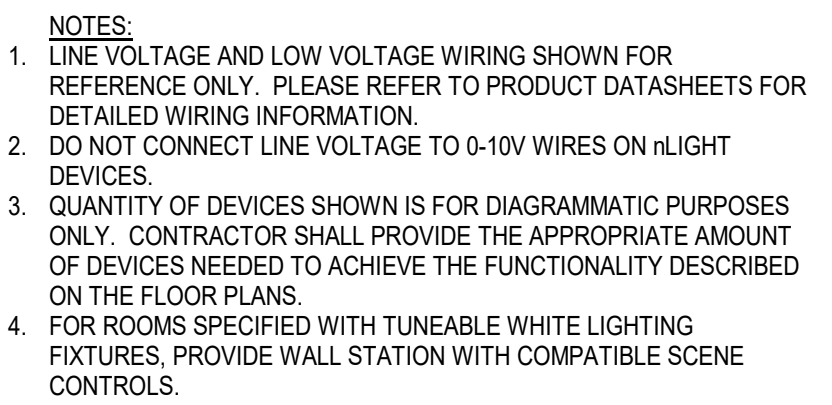

860 IDAHO AVE, MOSCOW, ID 83844

JOB NO: **240004**
CAPITAL PROJECT NO: **CP220034**

EL5-02



WIRE LEGEND	
	CAT 5-E (CLASS 2)
	LINE VOLTAGE
	18/2 CONTACT CLOSURE
	LOW VOLTAGE (1A @ 40 VDC/VAC)
	15-24 VDC POWER
	ETHERNET LAN (CLASS 2)

1 TYPICAL LIGHTING CONTROL RISER
N.T.S.

1. FIELD VERIFY EXISTING CONDITIONS PRIOR TO COMMENCING WORK.



THESE DOCUMENTS HAVE BEEN PRODUCED AS AN INSTRUMENT OF SERVICE AND ARE INTENDED SOLELY FOR THE PURPOSE OF CONSTRUCTING, USING AND MAINTAINING THE PROJECT. KNIIT AS THE ARCHITECT OF RECORD FOR THE PROJECT RETAINS OWNERSHIP OF THESE DOCUMENTS.


ANY USE OF THESE DOCUMENTS OR USE OF THIS DESIGN, IDEAS OR CONCEPTS DESCRIBED HEREIN IN WHOLE OR PART BY ANY MEANS WHATSOEVER IS STRICTLY PROHIBITED EXCEPT BY WRITTEN CONSENT OF KNIIT.

REPRODUCTION OF THIS DOCUMENTS IS STRICTLY PROHIBITED EXCEPT BY WRITTEN CONSENT OF KNIIT.



ISSUE DATE: 07.21.2025

REV	DATE	COMMENT
A	7/21/2025	Owner Revision

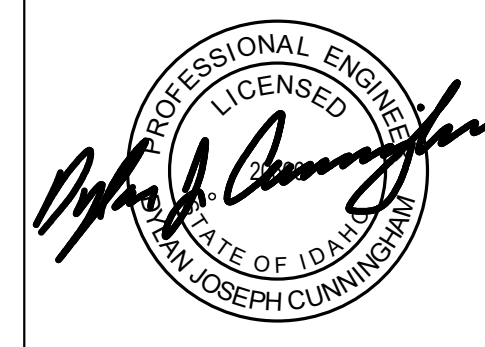

DEMO FLOOR PLAN - FIRE ALARM


FOOD RESEARCH CENTER TI - PHASE 1 (BUILDING #: 005)

8660 IDAHO AVE. MOSCOW, ID 83844

UNIVERSITY OF IDAHO

TITLE	PROJECT	CLIENT
JOB NO: 240004 CAPITAL PROJECT NO: CP220034		

FAD2-11

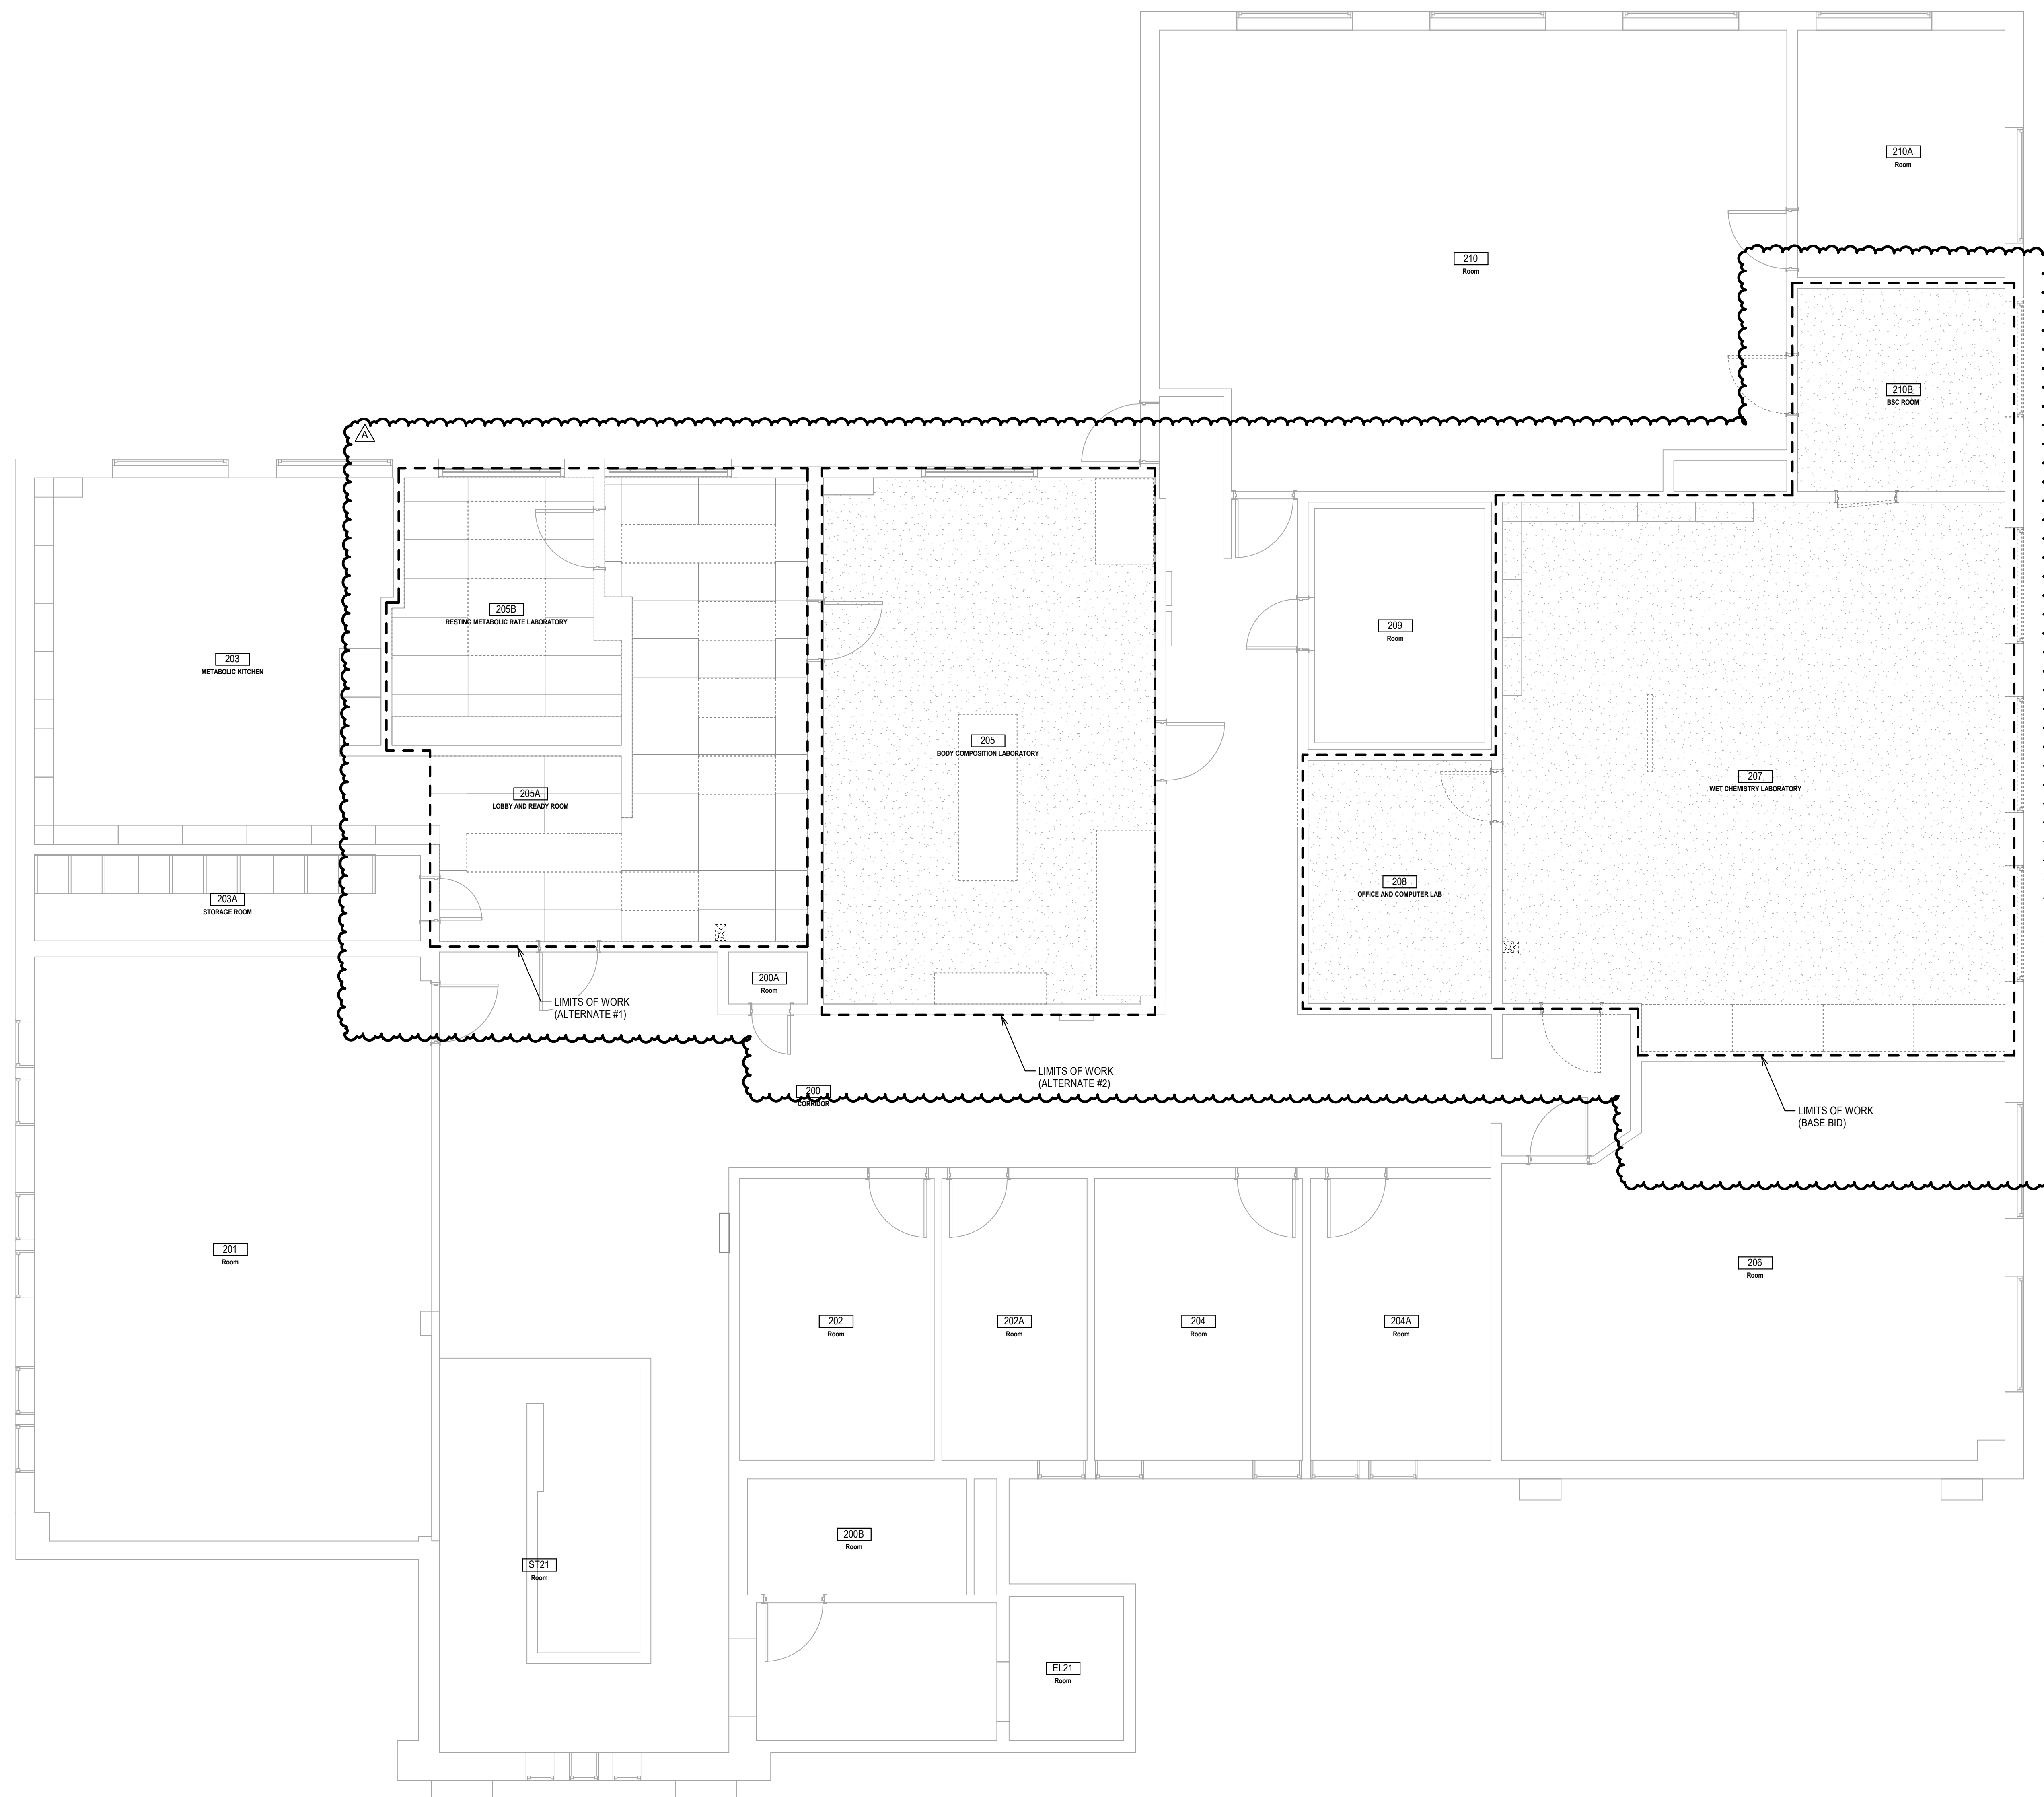

LEVEL 2 - DEMO PLAN - FIRE ALARM
1/4" = 1'-0"

3



WAP



COMMUNICATIONS SYMBOLS

3-PORT COMMUNICATIONS OUTLET, (1) 3-PORT FACEPLATE WITH (3) 8-POSITION CAT 6A RJ-45 JACKS, WALL FLUSH MOUNTED 18" AFF, UNLESS NOTED OTHERWISE. REFER TO SHEET TS-01 DETAIL 1 FOR OUTLET DETAIL.

3-PORT COMMUNICATIONS OUTLET, (1) 3-PORT FACEPLATE WITH (3) 8-POSITION CAT 6A RJ-45 JACKS, WALL FLUSH MOUNTED 18" AFF, UNLESS NOTED OTHERWISE. REFER TO SHEET TS-01 DETAIL 1 FOR OUTLET DETAIL.


COMMUNICATIONS ABBREVIATIONS

AFF	ABOVE FINISHED FLOOR
ANSI	AMERICAN NATIONAL STANDARDS INSTITUTE
AWG	AMERICAN WIRE GAUGE
BB	BACKBONE
BIX	BIX BLOCK
C	CONDUIT
CAT 3	CATEGORY 3
CAT 5	CATEGORY 5
CAT 5E	CATEGORY 5, ENHANCED
CAT 6	CATEGORY 6
CONN	CONNECTOR
CFCI	CONTRACTOR FURNISHED CONTRACTOR INSTALLED
CR	COMPUTER ROOM
EIA	ELECTRONIC INDUSTRIES ALLIANCE
EMI	ELECTROMAGNETIC INTERFERENCE
EMT	ELECTRICAL METALLIC TUBING
FF	FINISHED FLOOR
FO	FIBER OPTIC
FOC	FIBER OPTIC CABLE
GE	GROUNDING EQUALIZER
HH	HAND HOLE
ISP	INSIDE PLANT
JBOX	JUNCTION BOX
LAN	LOCAL AREA NETWORK
MDF	MAIN DISTRIBUTION FRAME
MH	MAINTENANCE HOLE
Mhz	MEGAHERTZ
MIC	MICROPHONE
MM	MULTIMODE
NEMA	NATIONAL ELECTRICAL MANUFACTURERS ASSOCIATION
NFPA	NATIONAL FIRE PROTECTION ASSOCIATION
NIC	NOT IN CONTRACT
OFCI	OWNER FURNISHED CONTRACTOR INSTALLED
OFOI	OWNER FURNISHED OWNER INSTALLED
OSP	OUTSIDE PLANT
P/C	PATCH CORD
P/P	PATCH PANEL
PB	PULL BOX
PC	PERSONAL COMPUTER
PR	PAIR
PVC	POLYVINYL CHLORIDE
RM	ROOM
RMU	RACK MOUNT UNIT
SM	SINGLEMODE
SPKR	SPEAKER
STR	STRAND
SWTH	SWITCH TAIL
TBB	TELECOMMUNICATION BONDING BACKBONE
TC	TELECOMMUNICATIONS CLOSET
TGB	TELECOMMUNICATIONS GROUNDING BUSBAR
TIA	TELECOMMUNICATIONS INDUSTRY ASSOCIATION
TMGB	TELECOMMUNICATIONS MAIN GROUNDING BUSBAR
TR	TELECOMMUNICATIONS ROOM, ALSO SEE TC
TYP	TYPICAL
UG	UNDERGROUND CONDUIT
UL	UNDERWRITERS LABORATORIES
um	MICRON OR MICROMETER
UPS	UNINTERRUPTIBLE POWER SUPPLY
UTP	UNSHIELDED TWISTED-PAIR
WA	WORK AREA
WM	WALL MOUNTED
WS	WORKSTATION



ISSUE DATE: 07.21.2025

REV DATE COMMENT

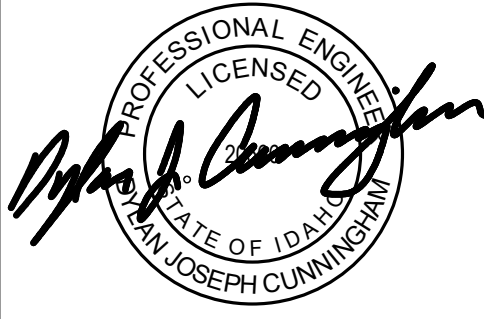

LEGENDS & ABBREVIATIONS - TELECOM

FOOD RESEARCH CENTER TI - PHASE 1 (BUILDING #: 005)

860 IDAHO AVE, MOSCOW, ID 83844

UNIVERSITY OF IDAHO

TITLE	PROJECT	CLIENT
JOB NO: 240004 CAPITAL PROJECT NO: CP220034		
T0-01		

1. FIELD VERIFY EXISTING CONDITIONS PRIOR TO COMMENCING WORK.



THESE DOCUMENTS HAVE BEEN PRODUCED AS AN INSTRUMENT OF SERVICE AND ARE INTENDED SOLELY FOR THE PURPOSE OF CONSTRUCTING, USING AND MAINTAINING THE PROJECT. KNIIT AS THE ARCHITECT OF RECORD FOR THE PROJECT RETAINS OWNERSHIP OF THESE DOCUMENTS.


ANY USE OF THESE DOCUMENTS OR USE OF THIS DESIGN, IDEAS OR CONCEPTS DESCRIBED HEREIN IN WHOLE OR PART BY ANY MEANS WHATSOEVER IS STRICTLY PROHIBITED EXCEPT BY WRITTEN CONSENT OF KNIIT.

REPRODUCTION OF THIS DOCUMENTS IS STRICTLY PROHIBITED EXCEPT BY WRITTEN CONSENT OF KNIIT.



ISSUE DATE: 07.21.2025

REV	DATE	COMMENT
A	7/21/2025	Owner Revision

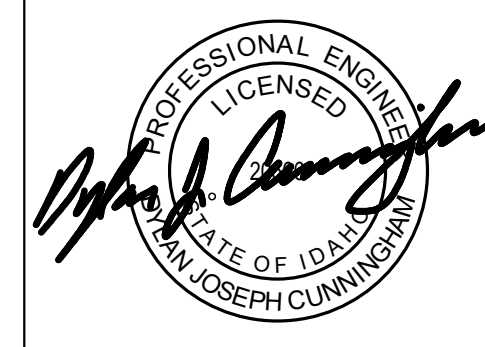

DEMO FLOOR PLAN - TELECOM

FOOD RESEARCH CENTER TI - PHASE 1 (BUILDING #: 005)

8660 IDAHO AVE. MOSCOW, ID 83844

UNIVERSITY OF IDAHO

TITLE	PROJECT	CLIENT
<p>JOB NO: 240004</p> <p>CAPITAL PROJECT NO: CP220034</p>		

TD2-11



LEVEL 2 - DEMOLITION PLAN - TELECOM

$$\frac{1}{4}'' = 1'-0''$$



THESE DOCUMENTS HAVE BEEN PRODUCED AS AN INSTRUMENT OF SERVICE AND ARE INTENDED SOLELY FOR THE PURPOSE OF ASSISTING IN THE MAINTENANCE OF THE PROJECT. KNIT AS THE PROJECT ARCHITECT OF RECORD FOR THE PROJECT RETAINS OWNERSHIP OF THESE DOCUMENTS.


USE OF THESE DOCUMENTS OR USE OF THIS DESIGN, IDEAS OR CONCEPTS DESCRIBED HEREIN IN WHOLE OR PART BY ANY MEANS WHATSOEVER IS STRICTLY PROHIBITED EXCEPT BY WRITTEN CONSENT OF KNIT.

PRODUCTION OF THIS DOCUMENTS IS STRICTLY PROHIBITED EXCEPT BY WRITTEN CONSENT OF KNIT.



ISSUE DATE: 07.21.2025

REV	DATE	COMMENT
-----	------	---------

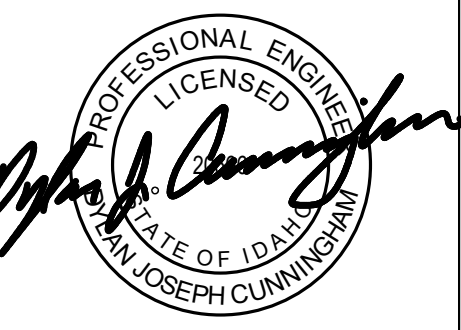

FLOOR PLAN - TELECOM

FOOD RESEARCH CENTER TI - PHASE 1 (BUILDING #: 005)

860 IDAHO AVE, MOSCOW, ID 83844


UNIVERSITY OF IDAHO

TITLE	PROJECT	CLIENT
-------	---------	--------

JOB NO: **240004**
CAPITAL PROJECT NO: **CP220034**


T2-11

1. FIELD VERIFY EXISTING CONDITIONS PRIOR TO COMMENCING WORK.
2. TELECOMMUNICATIONS PATHWAY SHALL ROUTE FROM OUTLET BOX TO ROOM 200A, THEN TRANSITION TO 4" CONDUIT FROM ROOM 200A TO EXISTING TELECOM ROOM 102. STUB CONDUIT INTO ROOM 200A AND UTILIZE J-HOOKS TO CONSOLIDATE CABLING PRIOR TO ROUTING THROUGH 4" CONDUIT.

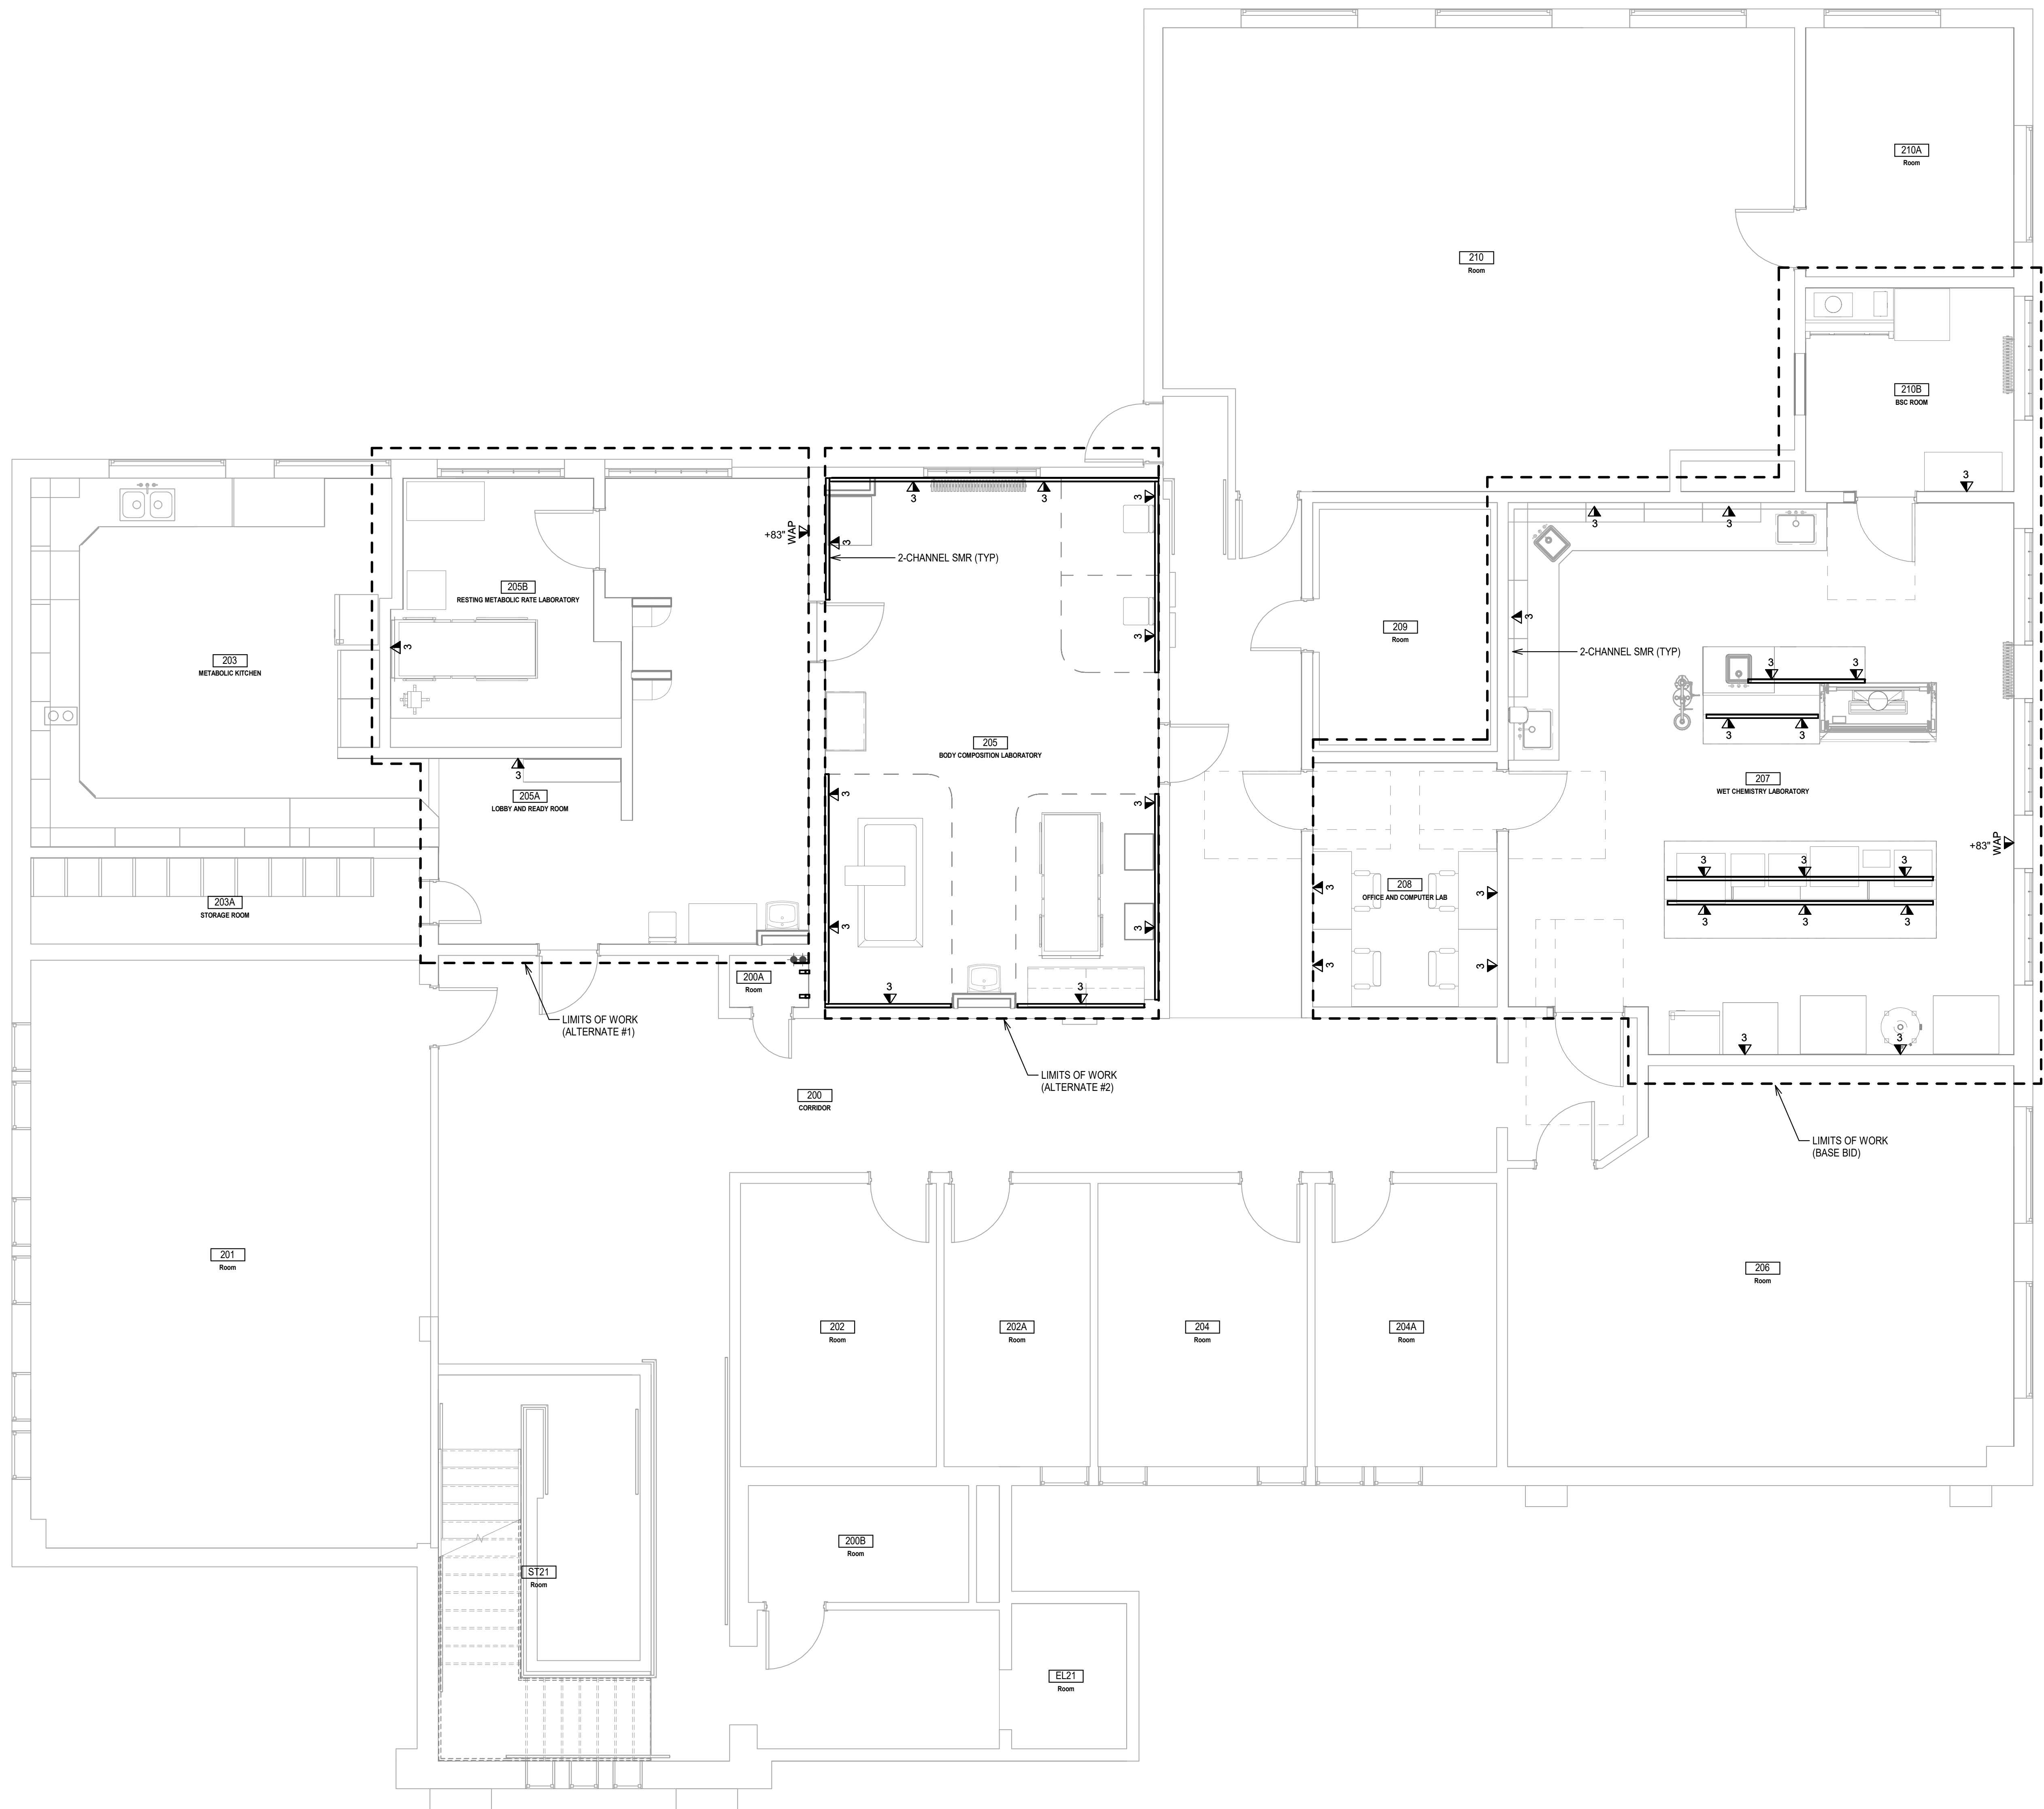

LEVEL 2 - TELECOM


1/4" = 1'-0"

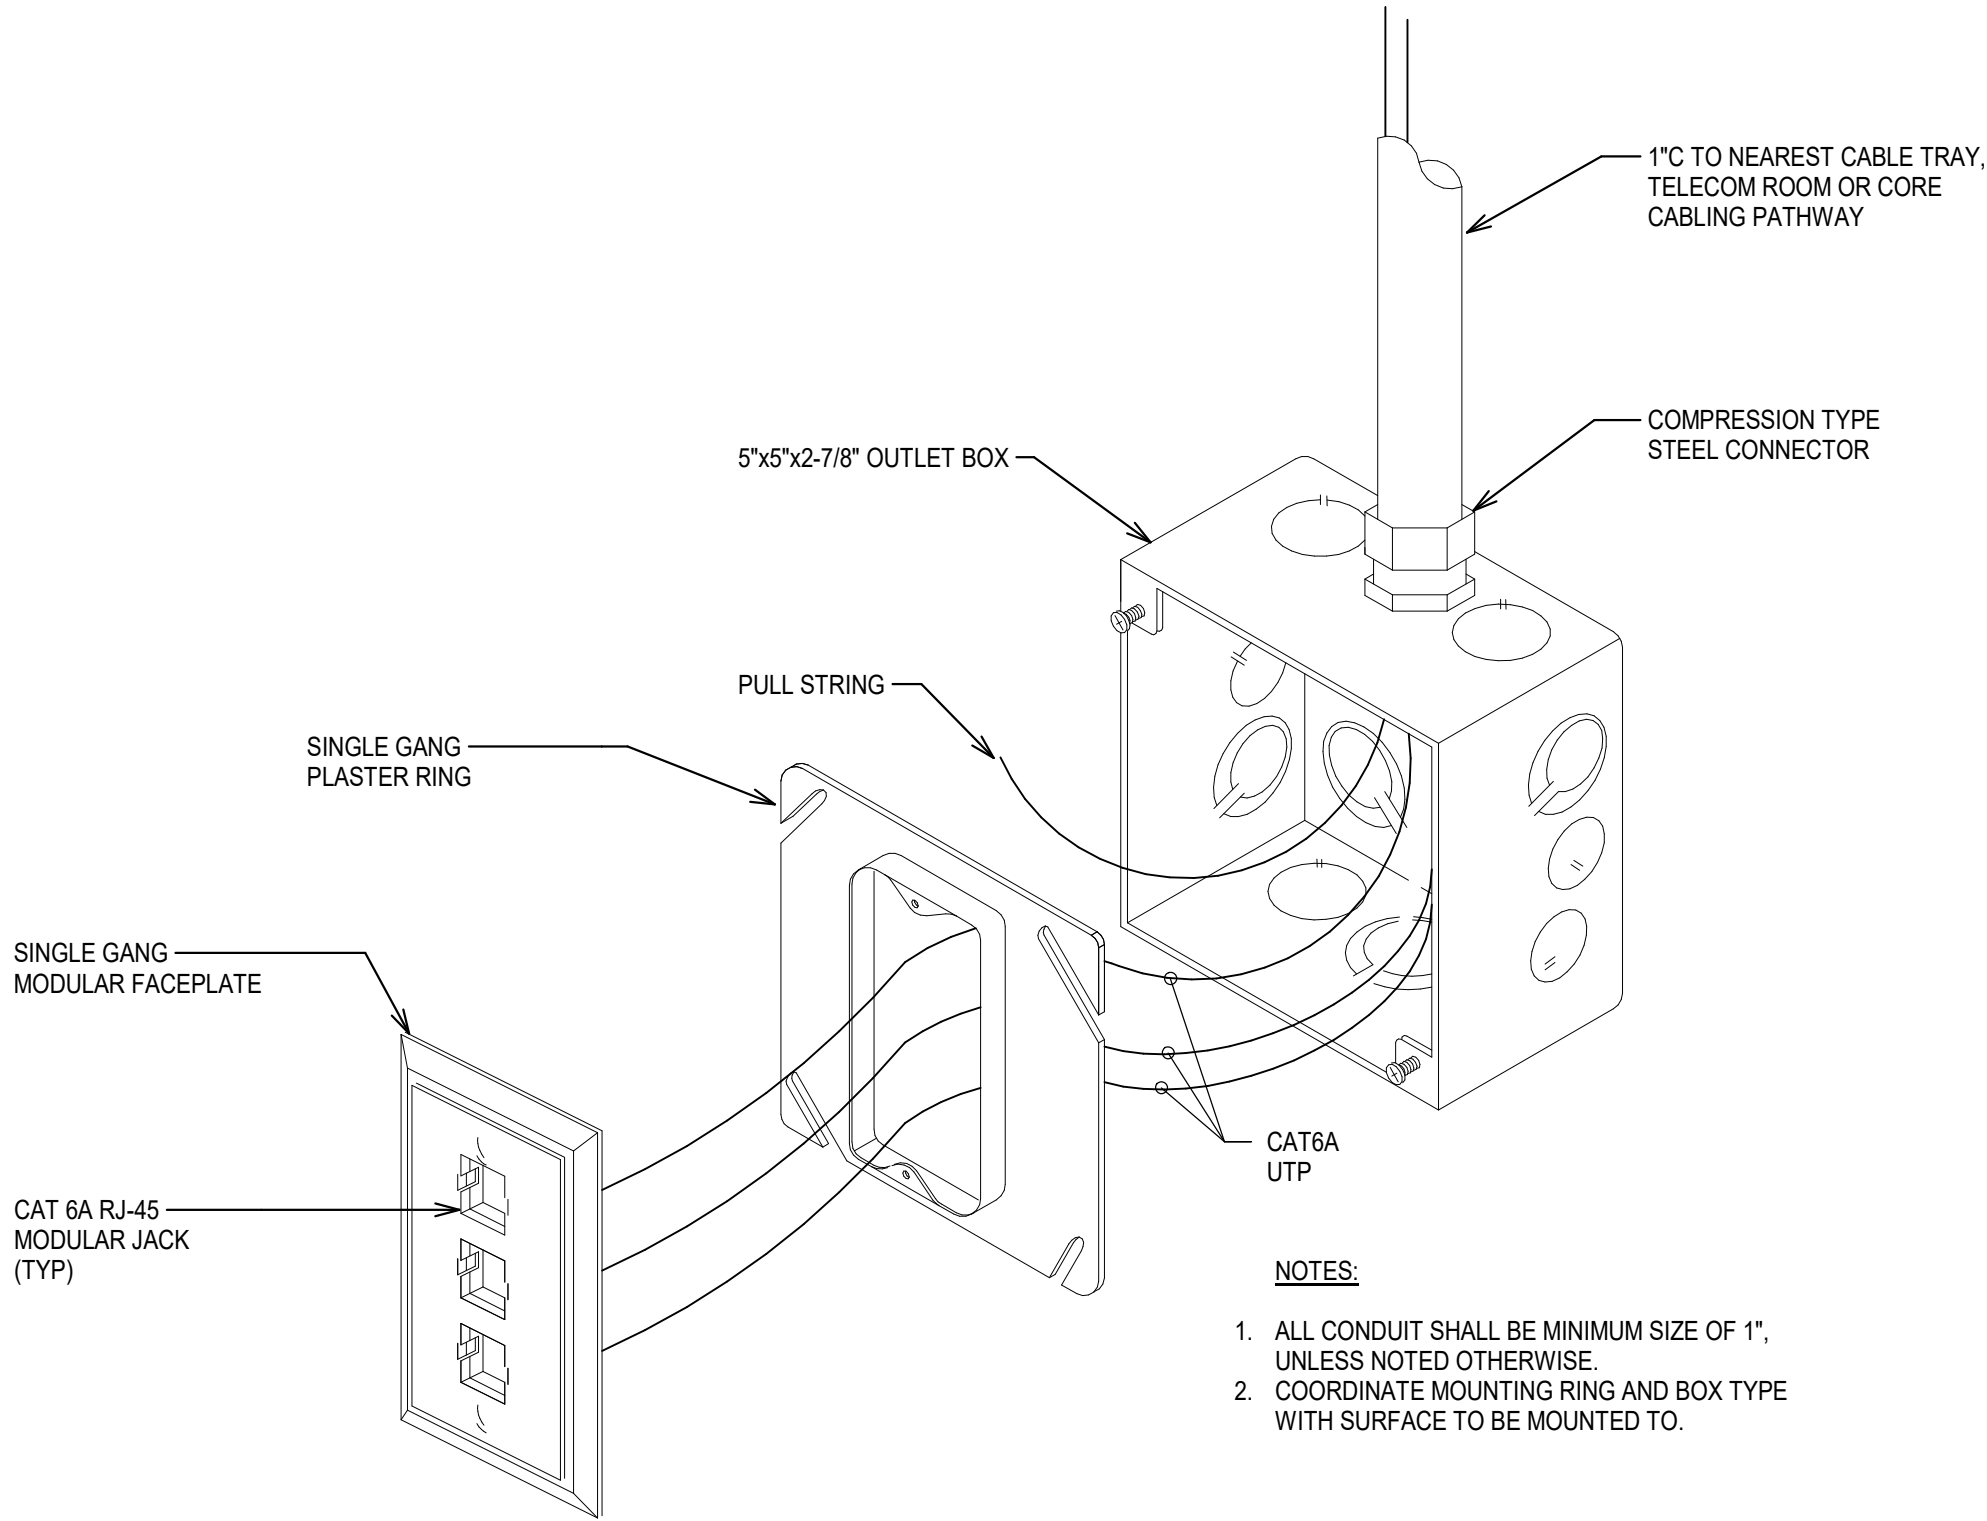

1 TYPICAL 3-PORT OUTLET DETAIL
N.T.S.

ISSUE DATE: **07.21.2025**

REV	DATE	COMMENT
-----	------	---------

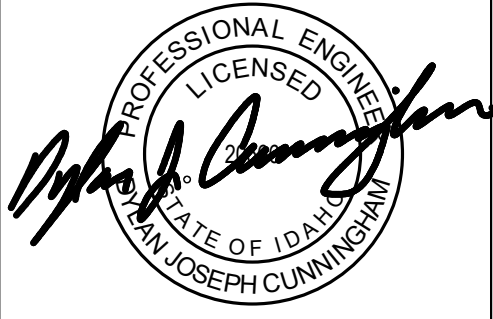

PROFESSIONAL ENGINEER
LICENSED
STATE OF IDAHO
JOSEPH CUNNIFF

DETAILS - TELECOM	FOOD RESEARCH CENTER TI - PHASE 1 (BUILDING #: 005)
	860 IDAHO AVE, MOSCOW, ID 83844
	UNIVERSITY OF IDAHO

TITLE	PROJECT	CLIENT
	JOB NO: 240004 CAPITAL PROJECT NO: CP220034	

T5-01




THESE DOCUMENTS HAVE BEEN PRODUCED AS AN INSTRUMENT OF SERVICE AND ARE INTENDED SOLELY FOR THE PURPOSE OF CONSTRUCTING, USING AND MAINTAINING THE PROJECT. KNT AS THE ARCHITECT OF RECORD FOR THE PROJECT RETAINS OWNERSHIP OF THESE DOCUMENTS.

ANY USE OF THESE DOCUMENTS OR USE OF THIS DESIGN, IDEAS OR CONCEPTS DESCRIBED HEREIN IN WHOLE OR PART BY ANY MEANS WHATSOEVER IS STRICTLY PROHIBITED EXCEPT BY WRITTEN CONSENT OF KNT.

REPRODUCTION OF THIS DOCUMENTS IS STRICTLY PROHIBITED EXCEPT BY WRITTEN CONSENT OF KNT.



REV	DATE	COMMENT
A	7/21/2025	Owner Revisions

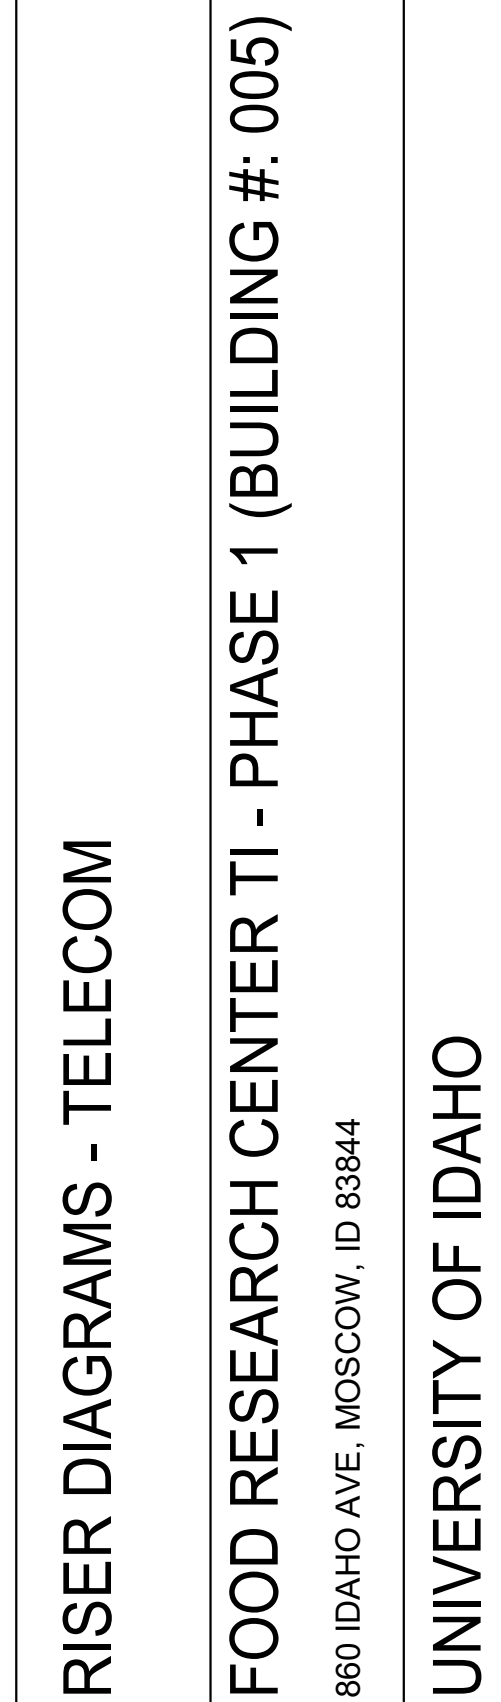

TITLE	PROJECT	CLIENT
<p>JOB NO: 240004</p> <p>CAPITAL PROJECT NO: CP220034</p>		

T8-01

